COUNTY SURVEYORS FILE DATA
DO NOT REMOVE FROM OFFICE

M47 - 56

SURVEY IN SECTIONS 1 and 12, T. 30S., R. 6 W.
and SECTION 6, T. 30S., R. 5 W., W.M.

Surveyed for — JIM LEWIS

Surveyed by — DON E. GARRETT

Scale — 1" = 100'

February 1973

• — Denotes 5/8" Iron Rod Set

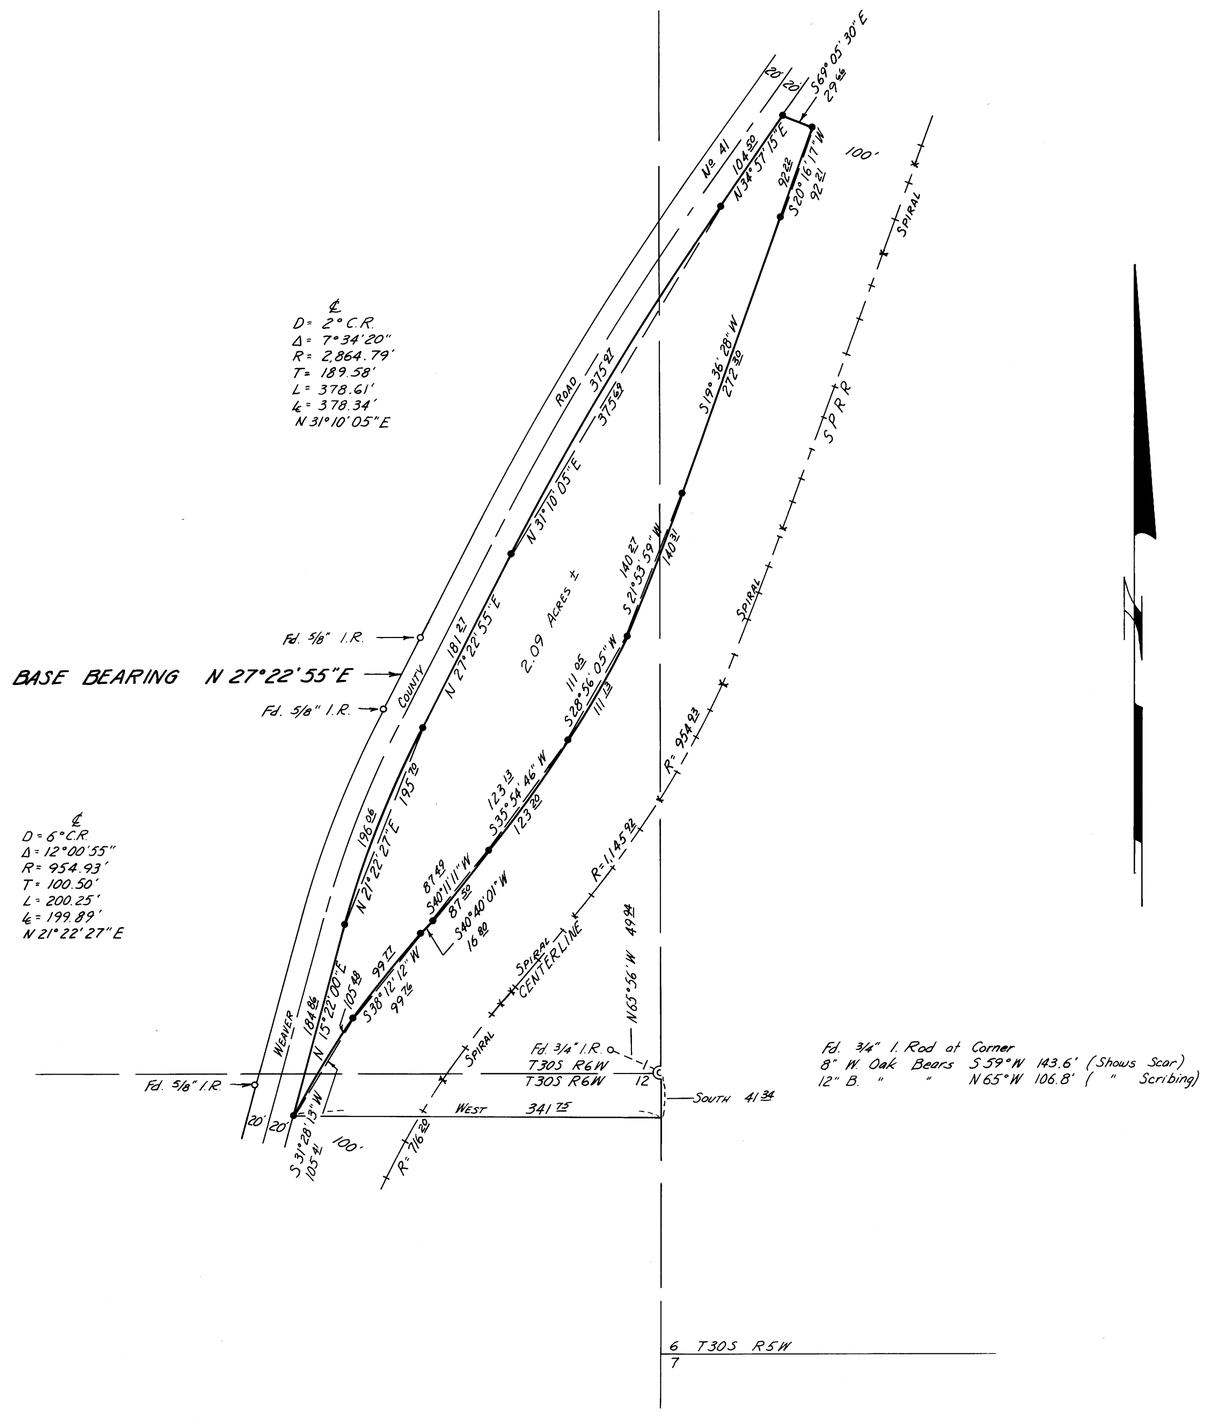

Fd. 3/4" I. Rod at Corner
8" W. Oak Bears S 59° W 143.6' (Shows Scar)
12" B. " " N 65° W 106.8' (" Scribing)

6 T30S R5W
7

REGISTERED PROFESSIONAL LAND SURVEYOR
Don E. Garrett
OREGON JULY 14, 1971 DON E. GARRETT 346

M47 - 56