MAP FILE M47-67

SURVEY TO SET PROPERTY CORNERS
SITUATED IN SEC. 11, T. 27 S., R. 6 W., W.M.
FOR : MR. GEORGE KUHN
BY: BAUGHMAN SURVEYING SERVICE

FEBRUARY 1973 SCALE 1" = 50'

COUNTY SURVEYORS FILE DATA
DO NOT REMOVE FROM OFFICE

REGISTERED PROFESSIONAL LAND SURVEYOR
OREGON
MAY 13, 1960
EUGENE A. BLOOM
492

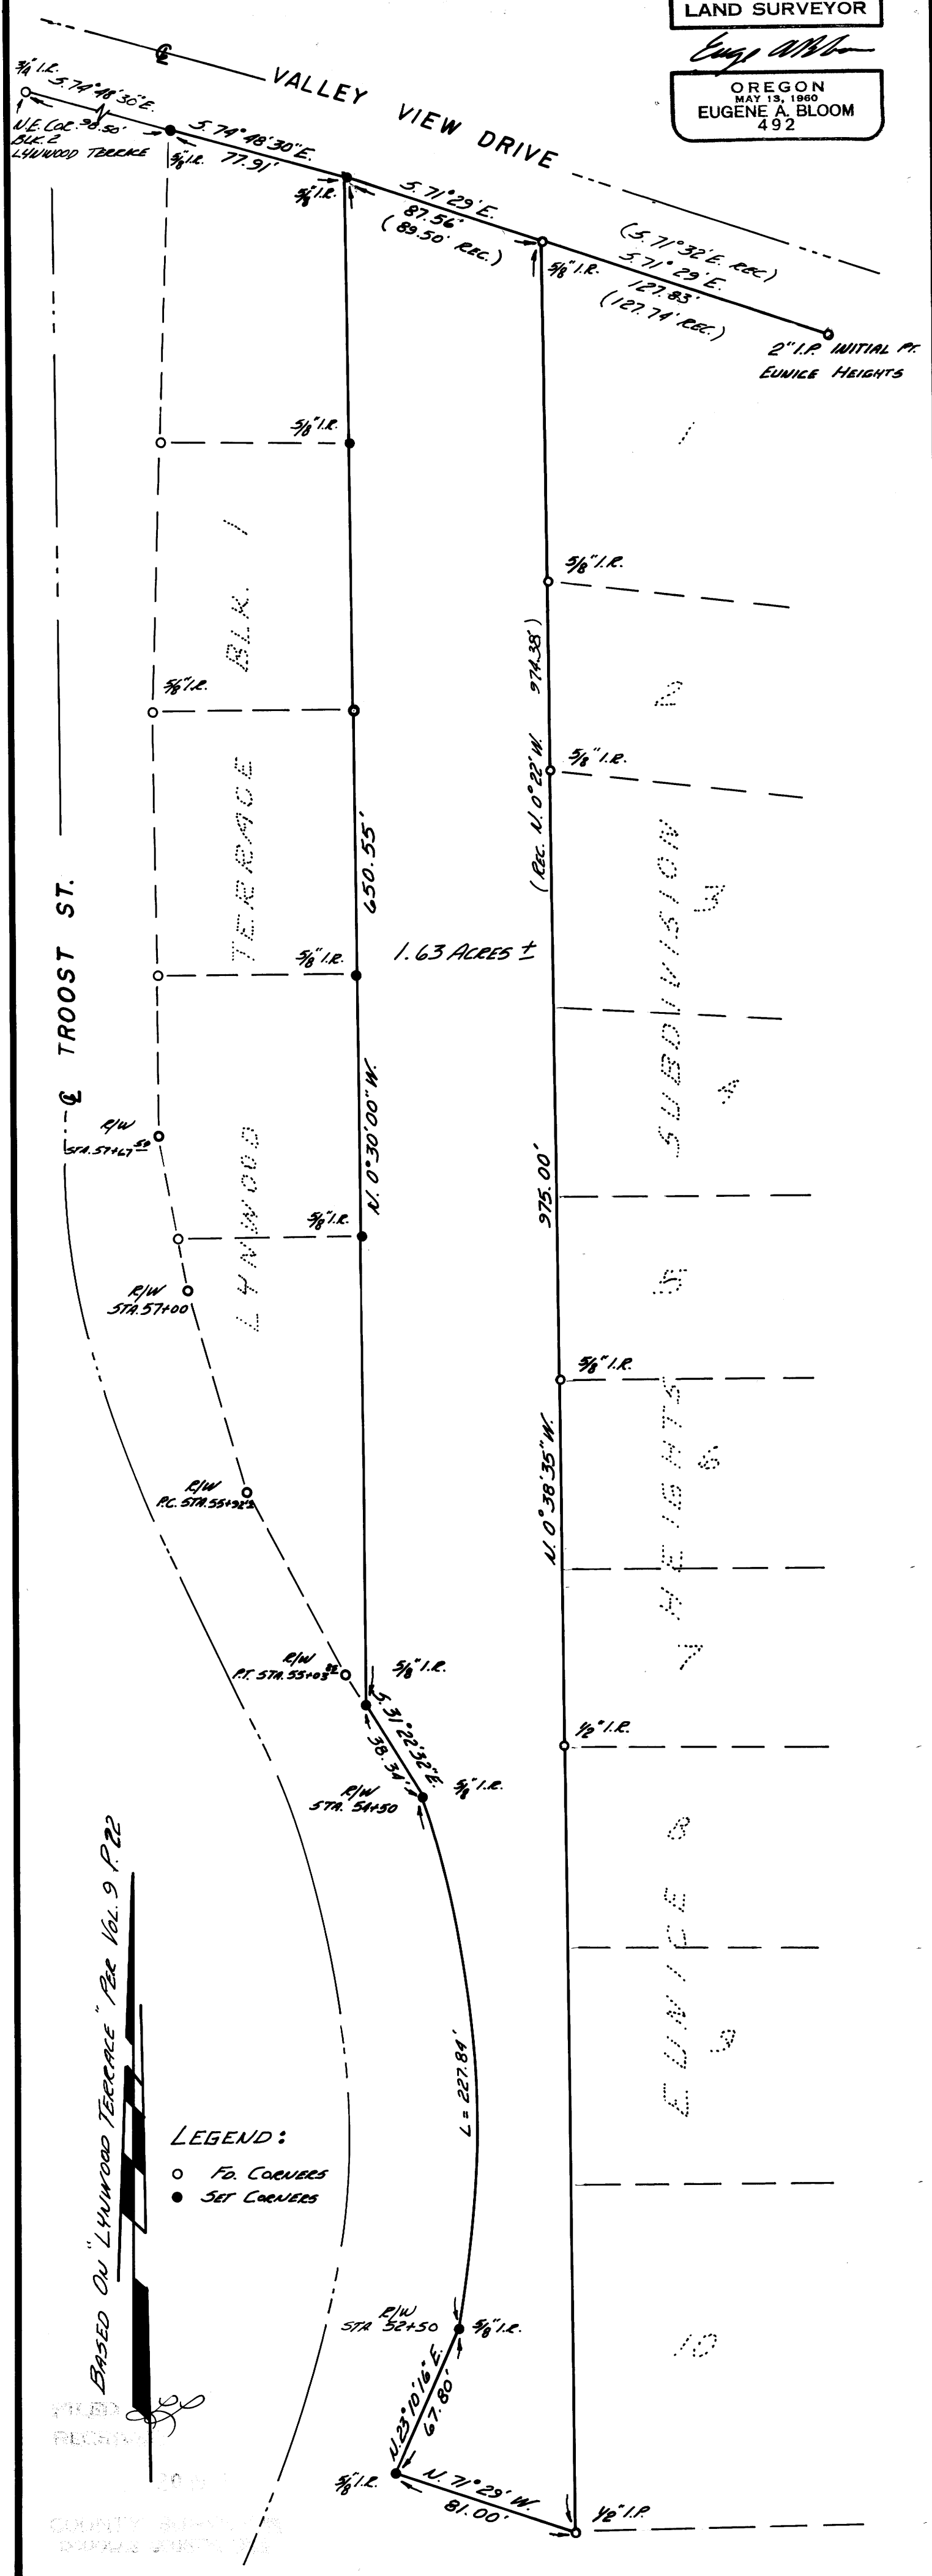

MAP FILE M47-67