M 48 - 26

COUNTY SURVEYORS FILE DATA
DO NOT REMOVE FROM OFFICE

SURVEY FOR K. C. HARTLERODE

DIVISION OF LOT 6, BLOCK 4
ROSEBURG-HOME-ORCHARD TRACTS
IN SEC. 18 & 19, T26S, R6W, W. M.
DOUGLAS COUNTY, OREGON

FILED
RECEIVED
APR 2 3 1973
COUNTY SURVEYOR
DOUGLAS COUNTY, ORE.

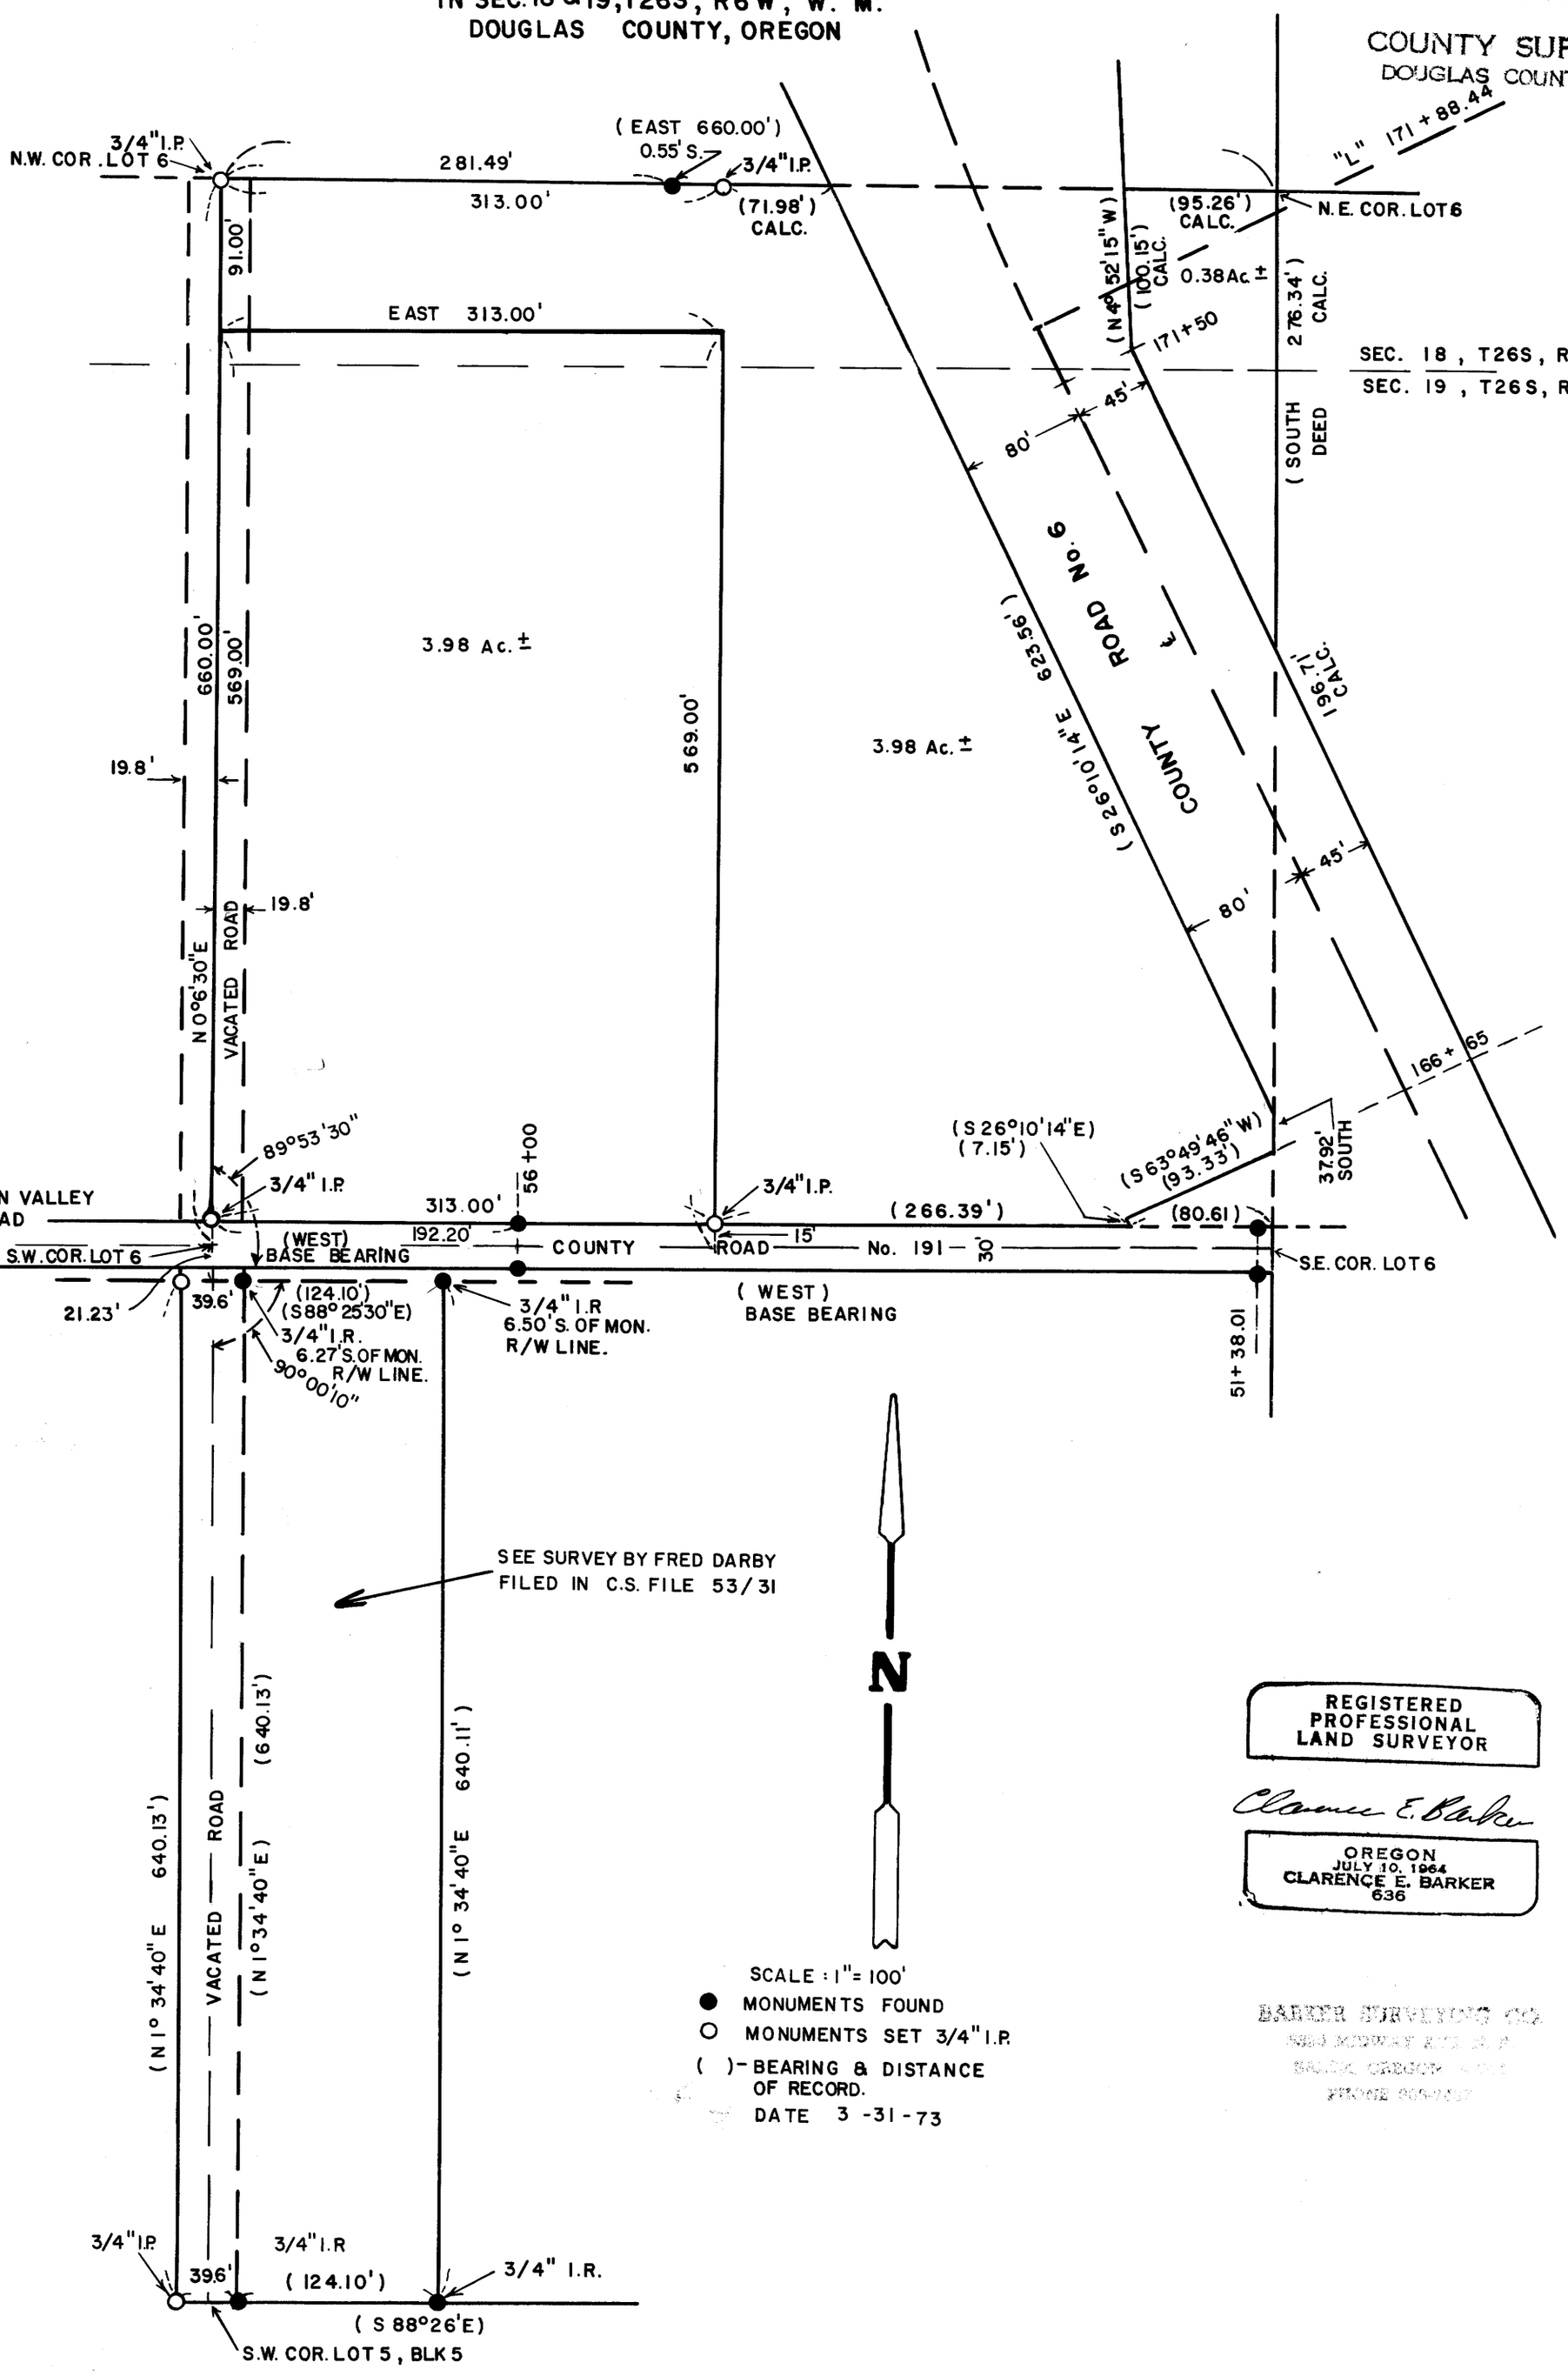

SCALE : 1" = 100'
● MONUMENTS FOUND
○ MONUMENTS SET 3/4" I.P.
( ) - BEARING & DISTANCE OF RECORD.
DATE 3 -31 - 73

REGISTERED
PROFESSIONAL
LAND SURVEYOR

Clarence E. Barker

OREGON
JULY 10, 1964
CLARENCE E. BARKER
636

BARKER SURVEYING CO.
[illegible]

MAP M 48 - 26