COUNTY SURVEYORS FILE DATA
DO NOT REMOVE FROM OFFICE

FILED
RECEIVED 2/4
MAY 18 1973
COUNTY SURVEYOR
DOUGLAS COUNTY, ORE.

M48-47

SURVEY IN SECTION 26, T30S, R3W, W.M., DOUGLAS CO., OREGON

Surveyed for Milo Academy Inc. by Victor M. McLind

May 1973

Scale: 1" = 200'

o — Indicates set 5/8" x 30" Iron Rod unless otherwise noted

Bearings are based on Solar Observation taken May 17, 1973

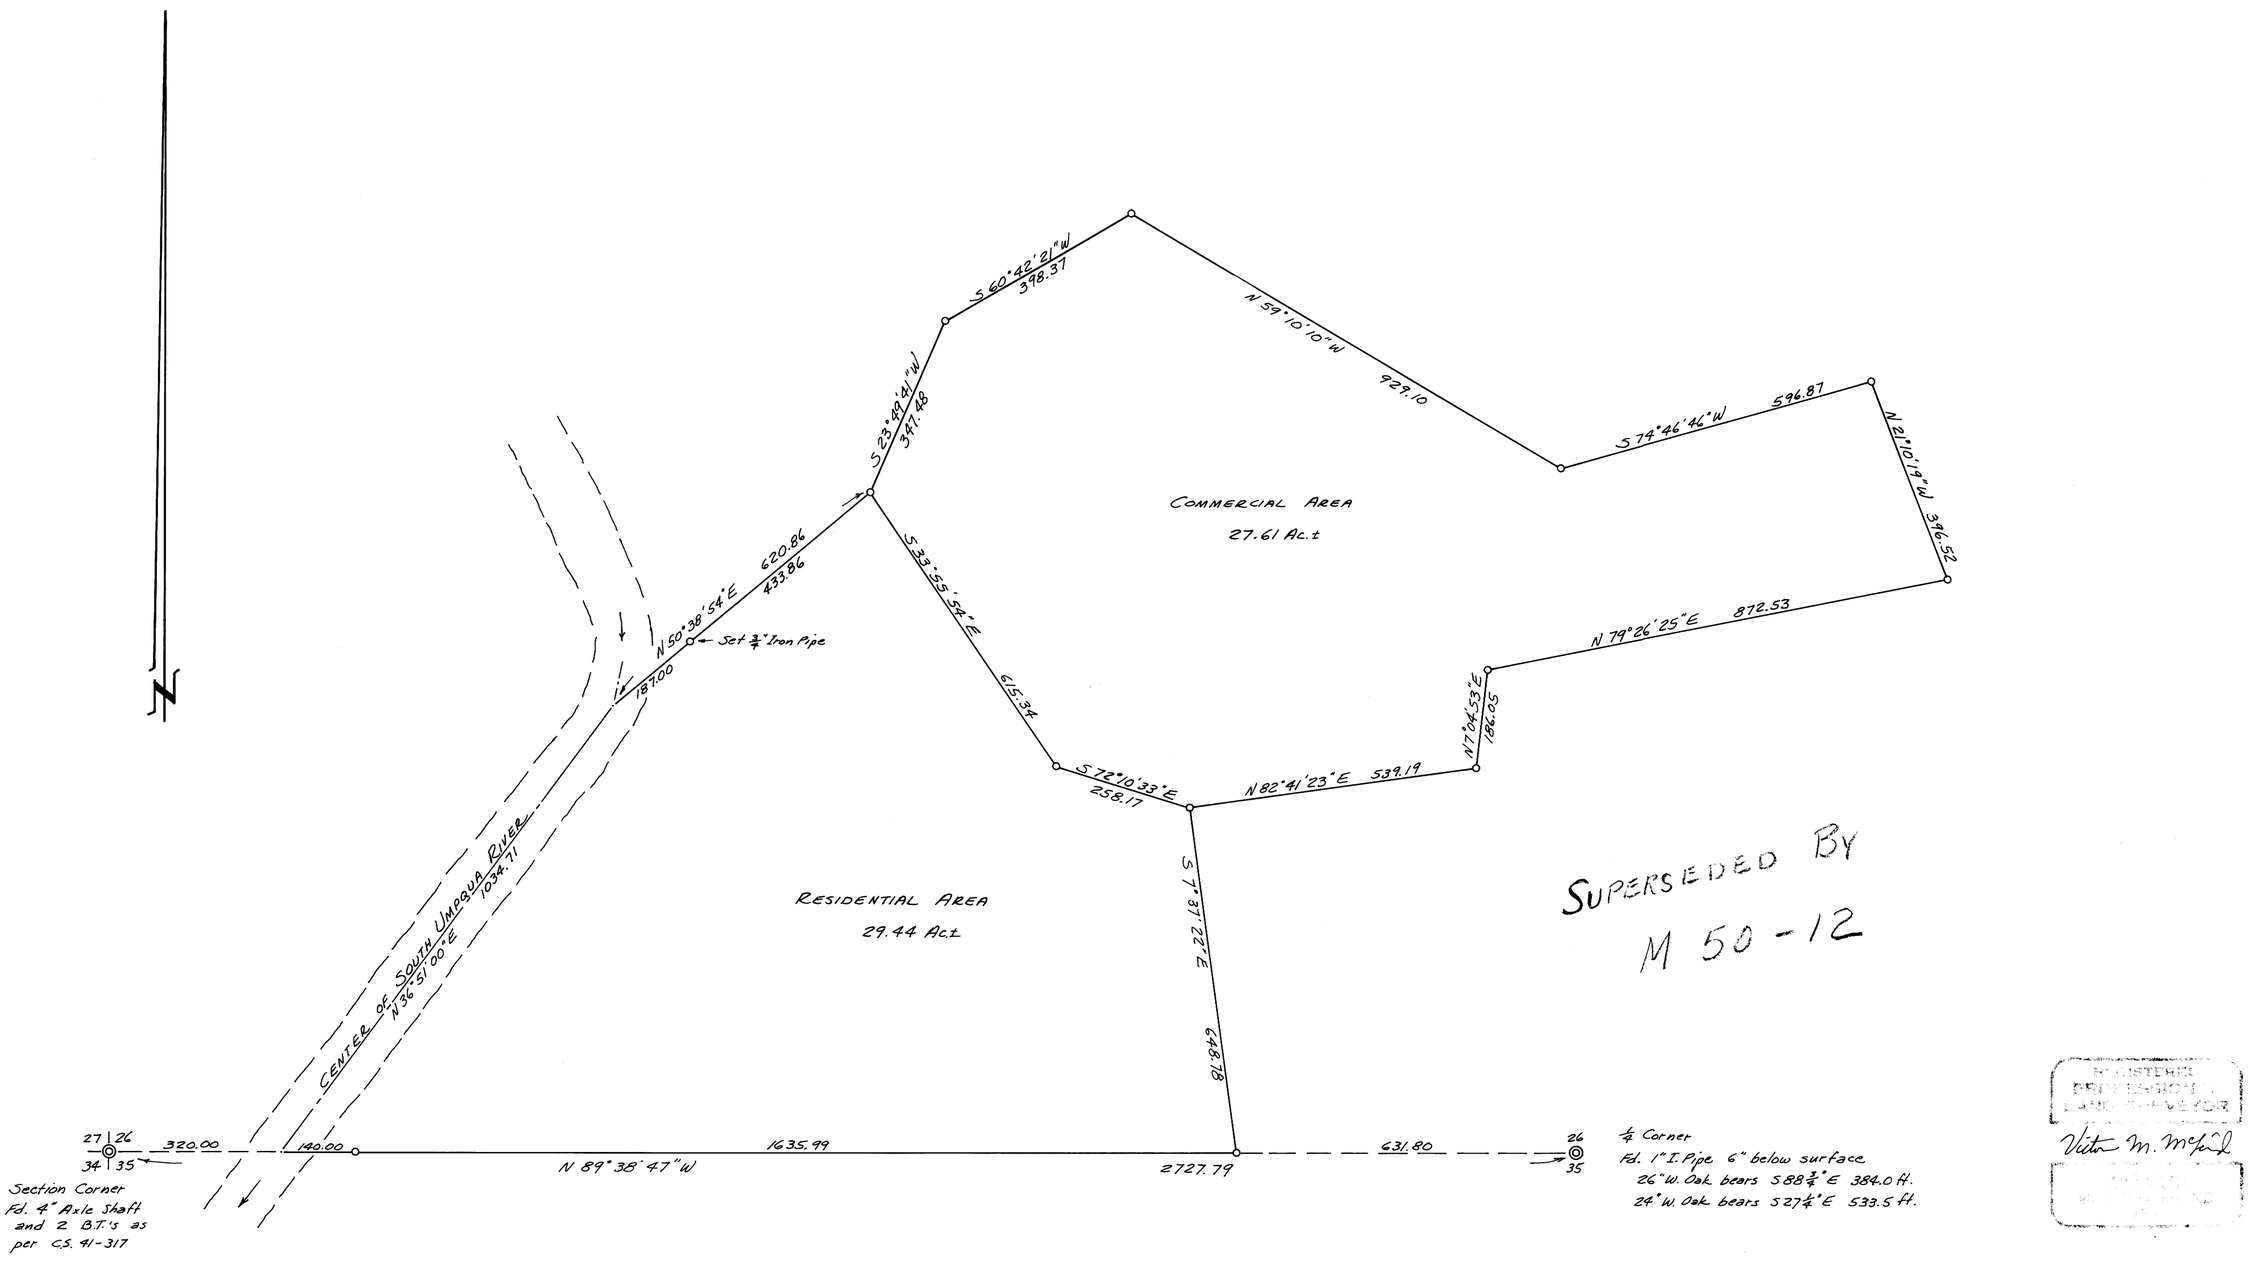

SUPERSEDED BY
M 50-12

REGISTERED
PROFESSIONAL
LAND SURVEYOR
Victor M. McLind
OREGON

MAP FILE M48-47