MAP FILE M48-63

SURVEY TO SET PROPERTY CORNERS
IN LOT 38, EDENBOWER ORCHARD TRACTS
SITUATED IN SECTION 12, T27S., R6W., W.M.

FOR: ABBY'S PIZZA INN

BY: BAUGHMAN SURVEYING SERVICE

MAY 1973

SCALE 1" = 20'

COUNTY SURVEYORS FILE DATA
DO NOT REMOVE FROM OFFICE

FILED
RECEIVED
JUN 1 1973
COUNTY SURVEYOR
DOUGLAS COUNTY, ORE.

REGISTERED PROFESSIONAL LAND SURVEYOR
Eugene A. Bloom
OREGON MAY 15, 1960
EUGENE A. BLOOM
492

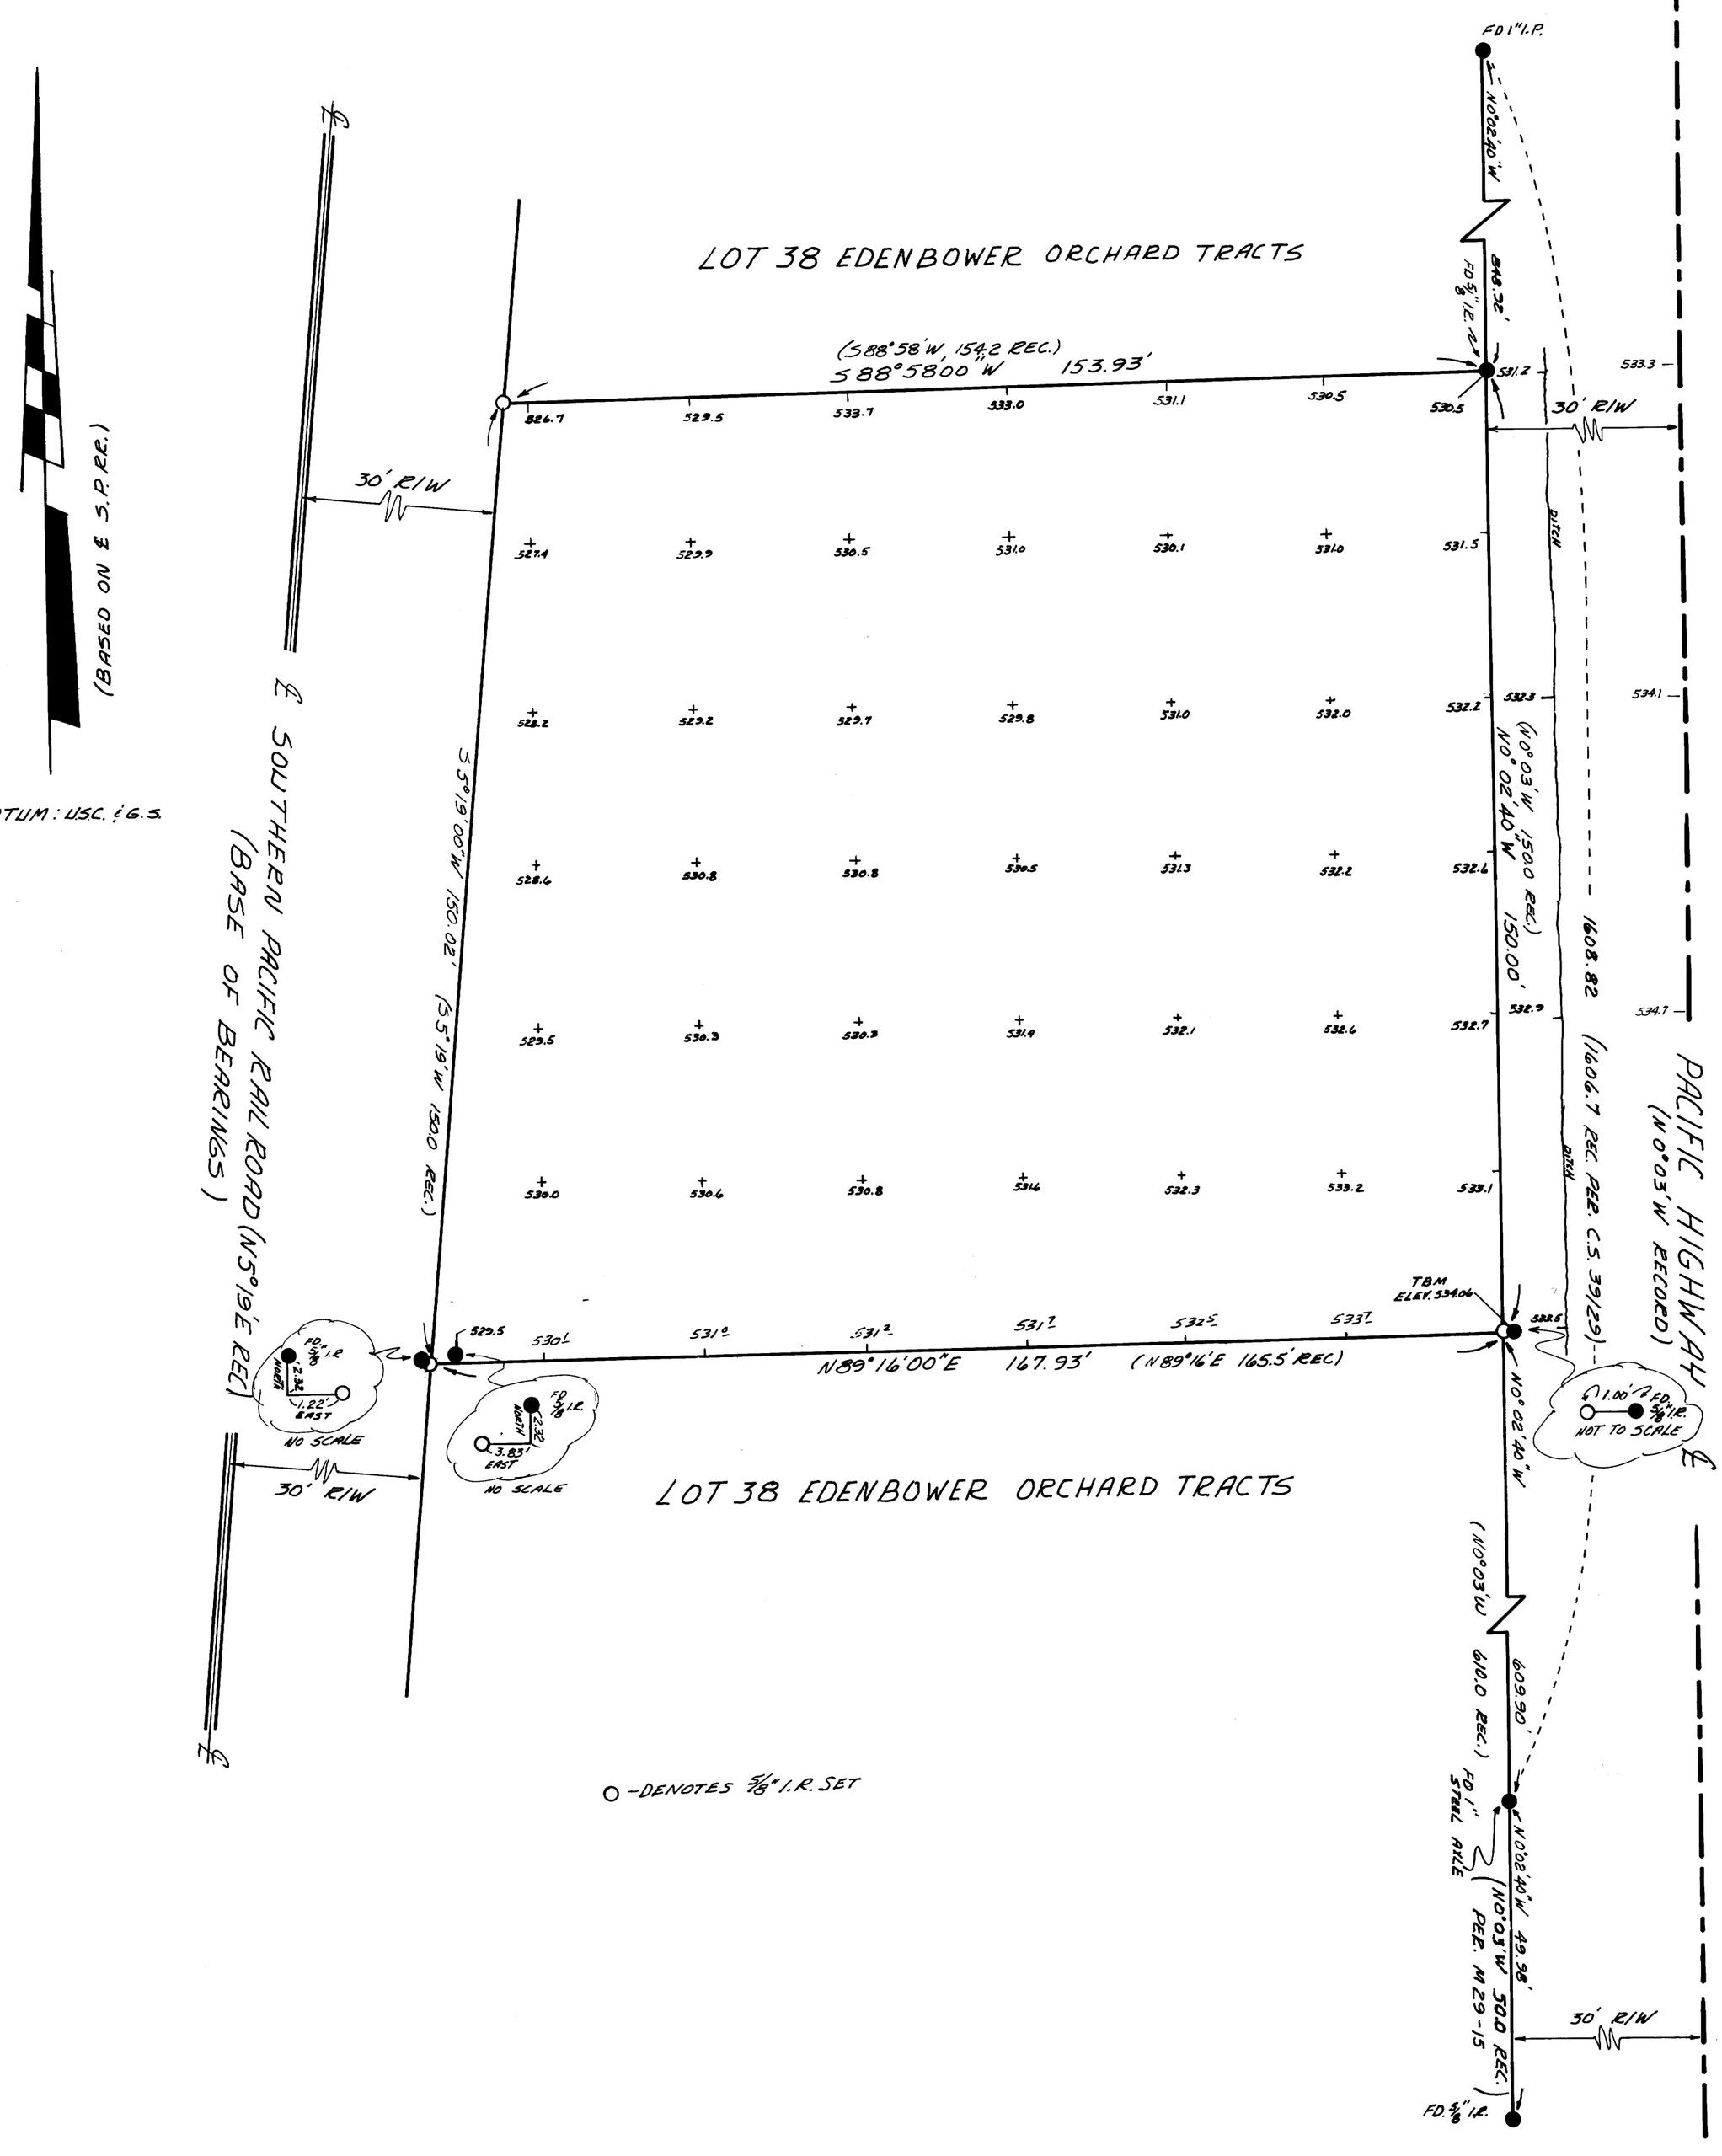

P MAP FILE M48-63