# SURVEY IN THE CITY OF RIDDLE
## SEC. 24, T30S, R6W, WM.

Surveyed for Wayne Snyder by Victor M. McLind

June, 1973 Scale: 1" = 50'

COUNTY SURVEYORS FILE DATA
DO NOT REMOVE FROM OFFICE

FILED
RECEIVED
JUN 5 1973
COUNTY SURVEYOR
DOUGLAS COUNTY, ORE.

Bearings Based on the N.E. Line of "E" Street.

o — Indicates Set 5/8" x 30" Iron Rod unless otherwise noted.

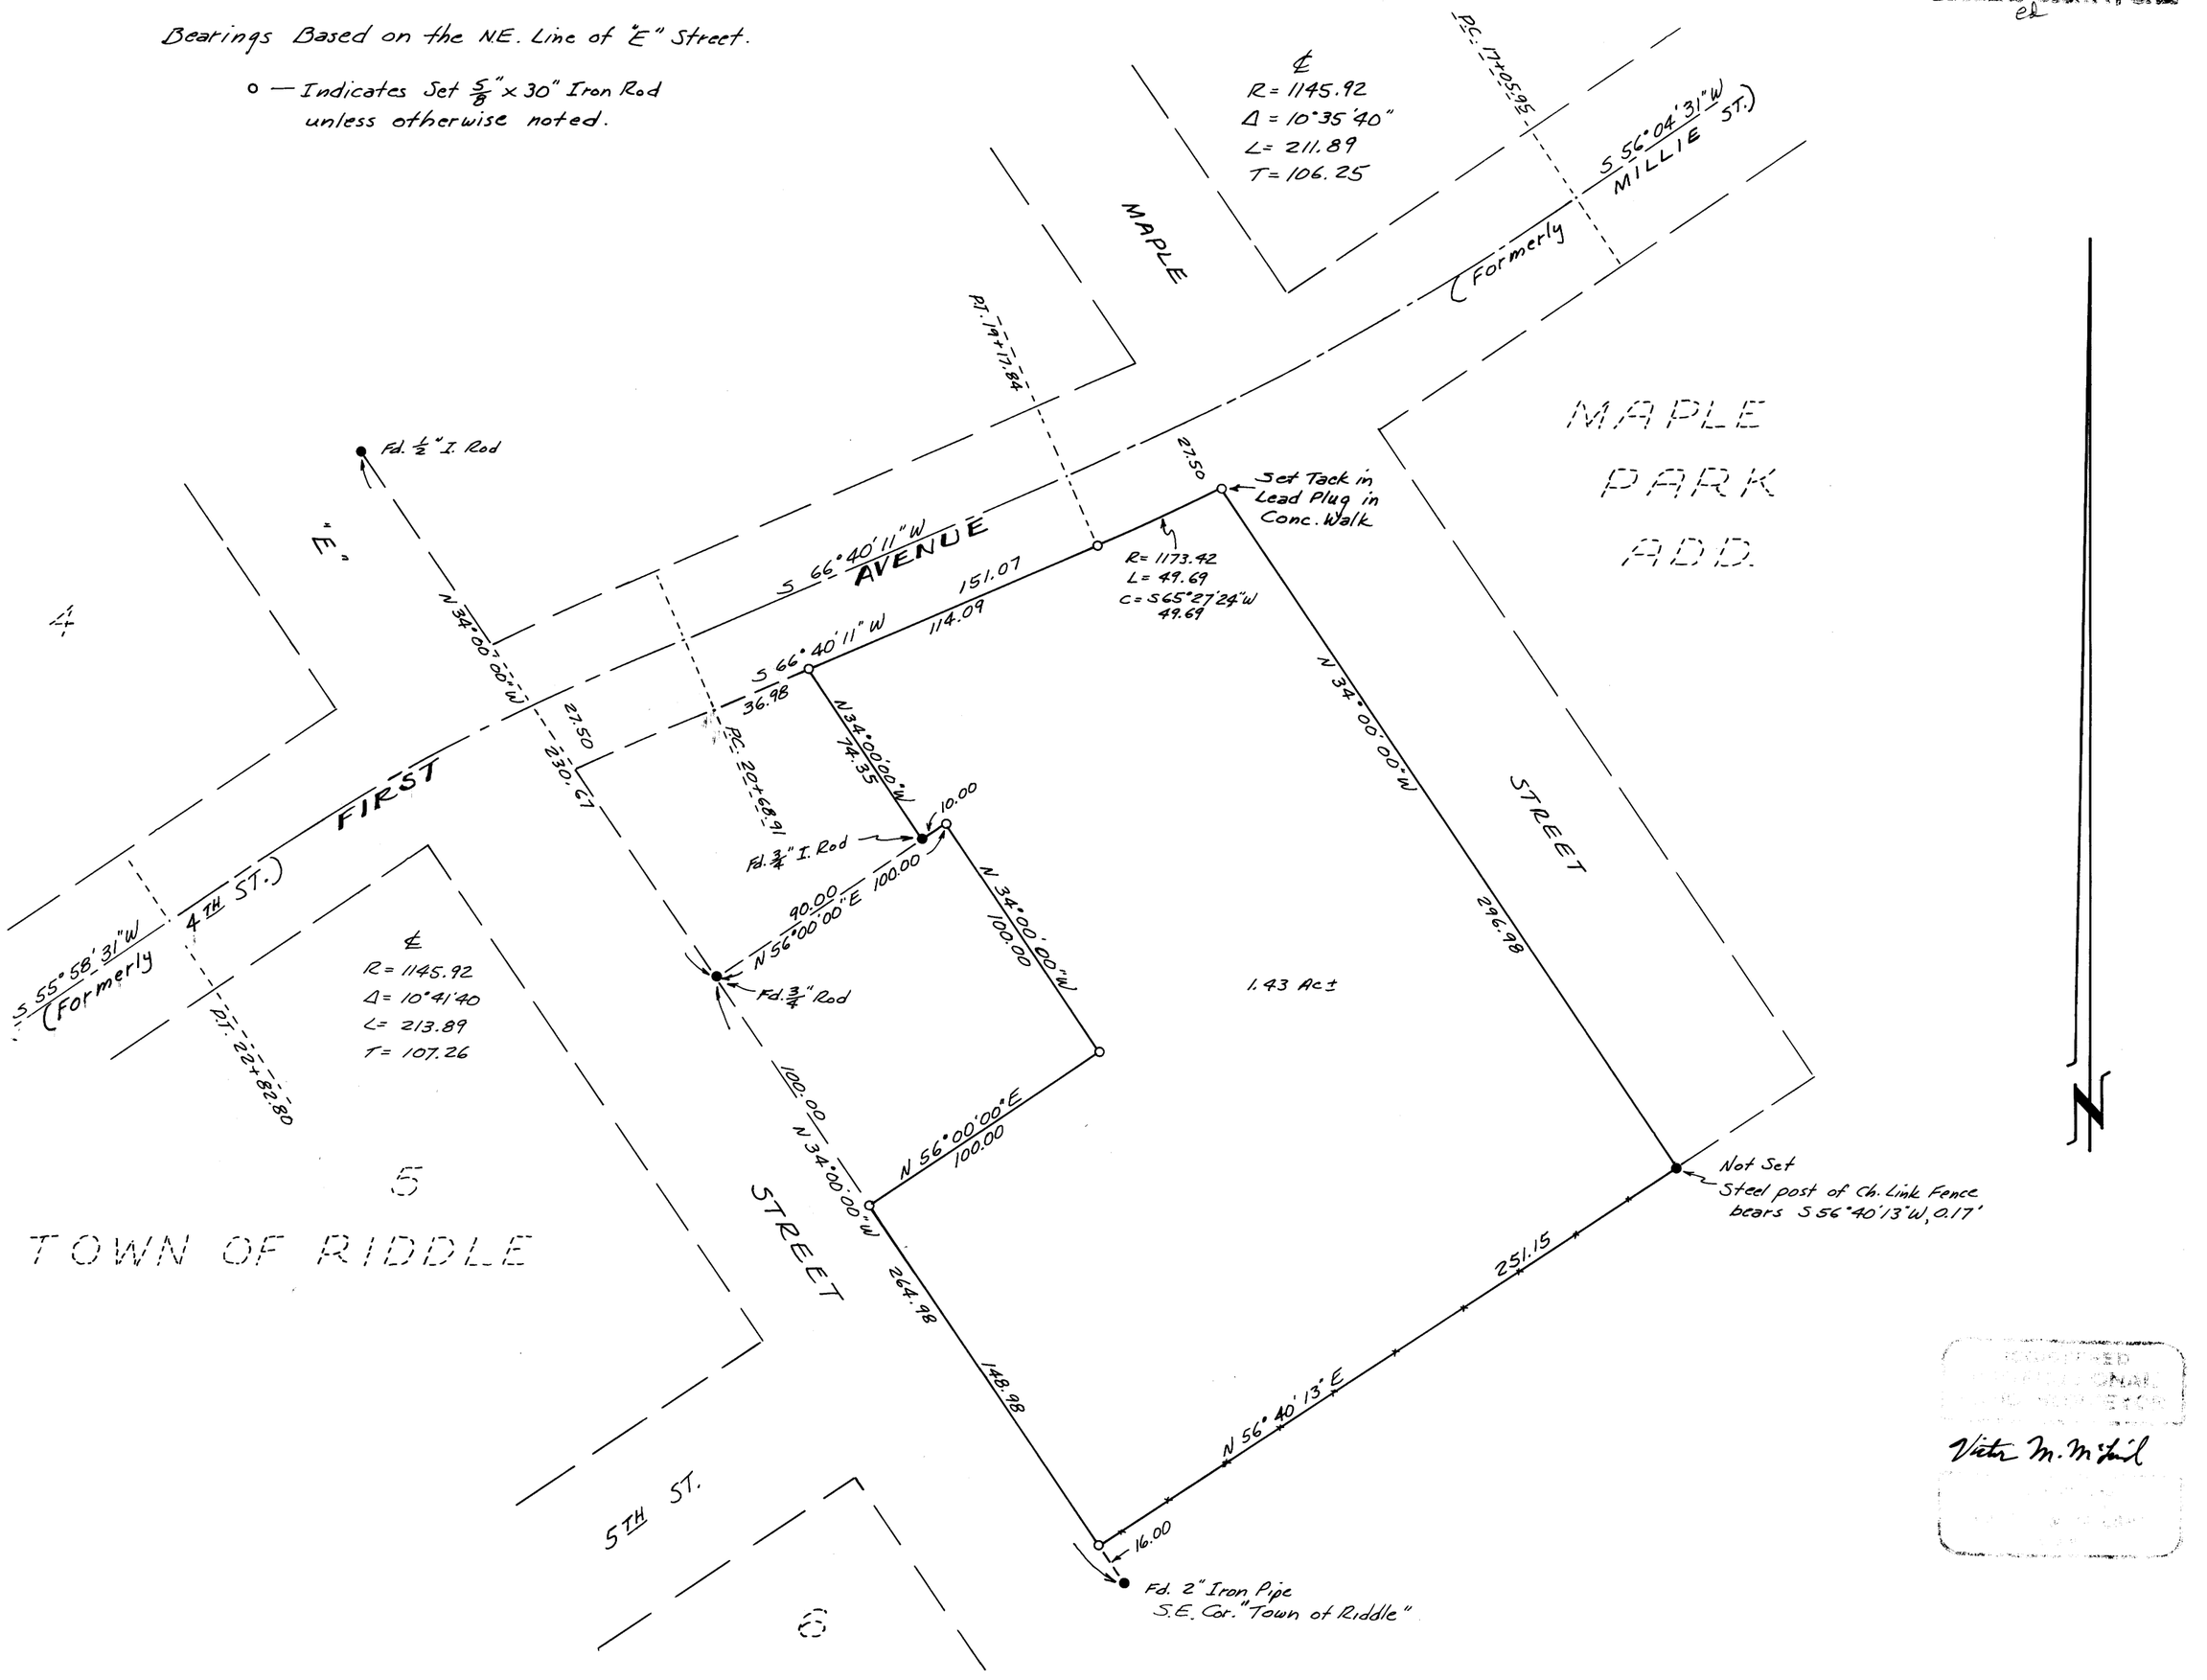


REGISTERED PROFESSIONAL LAND SURVEYOR
Victor M. McLind

MAP FILE M48 - 67

MAP FILE M48 - 67