FILED
RECEIVED
JUN 18 1973
COUNTY SURVEYOR
DOUGLAS COUNTY, ORE.

MAP FILE M48 - 75

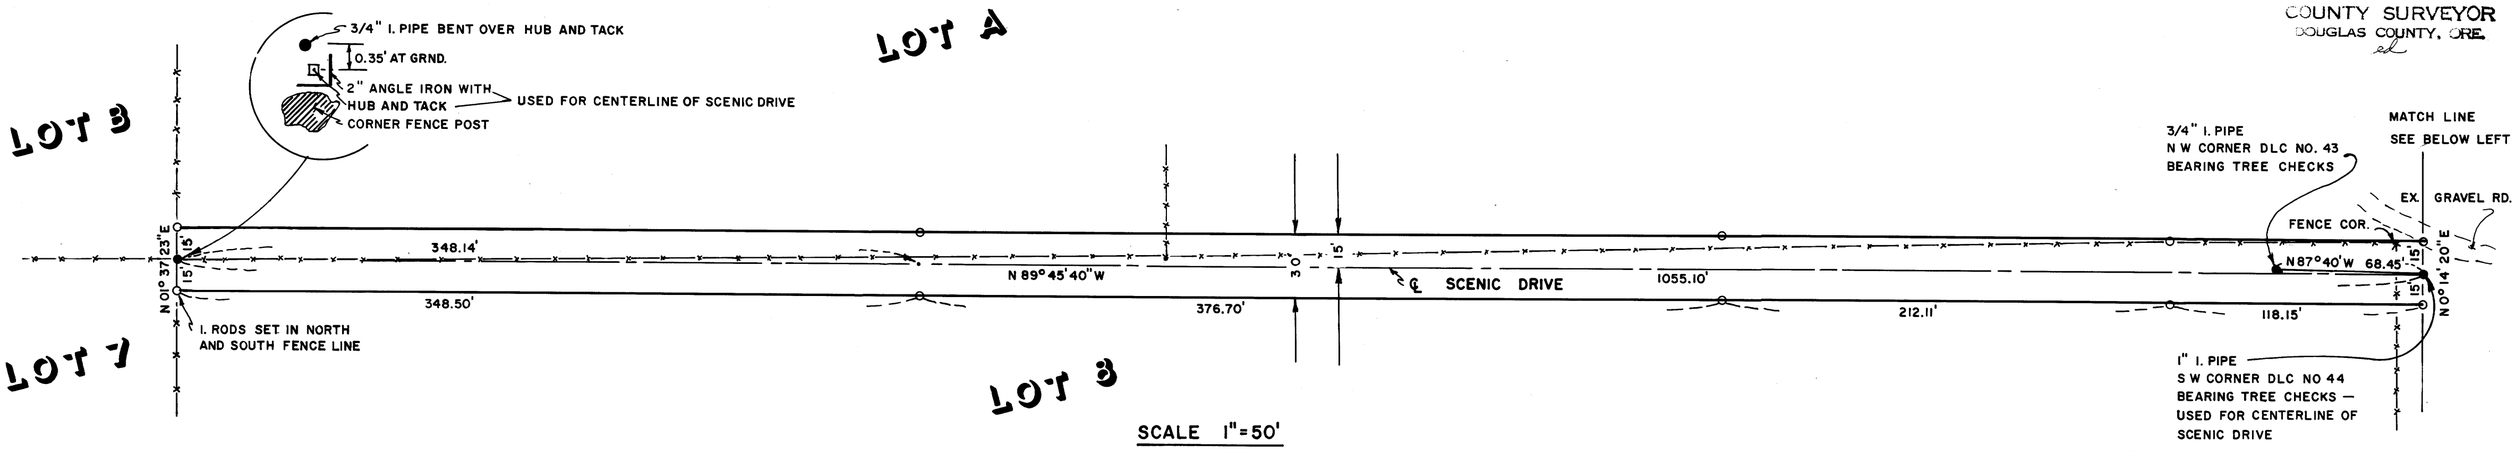

SCALE 1" = 50'

NOTE —

PRIOR TO CONSTRUCTING ROAD, CONTACT COUNTY SURVEYOR SO THAT DLC CORNERS MAY BE REFERENCED

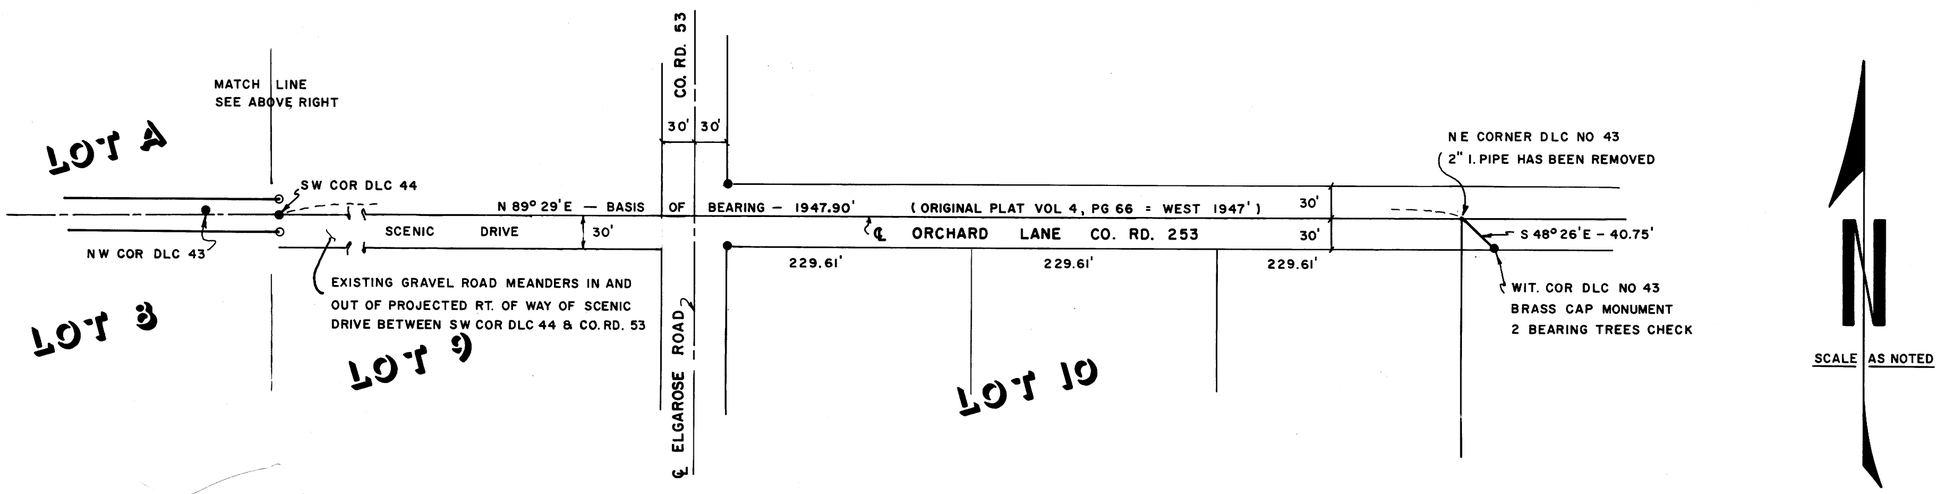

SCALE 1" = 100'

LEGEND

- ● — MONUMENT FOUND AS SHOWN
- ○ — 5/8" I. ROD SET
- —x—x—x—x— EXISTING FENCE

REFERENCES

PLAT OF FIRST ADDITION TO EDEN ORCHARDS C.S. VOL 4, PG 66

C.S. M 20-33

C.S M 22-13

REGISTERED PROFESSIONAL ENGINEER 6025 Harold L. Ball OREGON SEPT. 8, 1967 HAROLD L. BALL

SURVEY TO ESTABLISH THE BOUNDARIES OF SCENIC DRIVE, A DEDICATED PUBLIC ROAD, BETWEEN LOTS A AND 8 OF THE FIRST ADDITION TO EDEN ORCHARDS

LOCATED IN SECTIONS 1 AND 2, T. 27 S., R. 7 W., W.M.

SURVEYED FOR RICHARD & SHERRY PRINCEN

MAY, 1973

BY HAROLD L. BALL — CIVIL ENGINEER — ROSEBURG, ORE.

MAP FILE M48 - 75

COUNTY SURVEYORS FILE DATA
DO NOT REMOVE FROM OFFICE