MAP FILE M42 - 19

SURVEY TO SET PROPERTY CORNERS AND DESCRIPTION
SITUATED IN SECTION 23, T.28S., R.8W.W.M.
FOR: RAY & DON WEAVER
BY: BAUGHMAN SURVEYING SERVICE

APRIL 1973 SCALE: 1" = 100'

COUNTY SURVEYORS FILE DATA
DO NOT REMOVE FROM OFFICE

FILED & RECEIVED
MAY 16 1973
COUNTY SURVEYOR
DOUGLAS COUNTY, ORE.

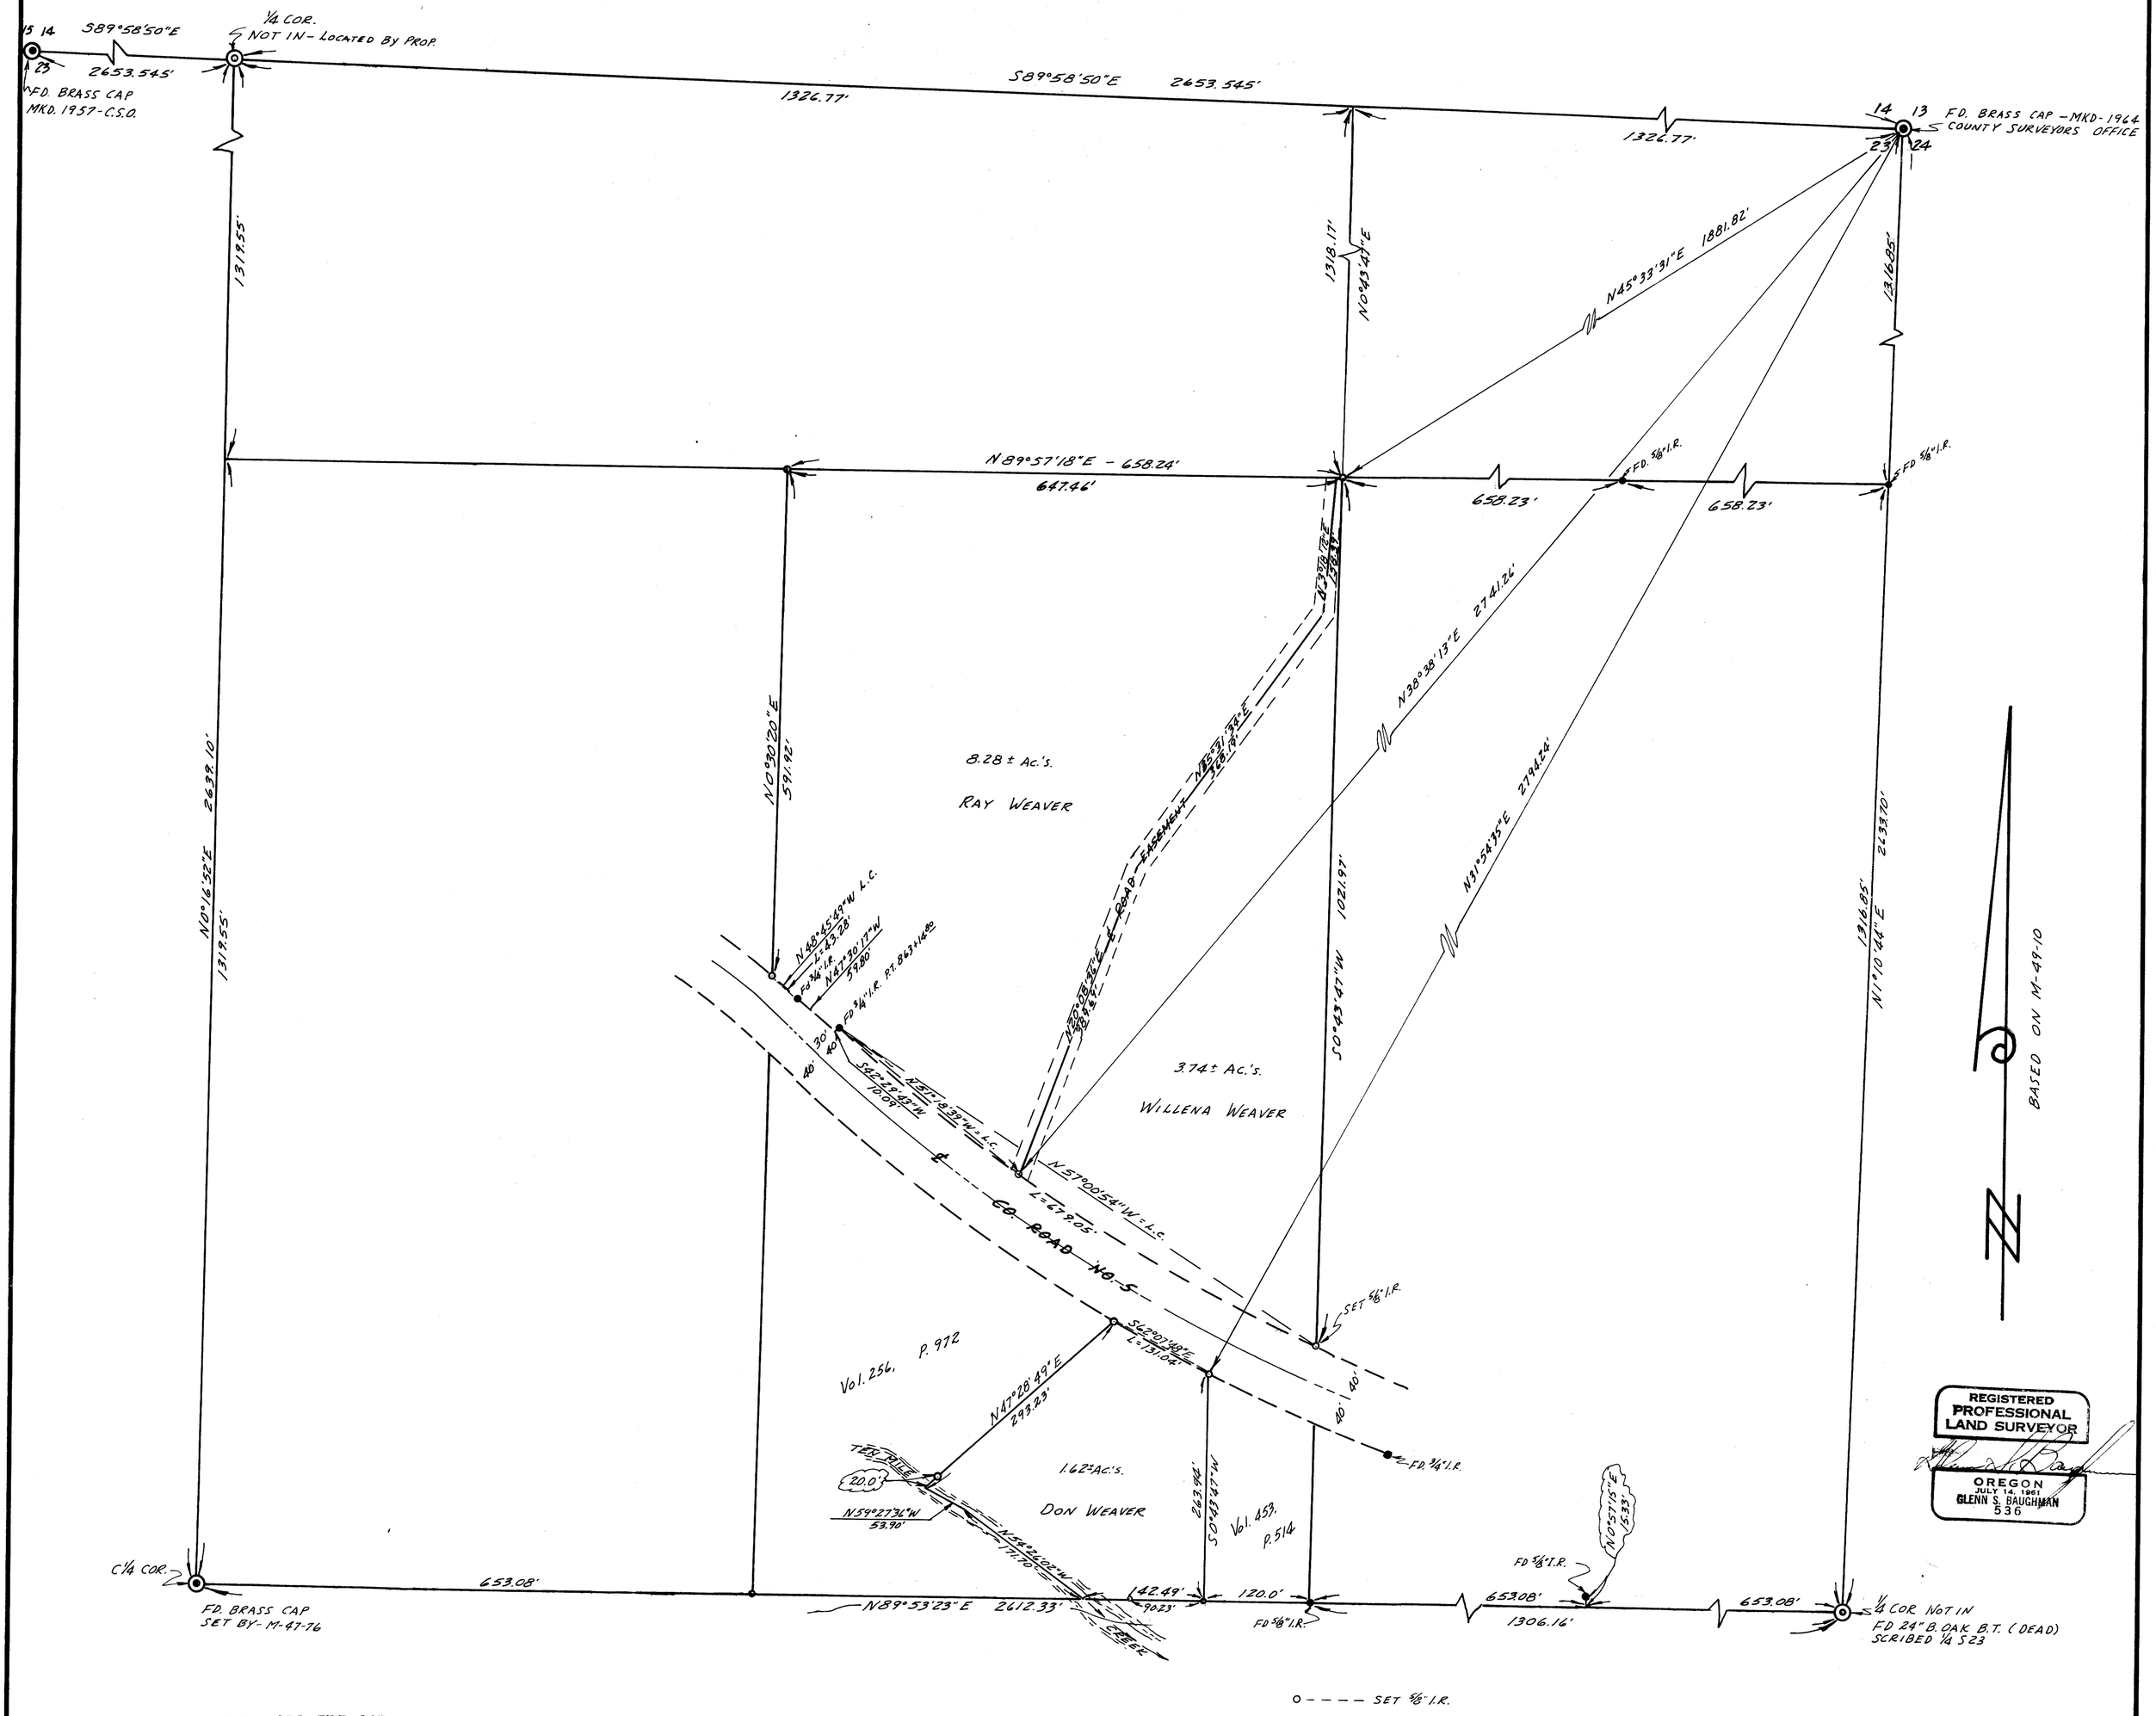

COUNTY SURVEYORS FILE DATA
DO NOT REMOVE FROM OFFICE

MAP FILE M49 - 19