COUNTY SURVEYORS FILE DATA
DO NOT REMOVE FROM OFFICE

SURVEY FOR PROPERTY CORNERS IN THE WEST 1/2 SEC. 14, T.29S., R.4W., W.M. FOR — SUN STUDS INC. BY — BURTON W. HOLT

SEPTEMBER 1973 SCALE 1" = 200'

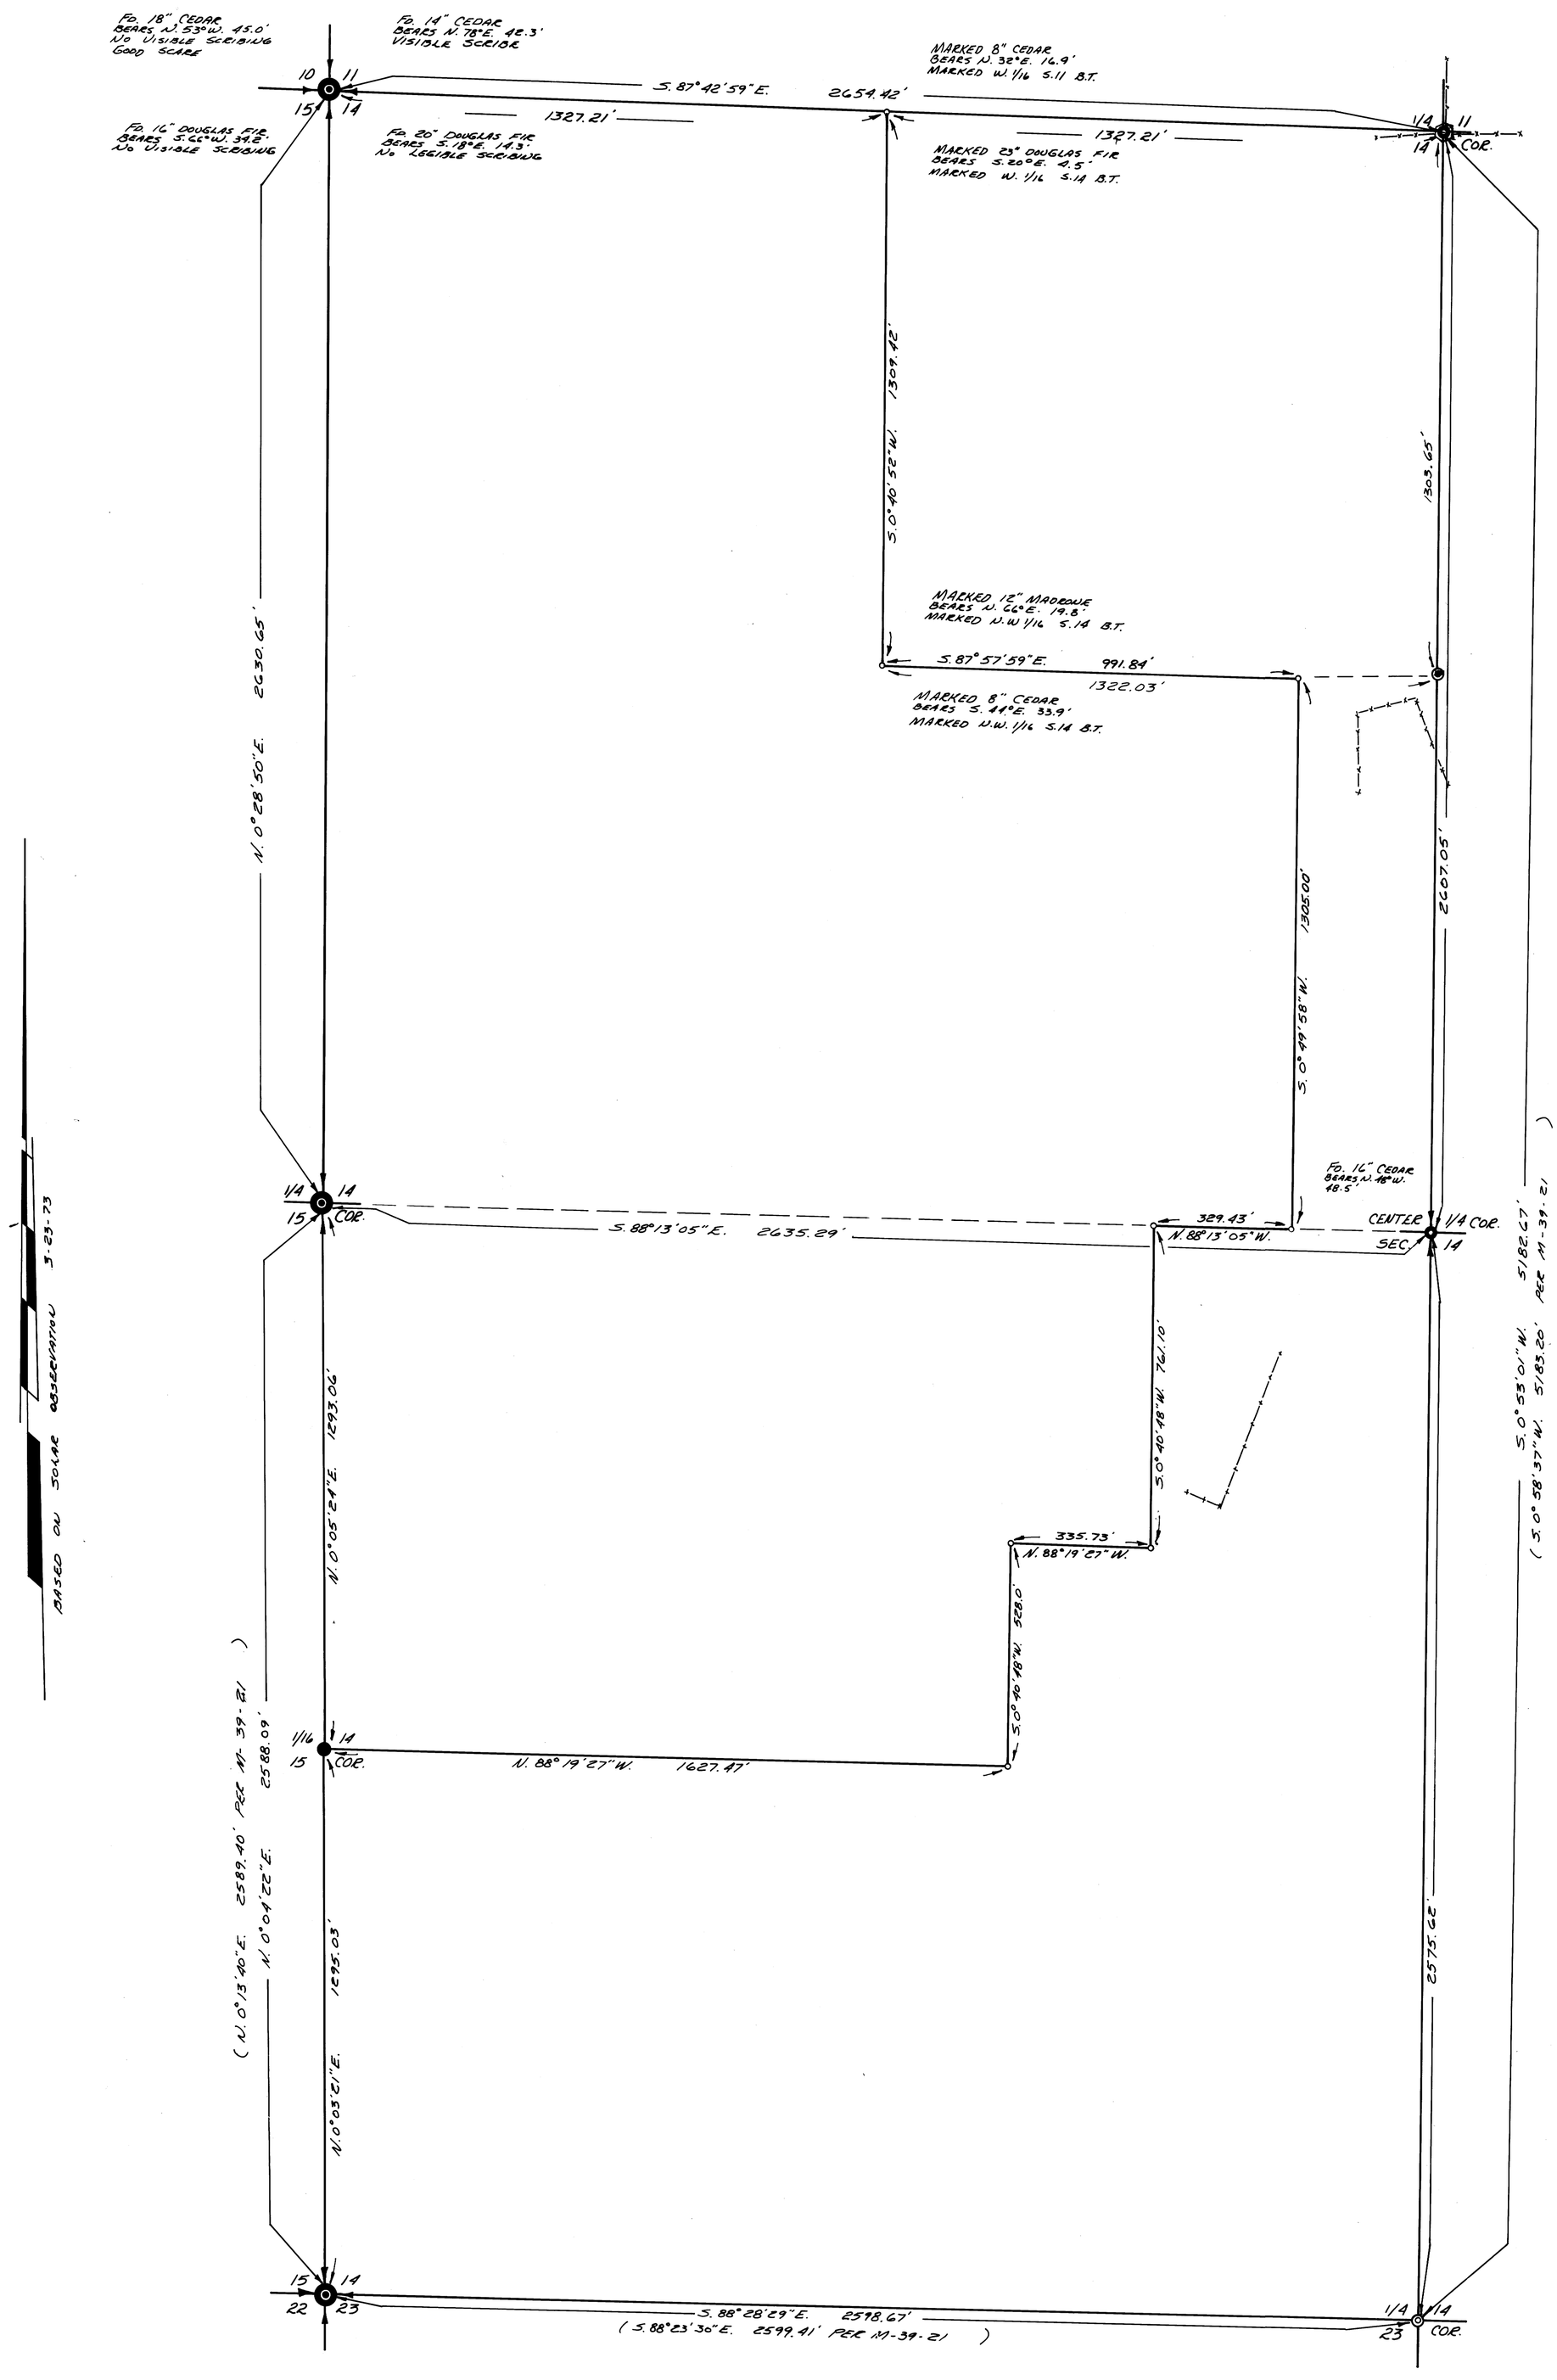

REGISTERED PROFESSIONAL LAND SURVEYOR
Burton W. Holt
OREGON
OCTOBER 4, 1957
BURTON W. HOLT
418

LEGEND

- SET 5/8" I.R.
- FD. IRON BOLT
- FD. I.P.
- FD. 3/4" I.P.
- FD. 2" I.P.
- FD. BRASS CAP
- FD. 3/4" I.R.

COUNTY SURVEYORS FILE DATA
DO NOT REMOVE FROM OFFICE