COUNTY SURVEYORS FILE MAP
DO NOT REMOVE FROM OFFICE
MAP FILE M49-75

M 49-75

FILED
RECEIVED KR
OCT 22 1974
COUNTY SURVEYOR
DOUGLAS COUNTY, ORE.

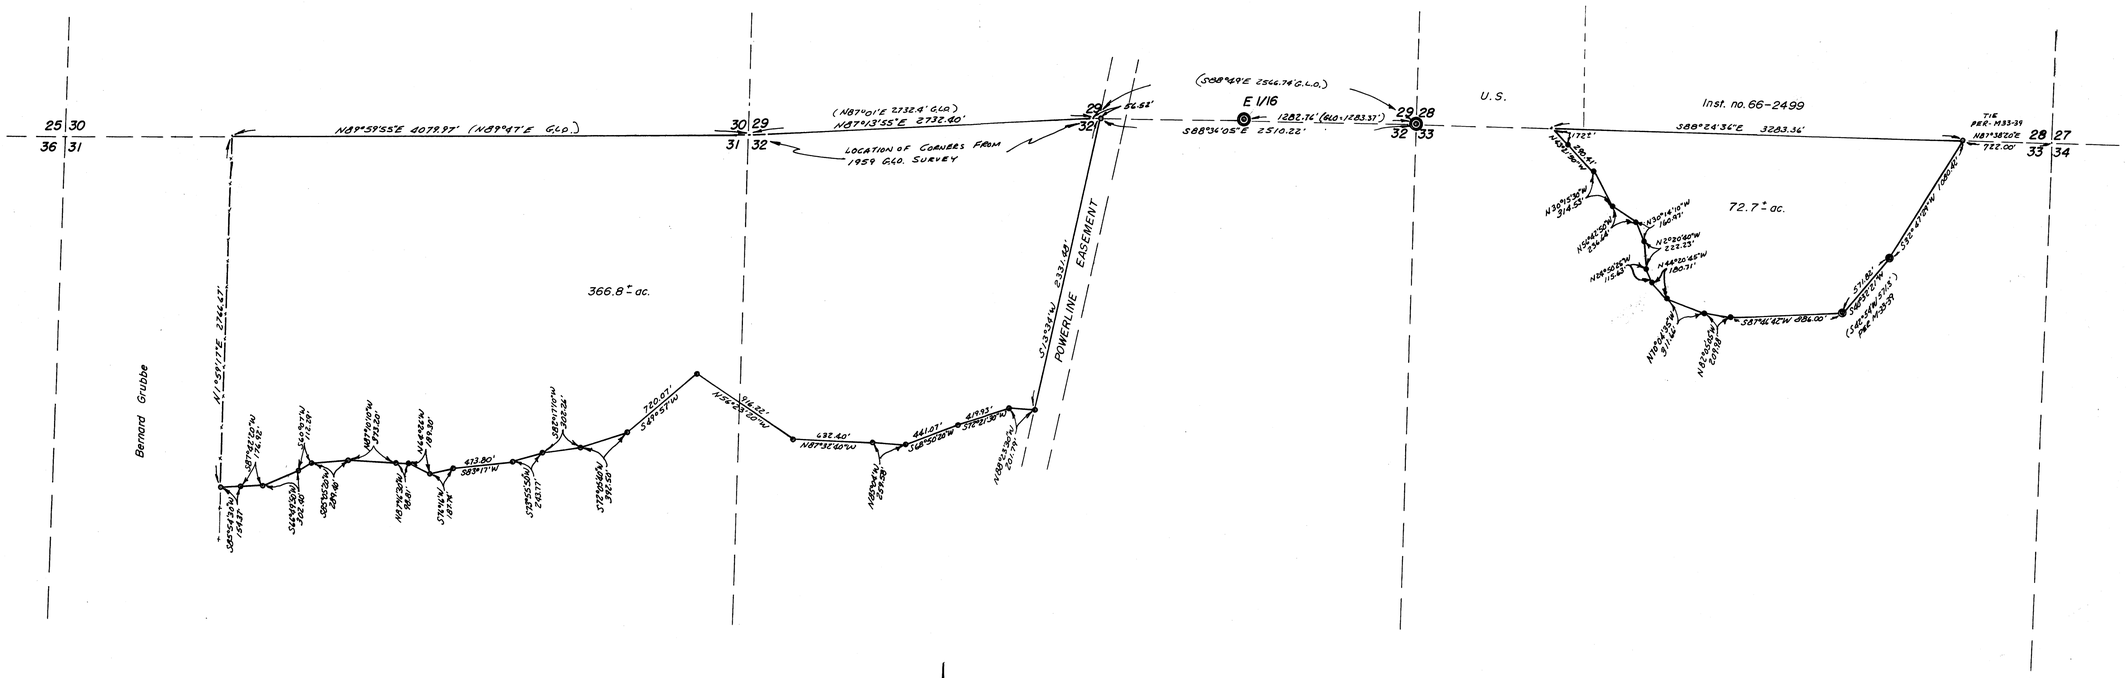

LEGEND

- ○ Set 1/2" iron rod
- ● Set 5/8" iron rod
- ◉ Found 3/4" iron rod
- ◎ Found Brass cap

N

Based on Solar Observation

SURVEY FOR DESCRIPTION
IN SECTIONS 31, 32 & 33, T.25S.R.4W.W.M.

FOR: SUN STUDS

BY: BAUGHMAN SURVEYING SERVICE

SCALE: 1" = 600' OCTOBER 1974

REGISTERED PROFESSIONAL LAND SURVEYOR
OREGON
SEAL BAUGHMAN

M 49-75

COUNTY SURVEYORS FILE MAP
DO NOT REMOVE FROM OFFICE
MAP FILE M49-75