COUNTY SURVEYORS FILE DATE
DO NOT REMOVE FROM OFFICE

FILED
RECEIVED
NOV 7 1974
COUNTY SURVEYOR
DOUGLAS COUNTY, ORE.

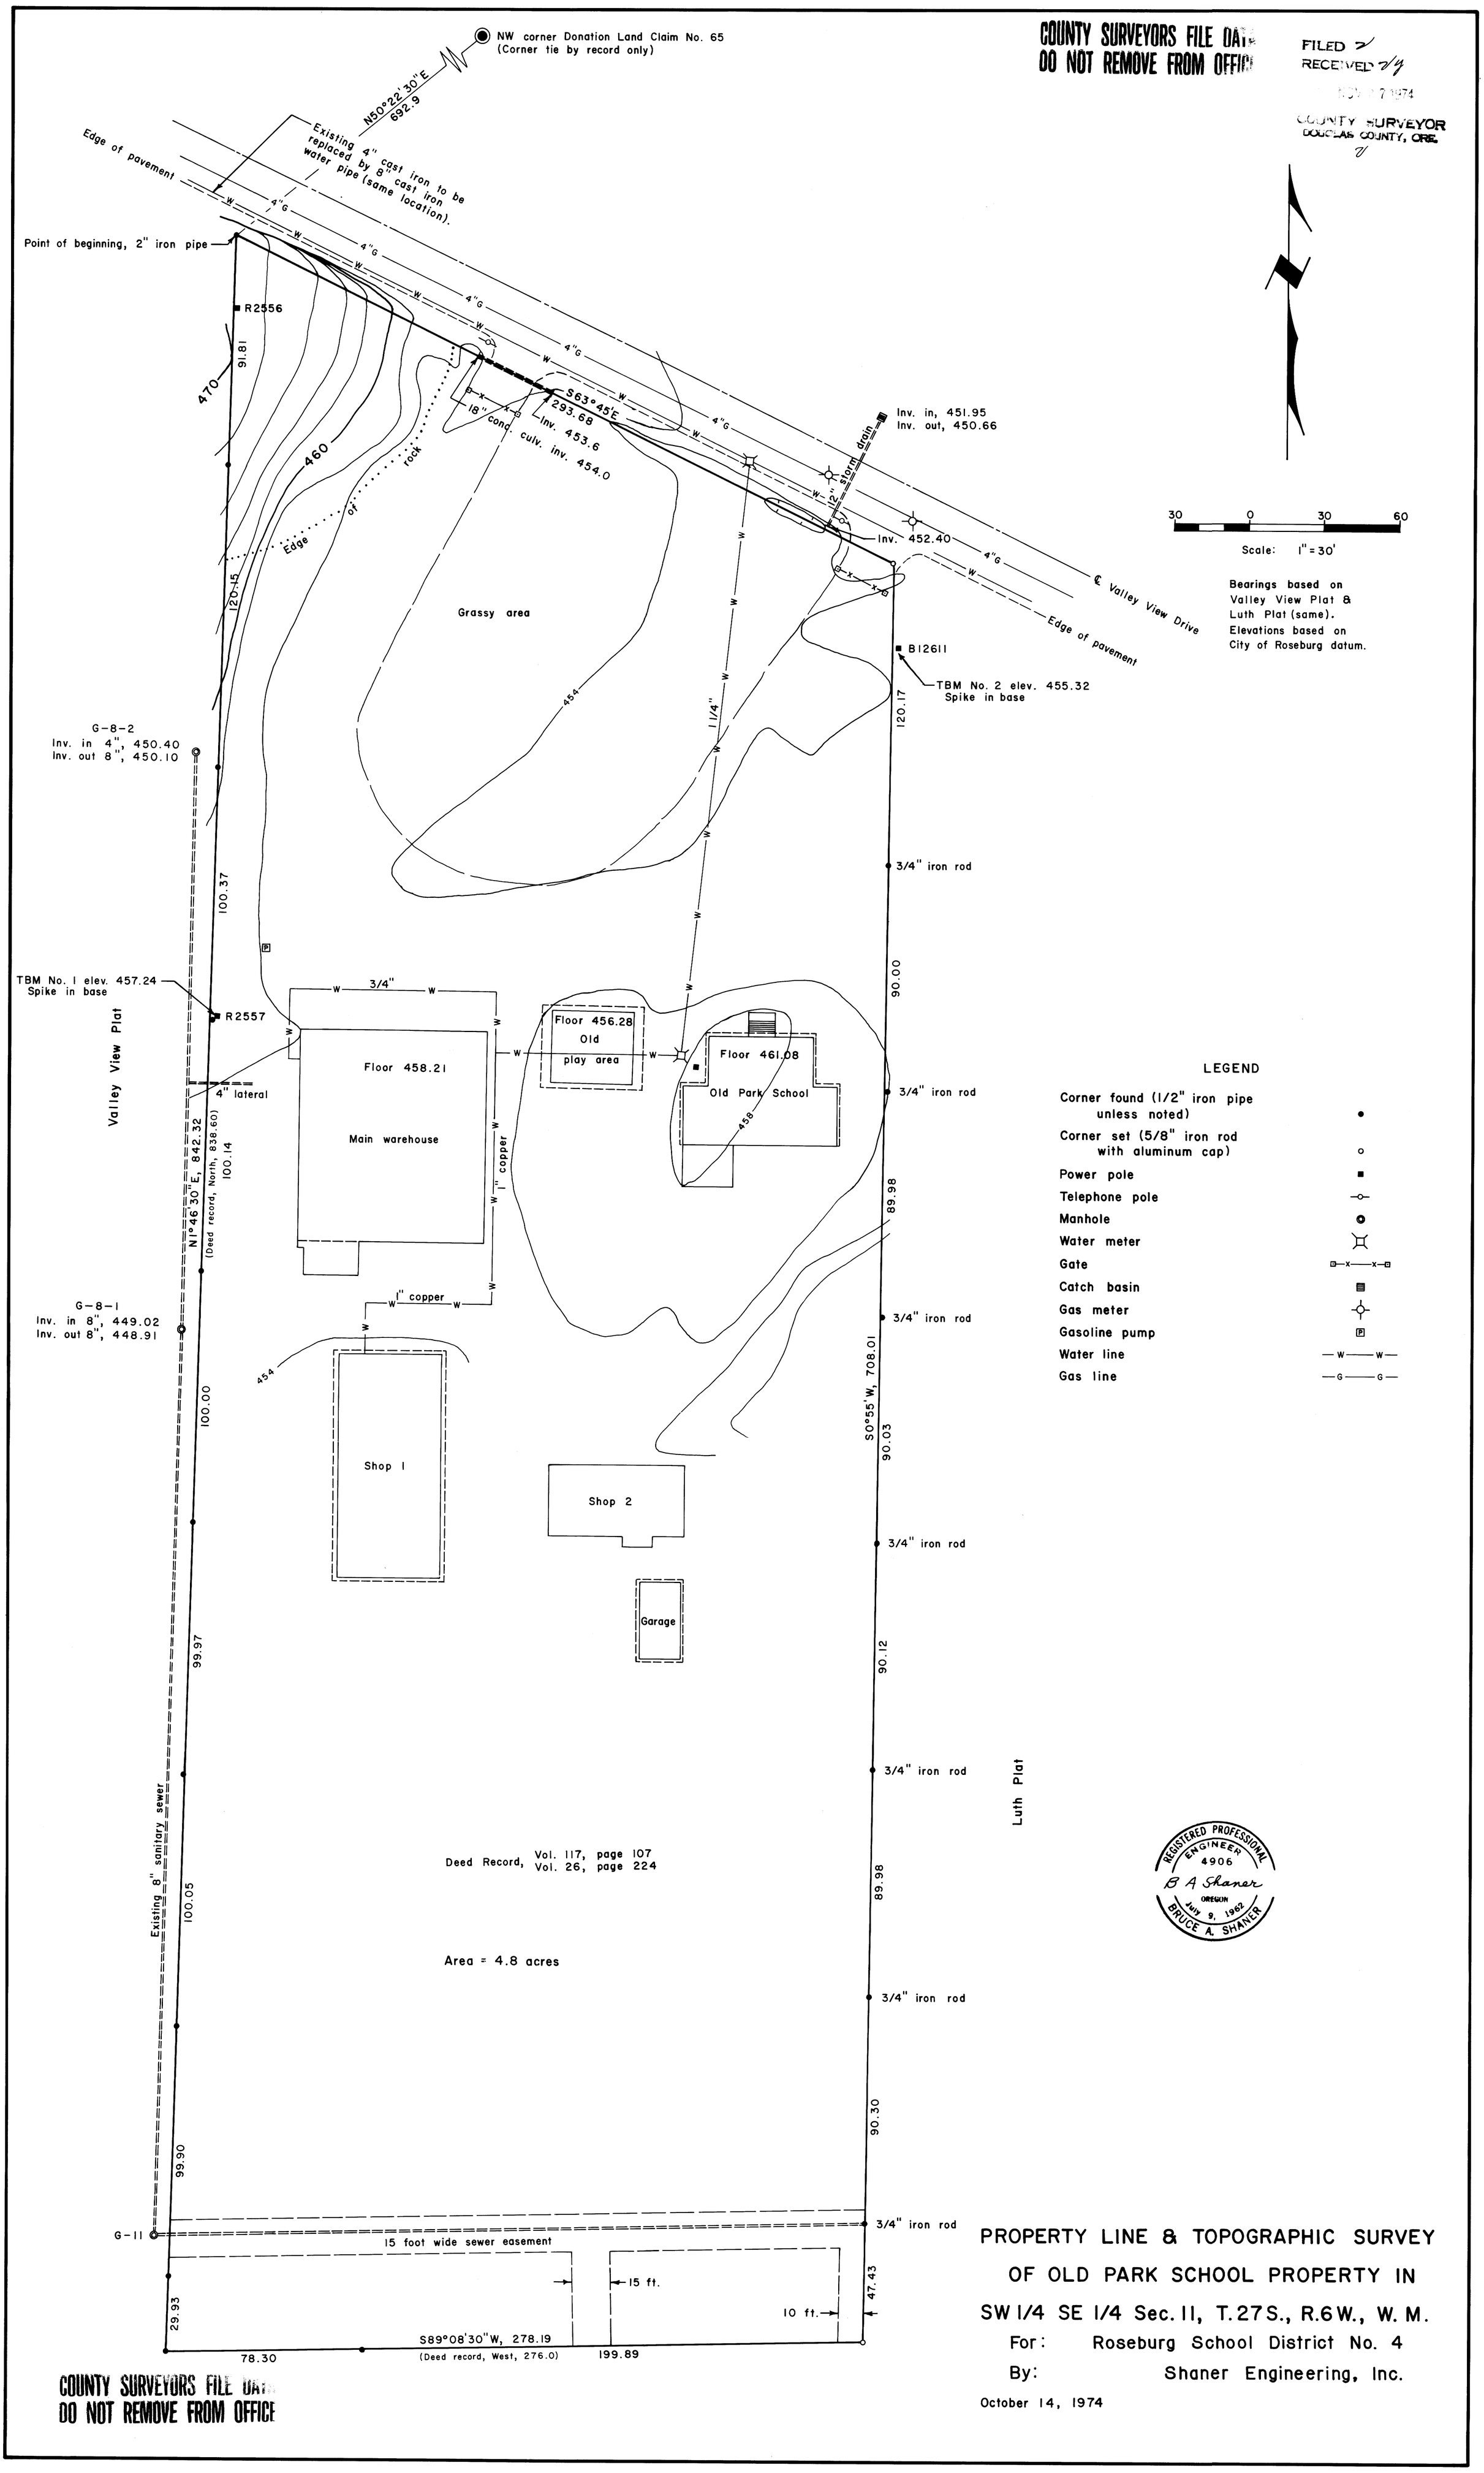

Deed Record, Vol. 117, page 107
Vol. 26, page 224

Area = 4.8 acres

PROPERTY LINE & TOPOGRAPHIC SURVEY OF OLD PARK SCHOOL PROPERTY IN SW 1/4 SE 1/4 Sec. 11, T. 27 S., R. 6 W., W. M.

For: Roseburg School District No. 4

By: Shaner Engineering, Inc.

October 14, 1974

COUNTY SURVEYORS FILE DATE
DO NOT REMOVE FROM OFFICE

MAP FILE M49-77