COUNTY SURVEYORS FILE DATA
DO NOT REMOVE FROM OFFICE

FILED
RECEIVED
JUL 10 1973
COUNTY SURVEYOR
DOUGLAS COUNTY, ORE.

MAP FILE M 50 - 12

SURVEY IN SECTION 26, T30S, R3W, W.M., DOUGLAS CO., OREGON

Surveyed for Milo Academy Inc. by Victor M. McLind

June, 1973

Scale: 1" = 200'

• ~ Indicates found 5/8" iron rod unless otherwise noted

Bearings are based on Solar Observation taken May 17, 1973

Note: This map supercedes M 48-47

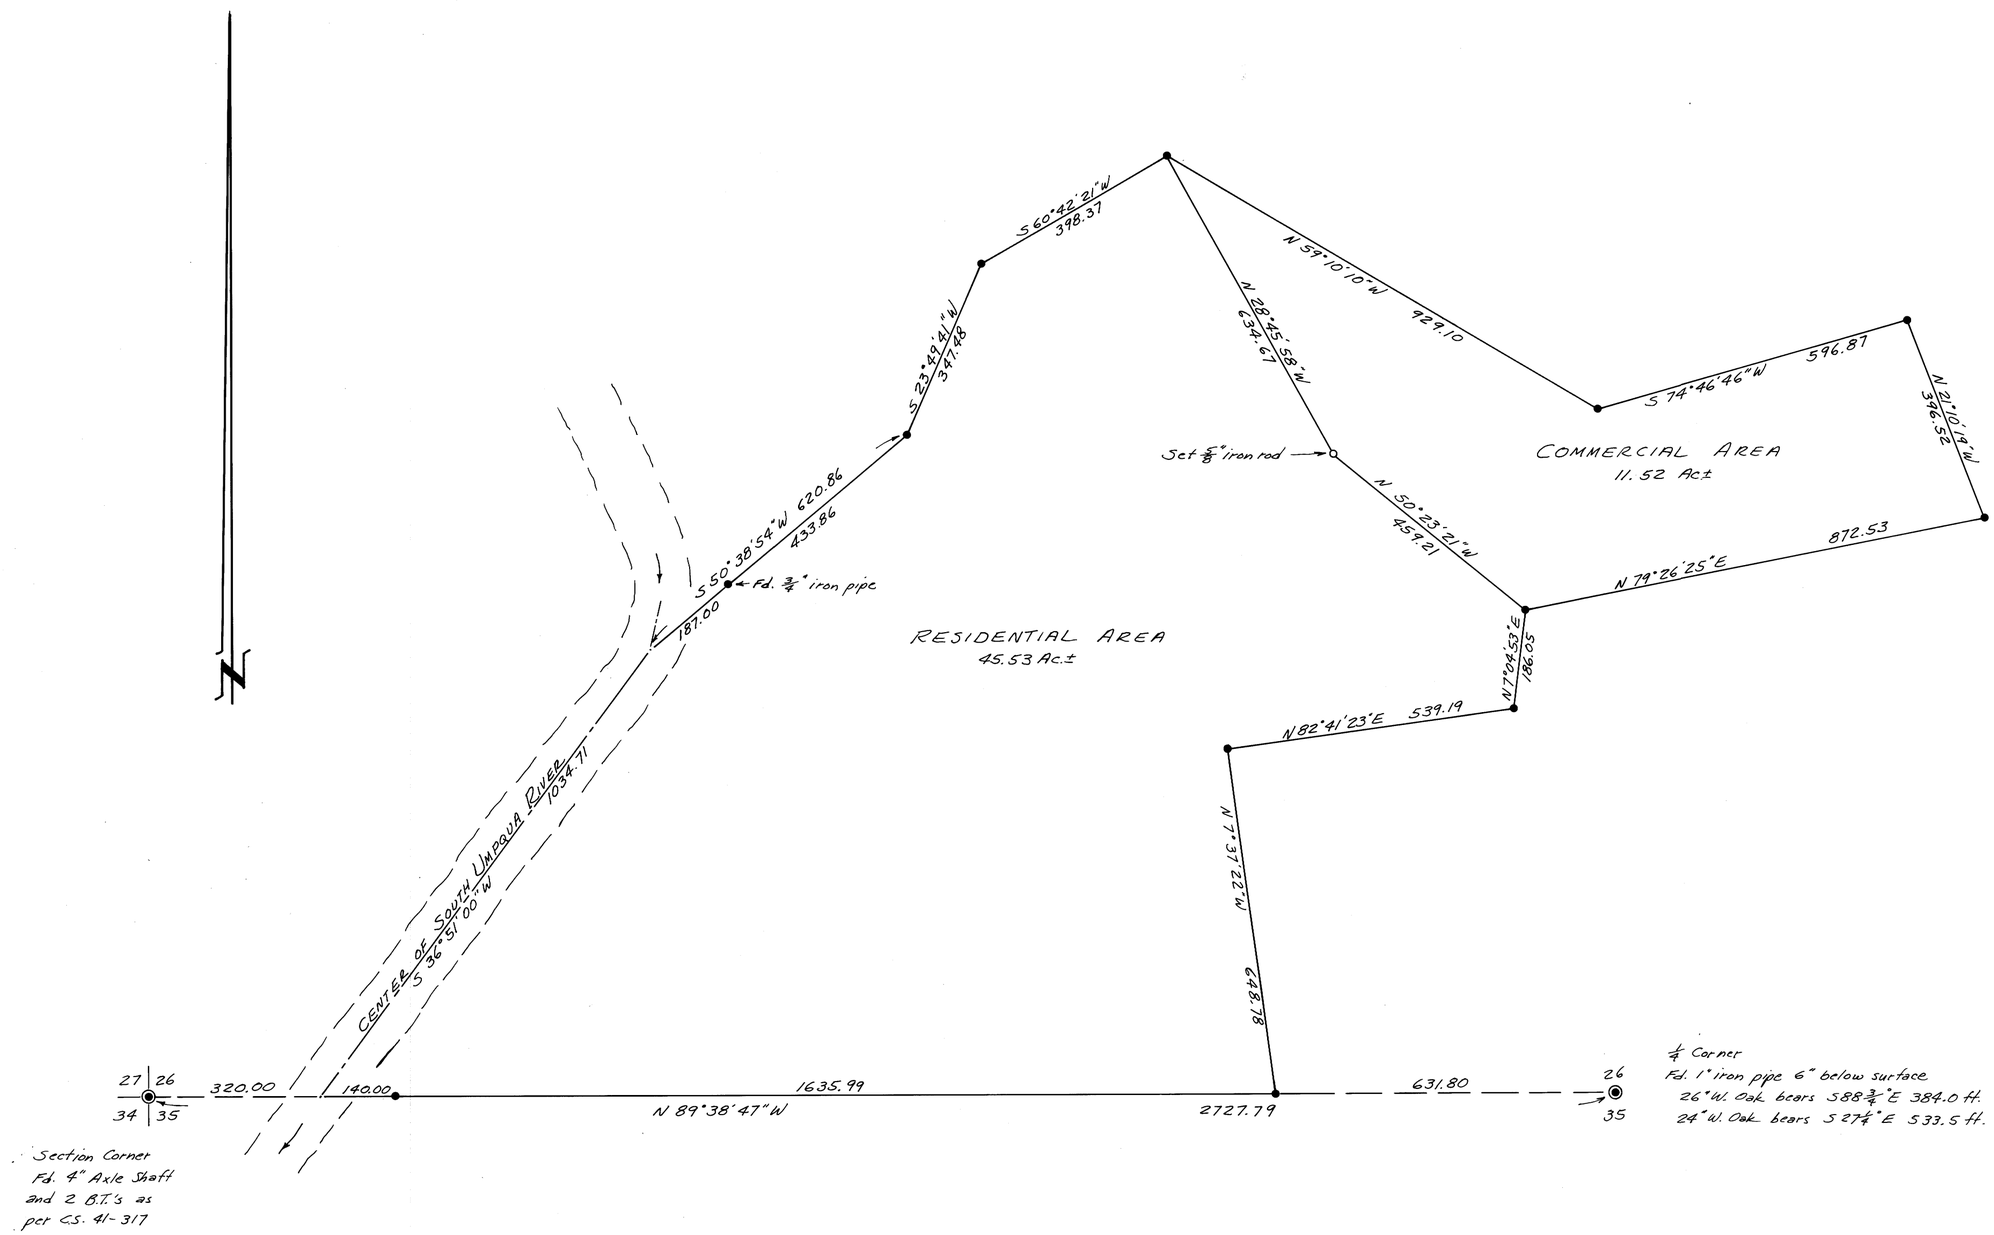

Section Corner
Fd. 4" Axle Shaft
and 2 B.T.'s as
per C.S. 41-317

1/4 Corner
Fd. 1" iron pipe 6" below surface
26" W. Oak bears S 88 3/4° E 384.0 ft.
24" W. Oak bears S 27 1/4° E 533.5 ft.

REGISTERED
PROFESSIONAL
LAND SURVEYOR
Victor M. McLind
OREGON
VICTOR M. McLIND
934

MAP FILE M 50 - 12