MAP FILE M50 - 40

COUNTY SURVEYORS FILE DATA
DO NOT REMOVE FROM OFFICE

SURVEY IN SEC. 23, T26S, R5W, W.M.

Surveyed for Mrs. E.G. Kohlhagen by Victor M. McLind

July 1973 Scale: 1"=200'

○— Indicates Set $\frac{5}{8}$"x 30" Iron Rod

●— Indicates Found $\frac{3}{4}$" Iron Rod, See Vol. 12, Pg. 7; RM 1-14; M 21-58; & M 19-74

Note: numbers in brackets are record distances.

FILED
RECEIVED
AUG 2 1973
COUNTY SURVEYOR
DOUGLAS COUNTY, OREGON

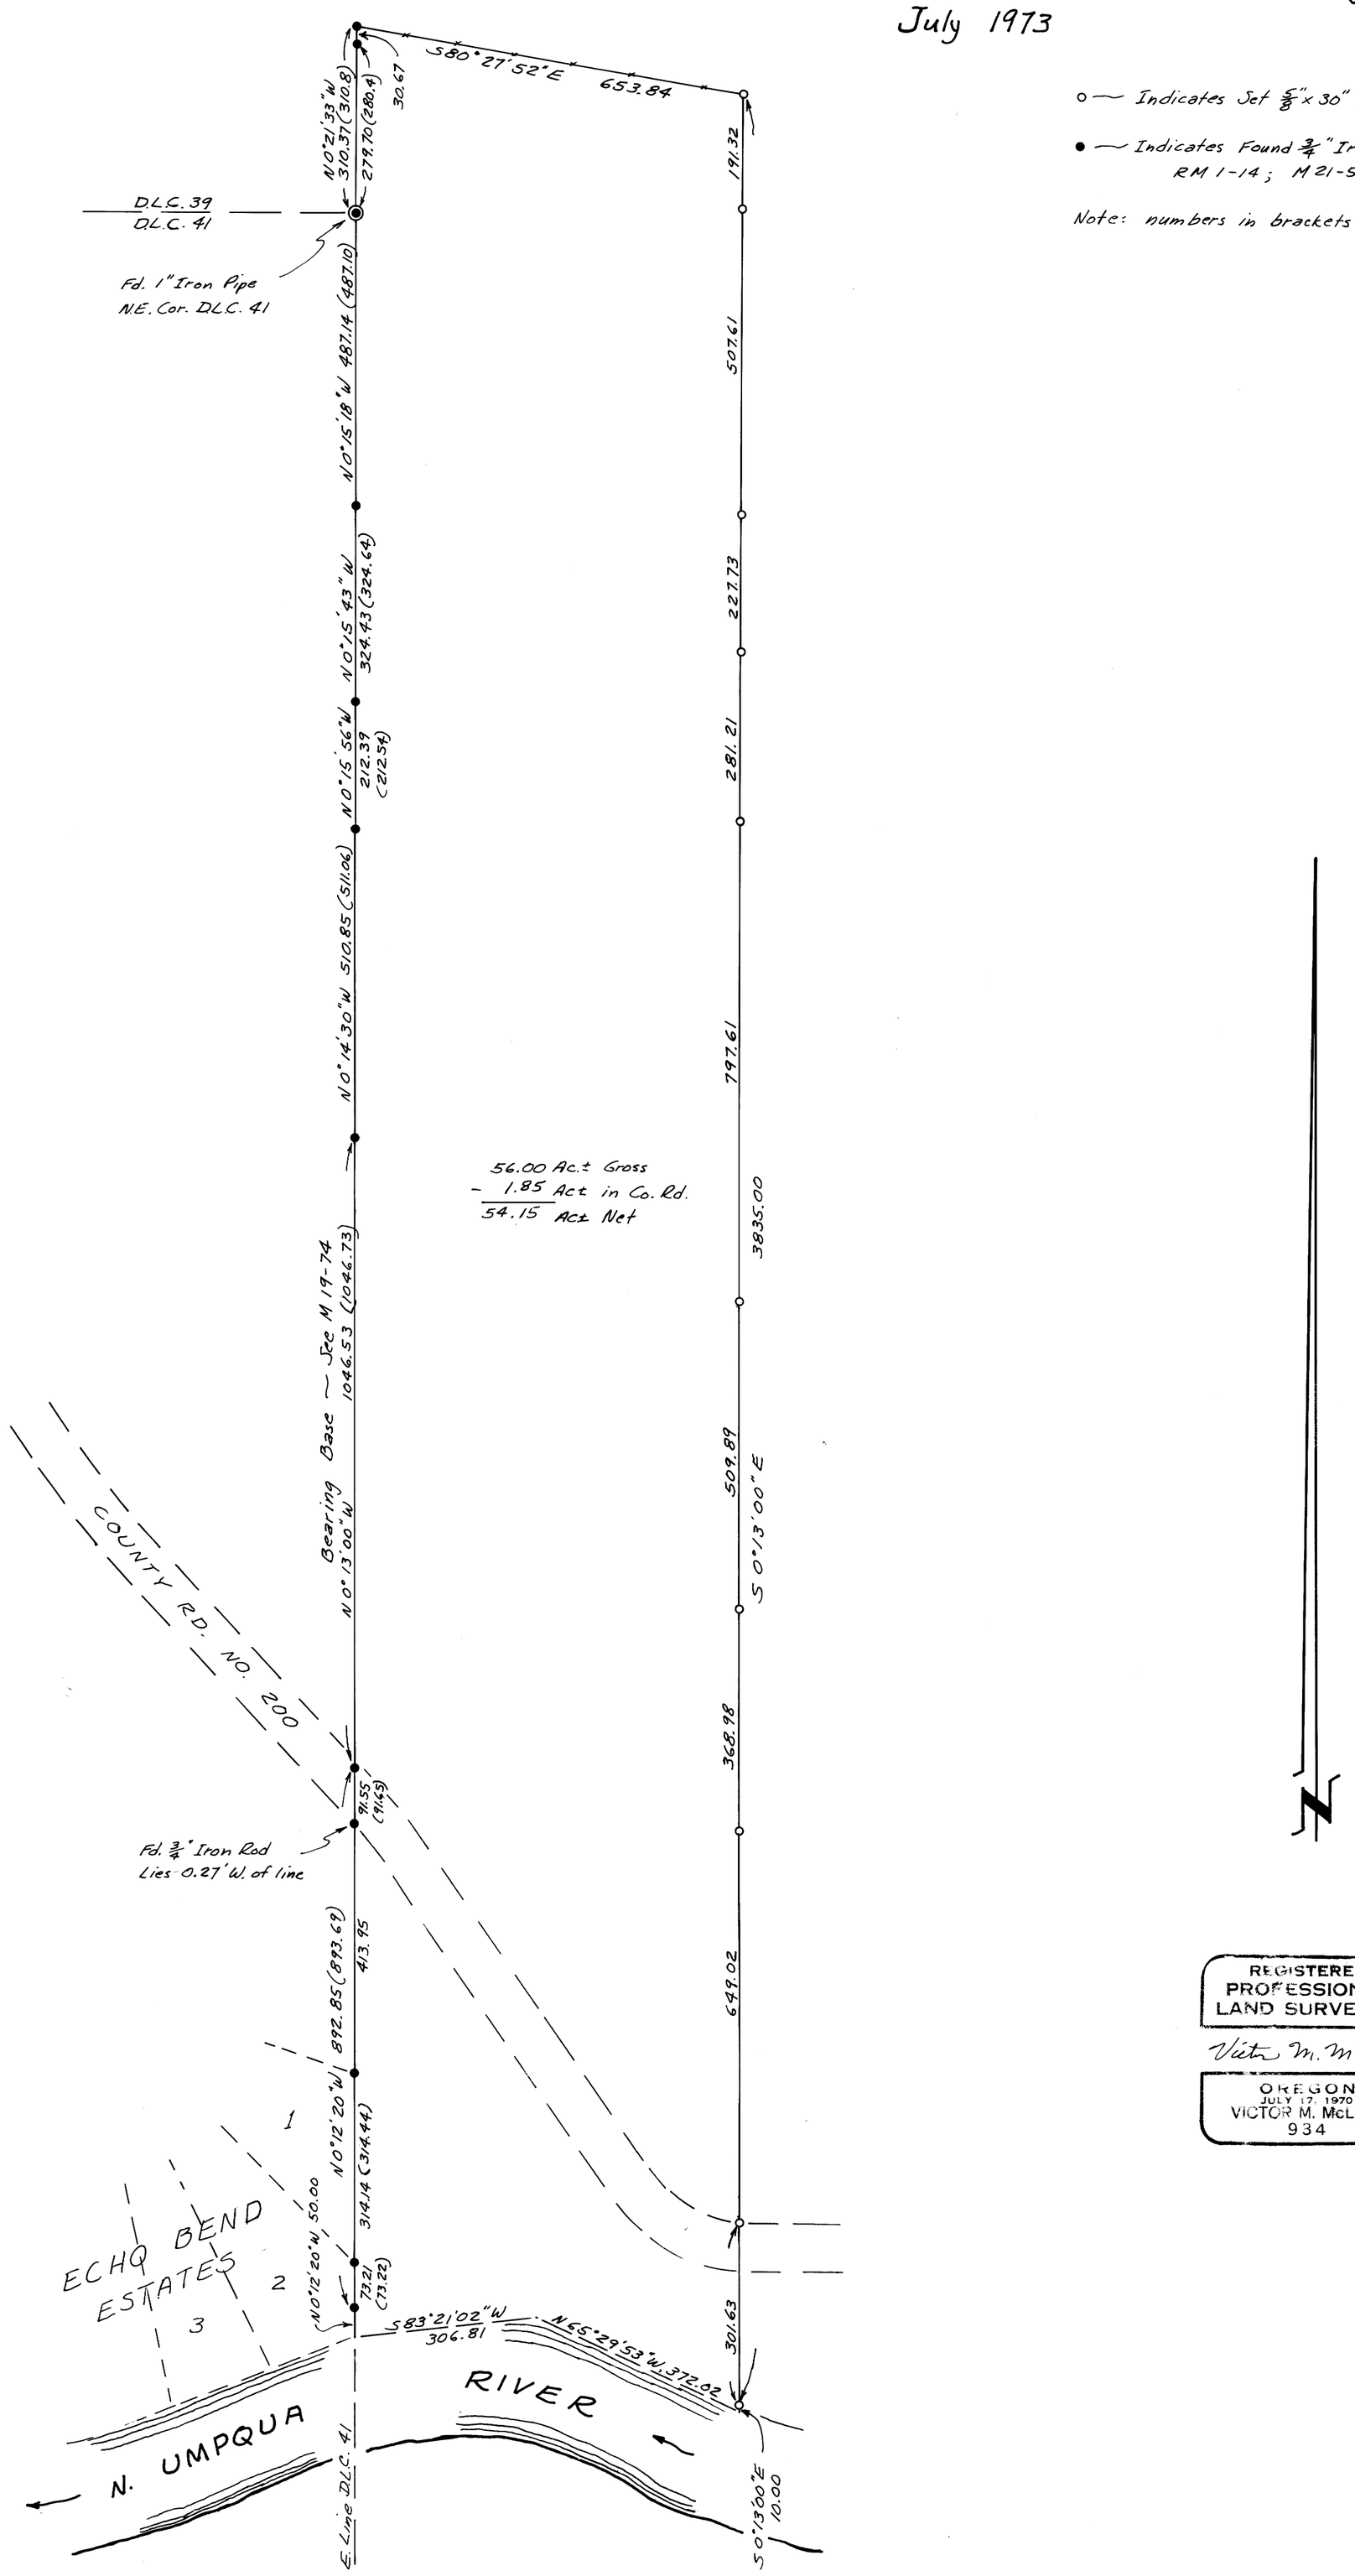

REGISTERED
PROFESSIONAL
LAND SURVEYOR

Victor M. McLind

OREGON
JULY 17, 1970
VICTOR M. McLIND
934

MAP FILE M50 - 40