SURVEY FOR PROPERTY CORNERS IN THE S.E. 1/4 SEC. 15, T.27S., R.5W., W.M.

FOR NORDIC VENEER

BY BAUGHMAN SURVEYING SERVICE

COUNTY SURVEYORS FILE DATA
DO NOT REMOVE FROM OFFICE

AUG 2 1973
COUNTY SURVEYOR
DOUGLAS COUNTY, ORE.

AUGUST 1973

SCALE 1" = 200'

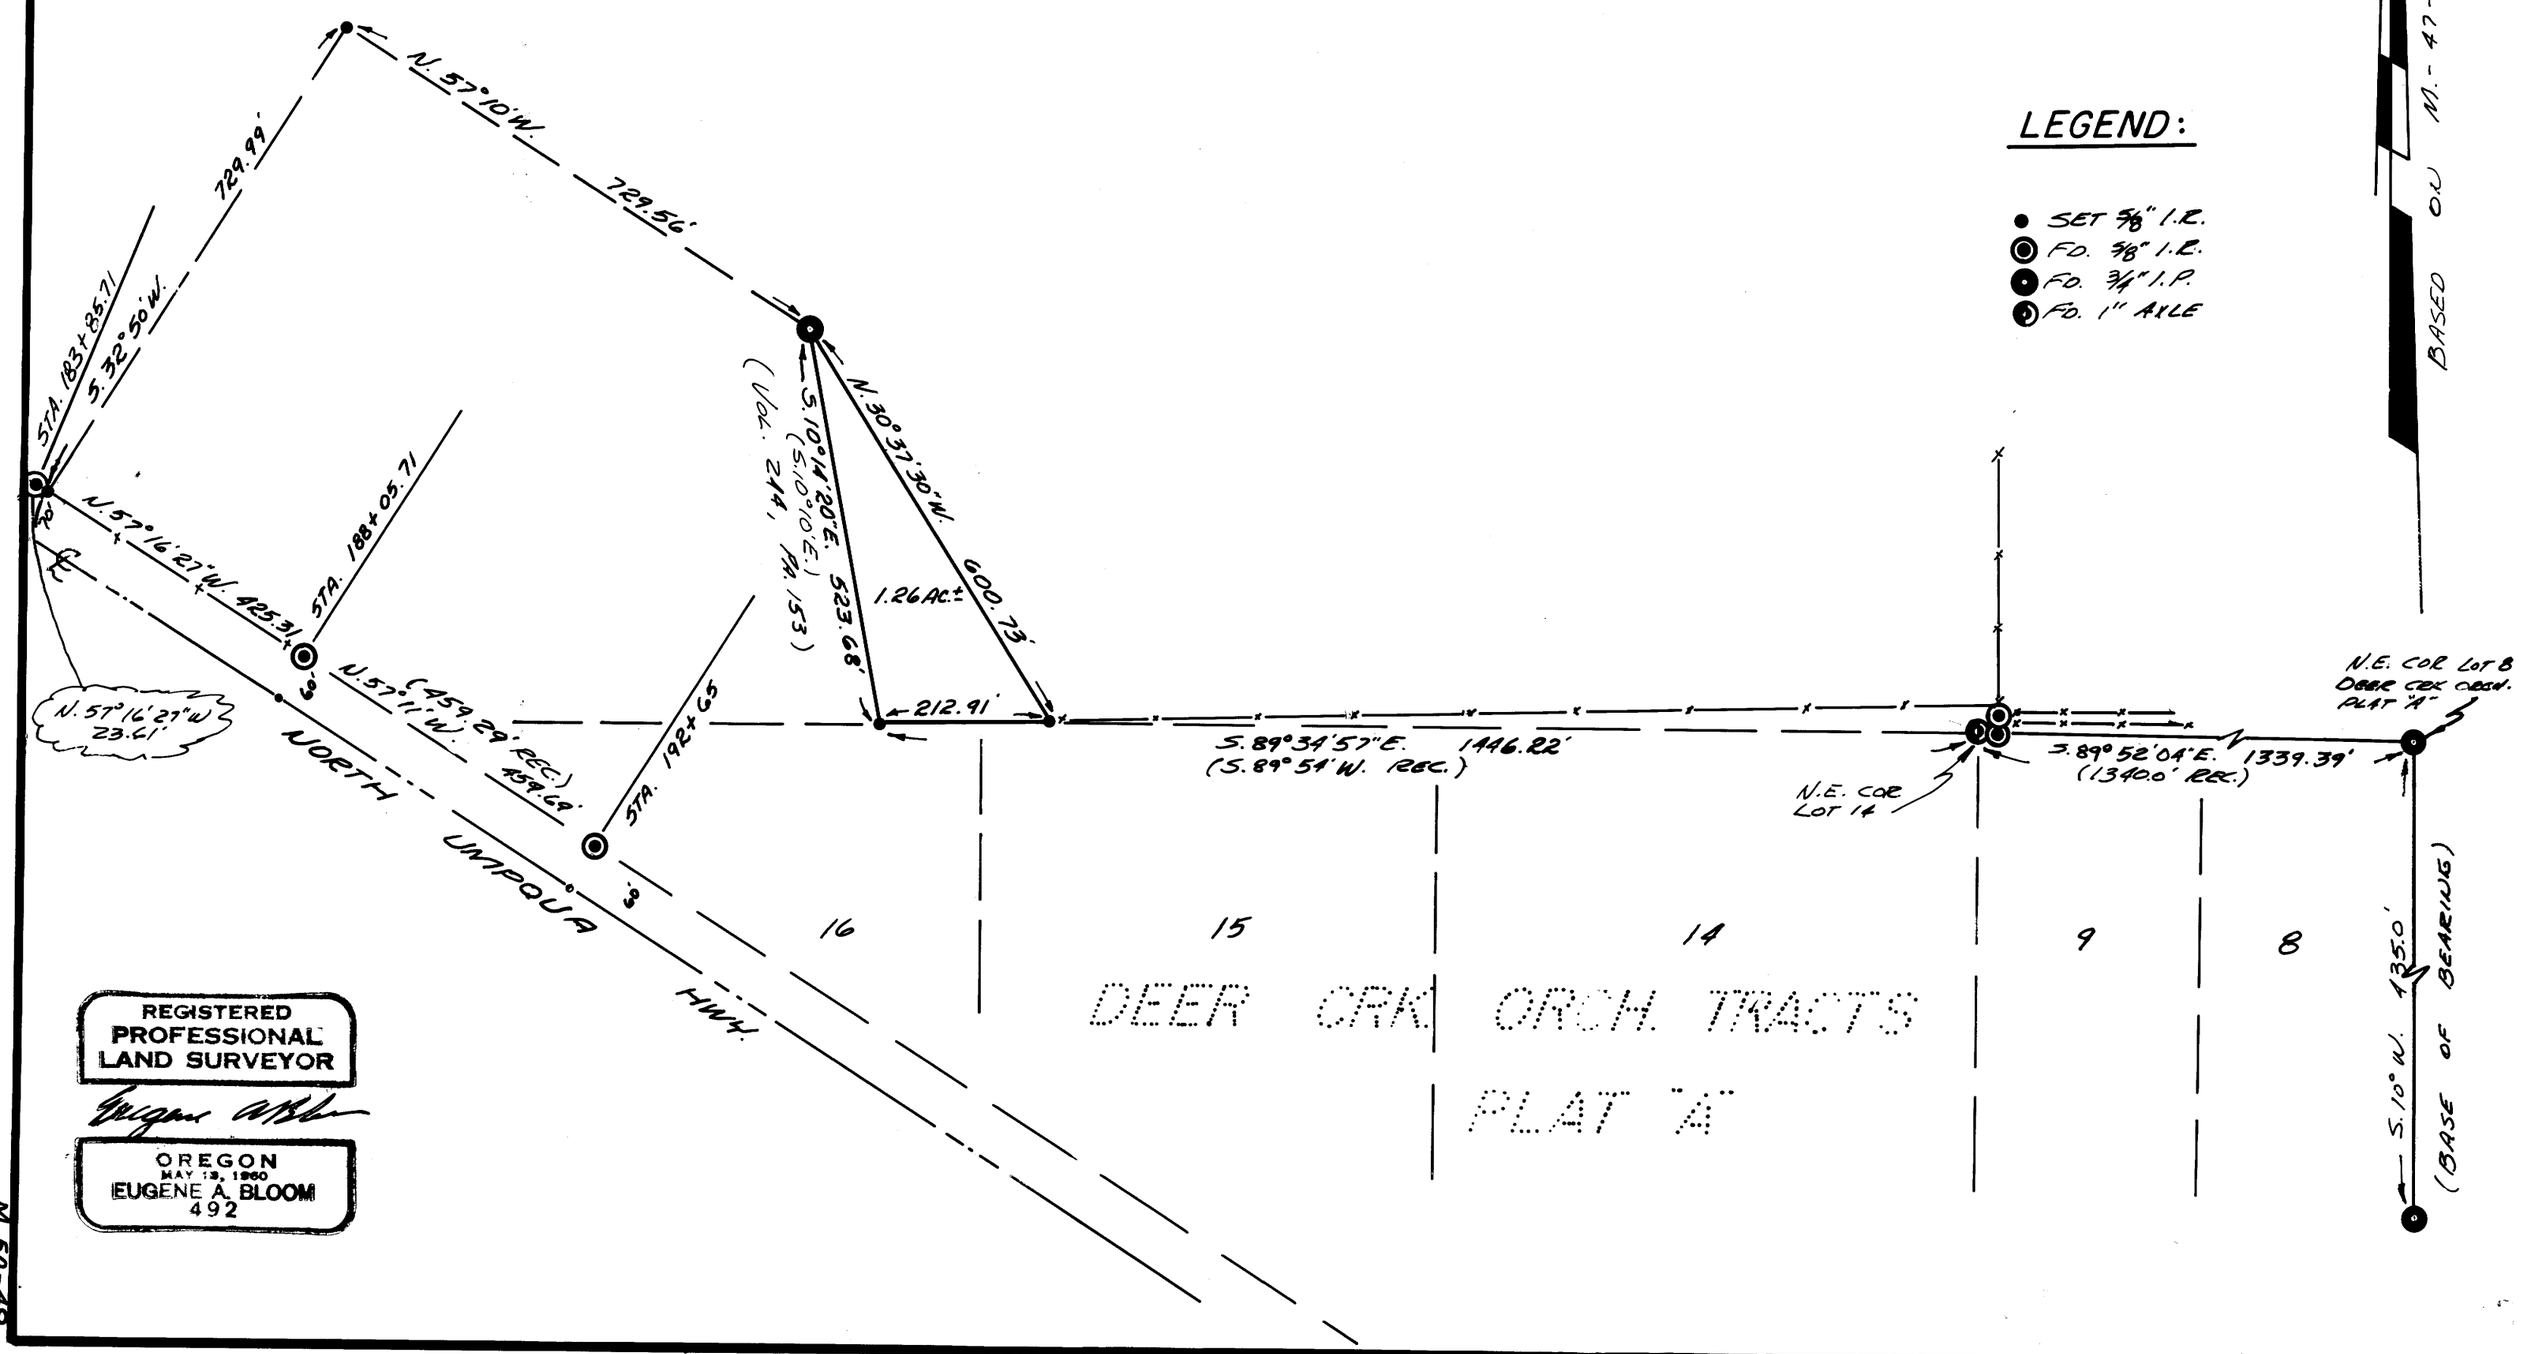

REGISTERED
PROFESSIONAL
LAND SURVEYOR

Eugene A. Bloom

OREGON
MAY 13, 1960
EUGENE A. BLOOM
492