SURVEY IN SECTIONS 11 & 12, T 24 S, R 7 W, WM., DOUGLAS CO., ORE.

Surveyed for Roy Scott by Victor M. McLind

June, 1973

Scale: 1" = 100'

• ~ Indicates Found 5/8" Iron Rod (See RM 2-33)

o ~ Indicates Set 5/8" x 30" Iron Rod

COUNTY SURVEYORS FILE DATA
DO NOT REMOVE FROM OFFICE

FILED by
RECORDED by
JUL 2 1973
COUNTY SURVEYOR
DOUGLAS COUNTY, ORE.
ml

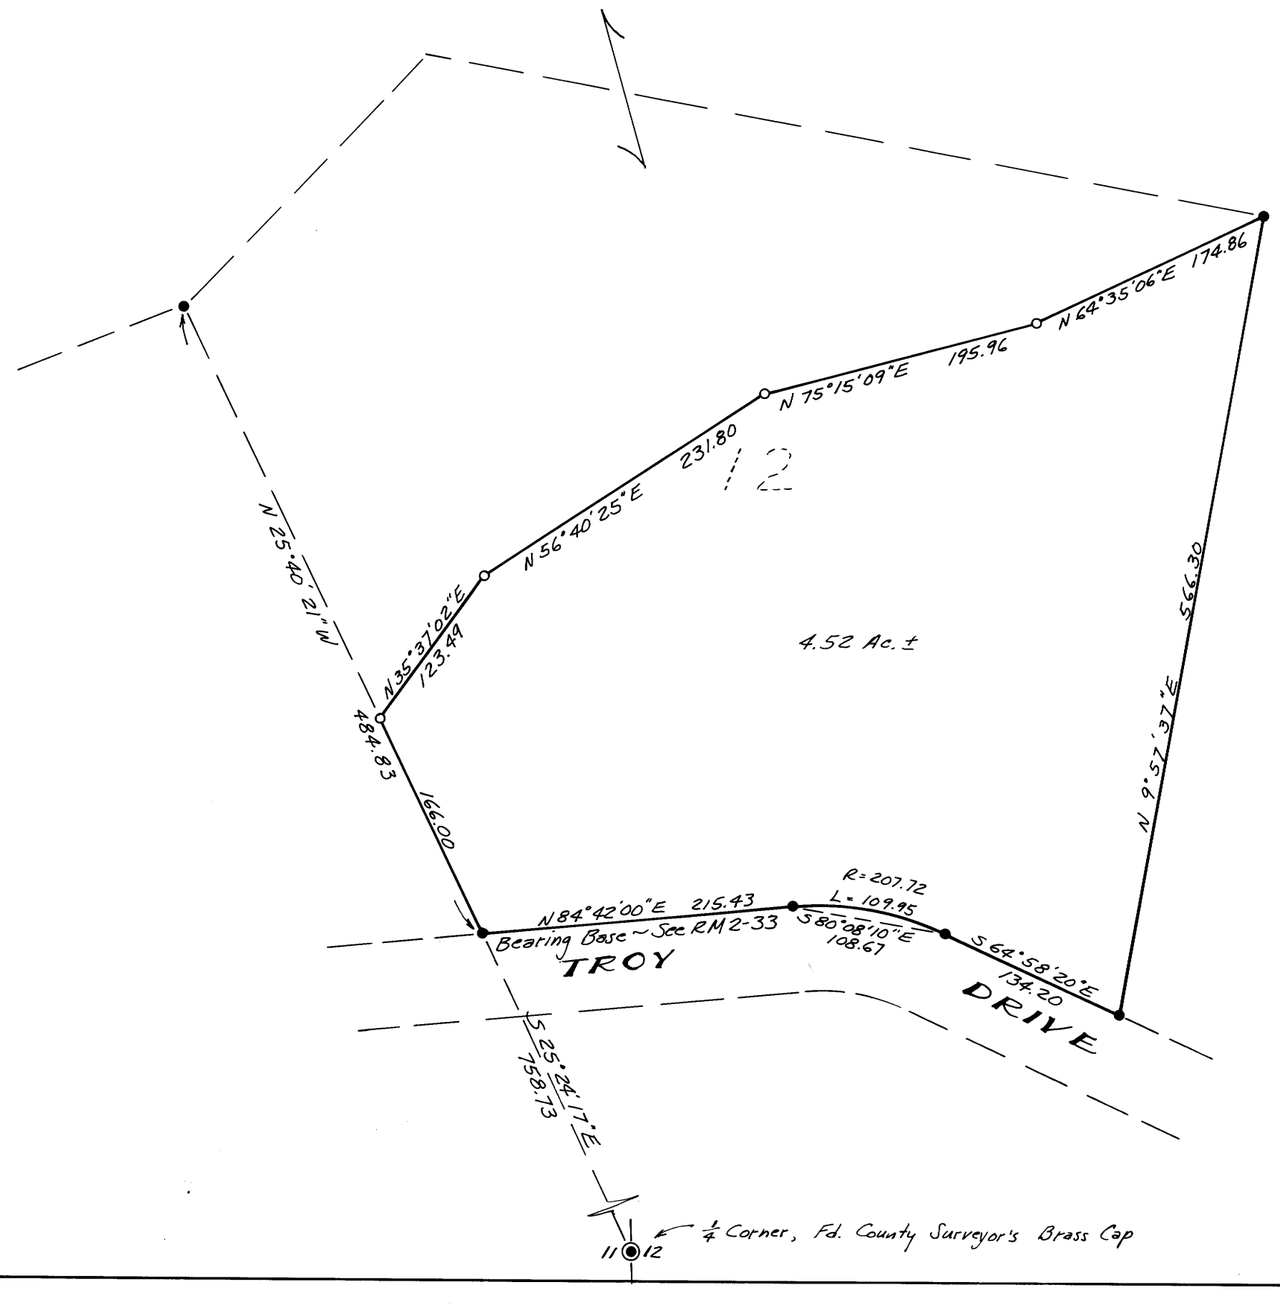

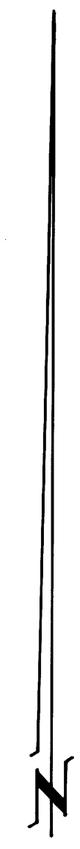

Victor M. McLind

MAP M50-5