SURVEY FOR PROPERTY CORNERS IN BOGGS ORCH. TRACTS
LOTS 31, 32, 34, 36, 38, 40, 42, & 44 IN SEC. 1 & 12 T. 28 S., R. 6 W., W.M.
FOR WESTERN LAND MANAGEMENT
BY BAUGHMAN SURVEYING SERVICE

AUGUST 1973 SCALE 1" = 200'

COUNTY SURVEYORS FILE DATA
DO NOT REMOVE FROM OFFICE

FILED & RECEIVED
AUG 27 1973
COUNTY SURVEYOR
DOUGLAS COUNTY, ORE.

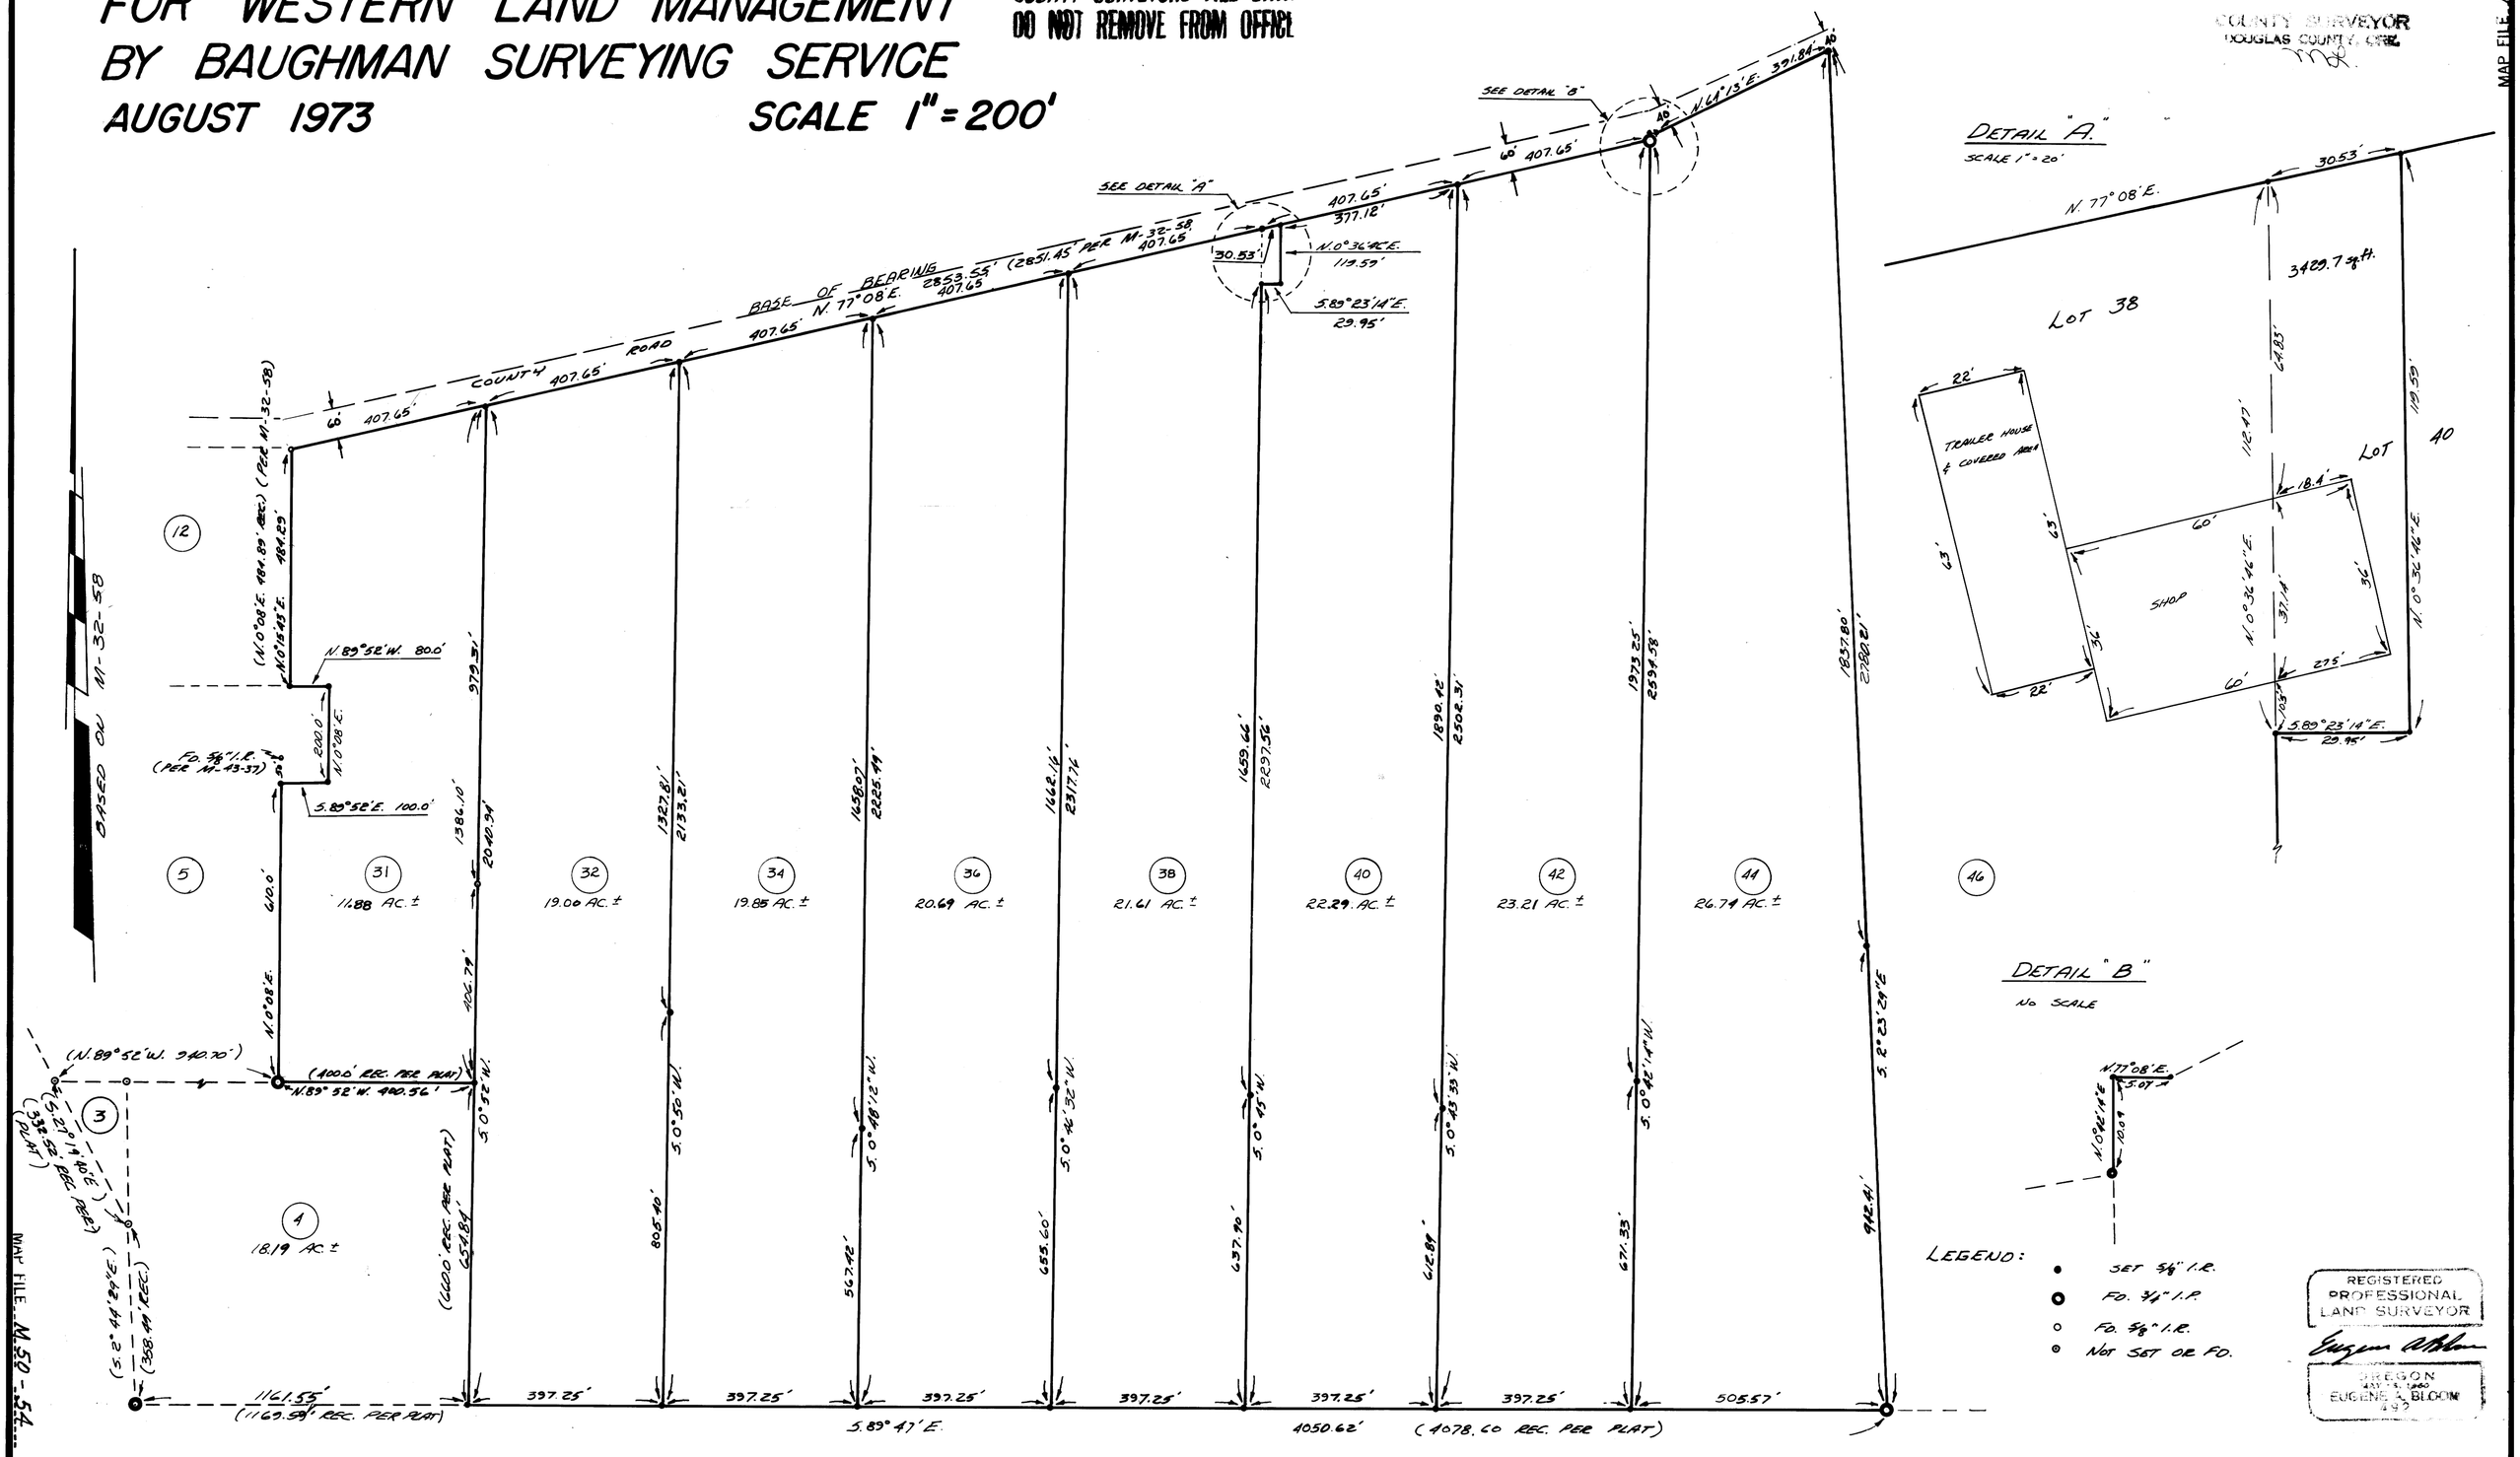

LEGEND:

- ● SET 5/8" I.R.
- ◎ FD. 3/4" I.R.
- ○ FD. 5/8" I.R.
- ⊙ NOT SET OR FD.

REGISTERED PROFESSIONAL LAND SURVEYOR
OREGON JULY 5, 1960 EUGENE A. BLOOM 492

MAP FILE M-58-54