SURVEY TO SET PROPERTY CORNERS
IN D.L.C. NO. 55, & SEC. 28, T.28S, R.7W. W.M.
FOR: JOAN RICHARDSON
BY: BAUGHMAN SURVEYING SERVICE
OCTOBER 1973 SCALE: 1"=50'

COUNTY SURVEYORS FILE DATA
DO NOT REMOVE FROM OFFICE

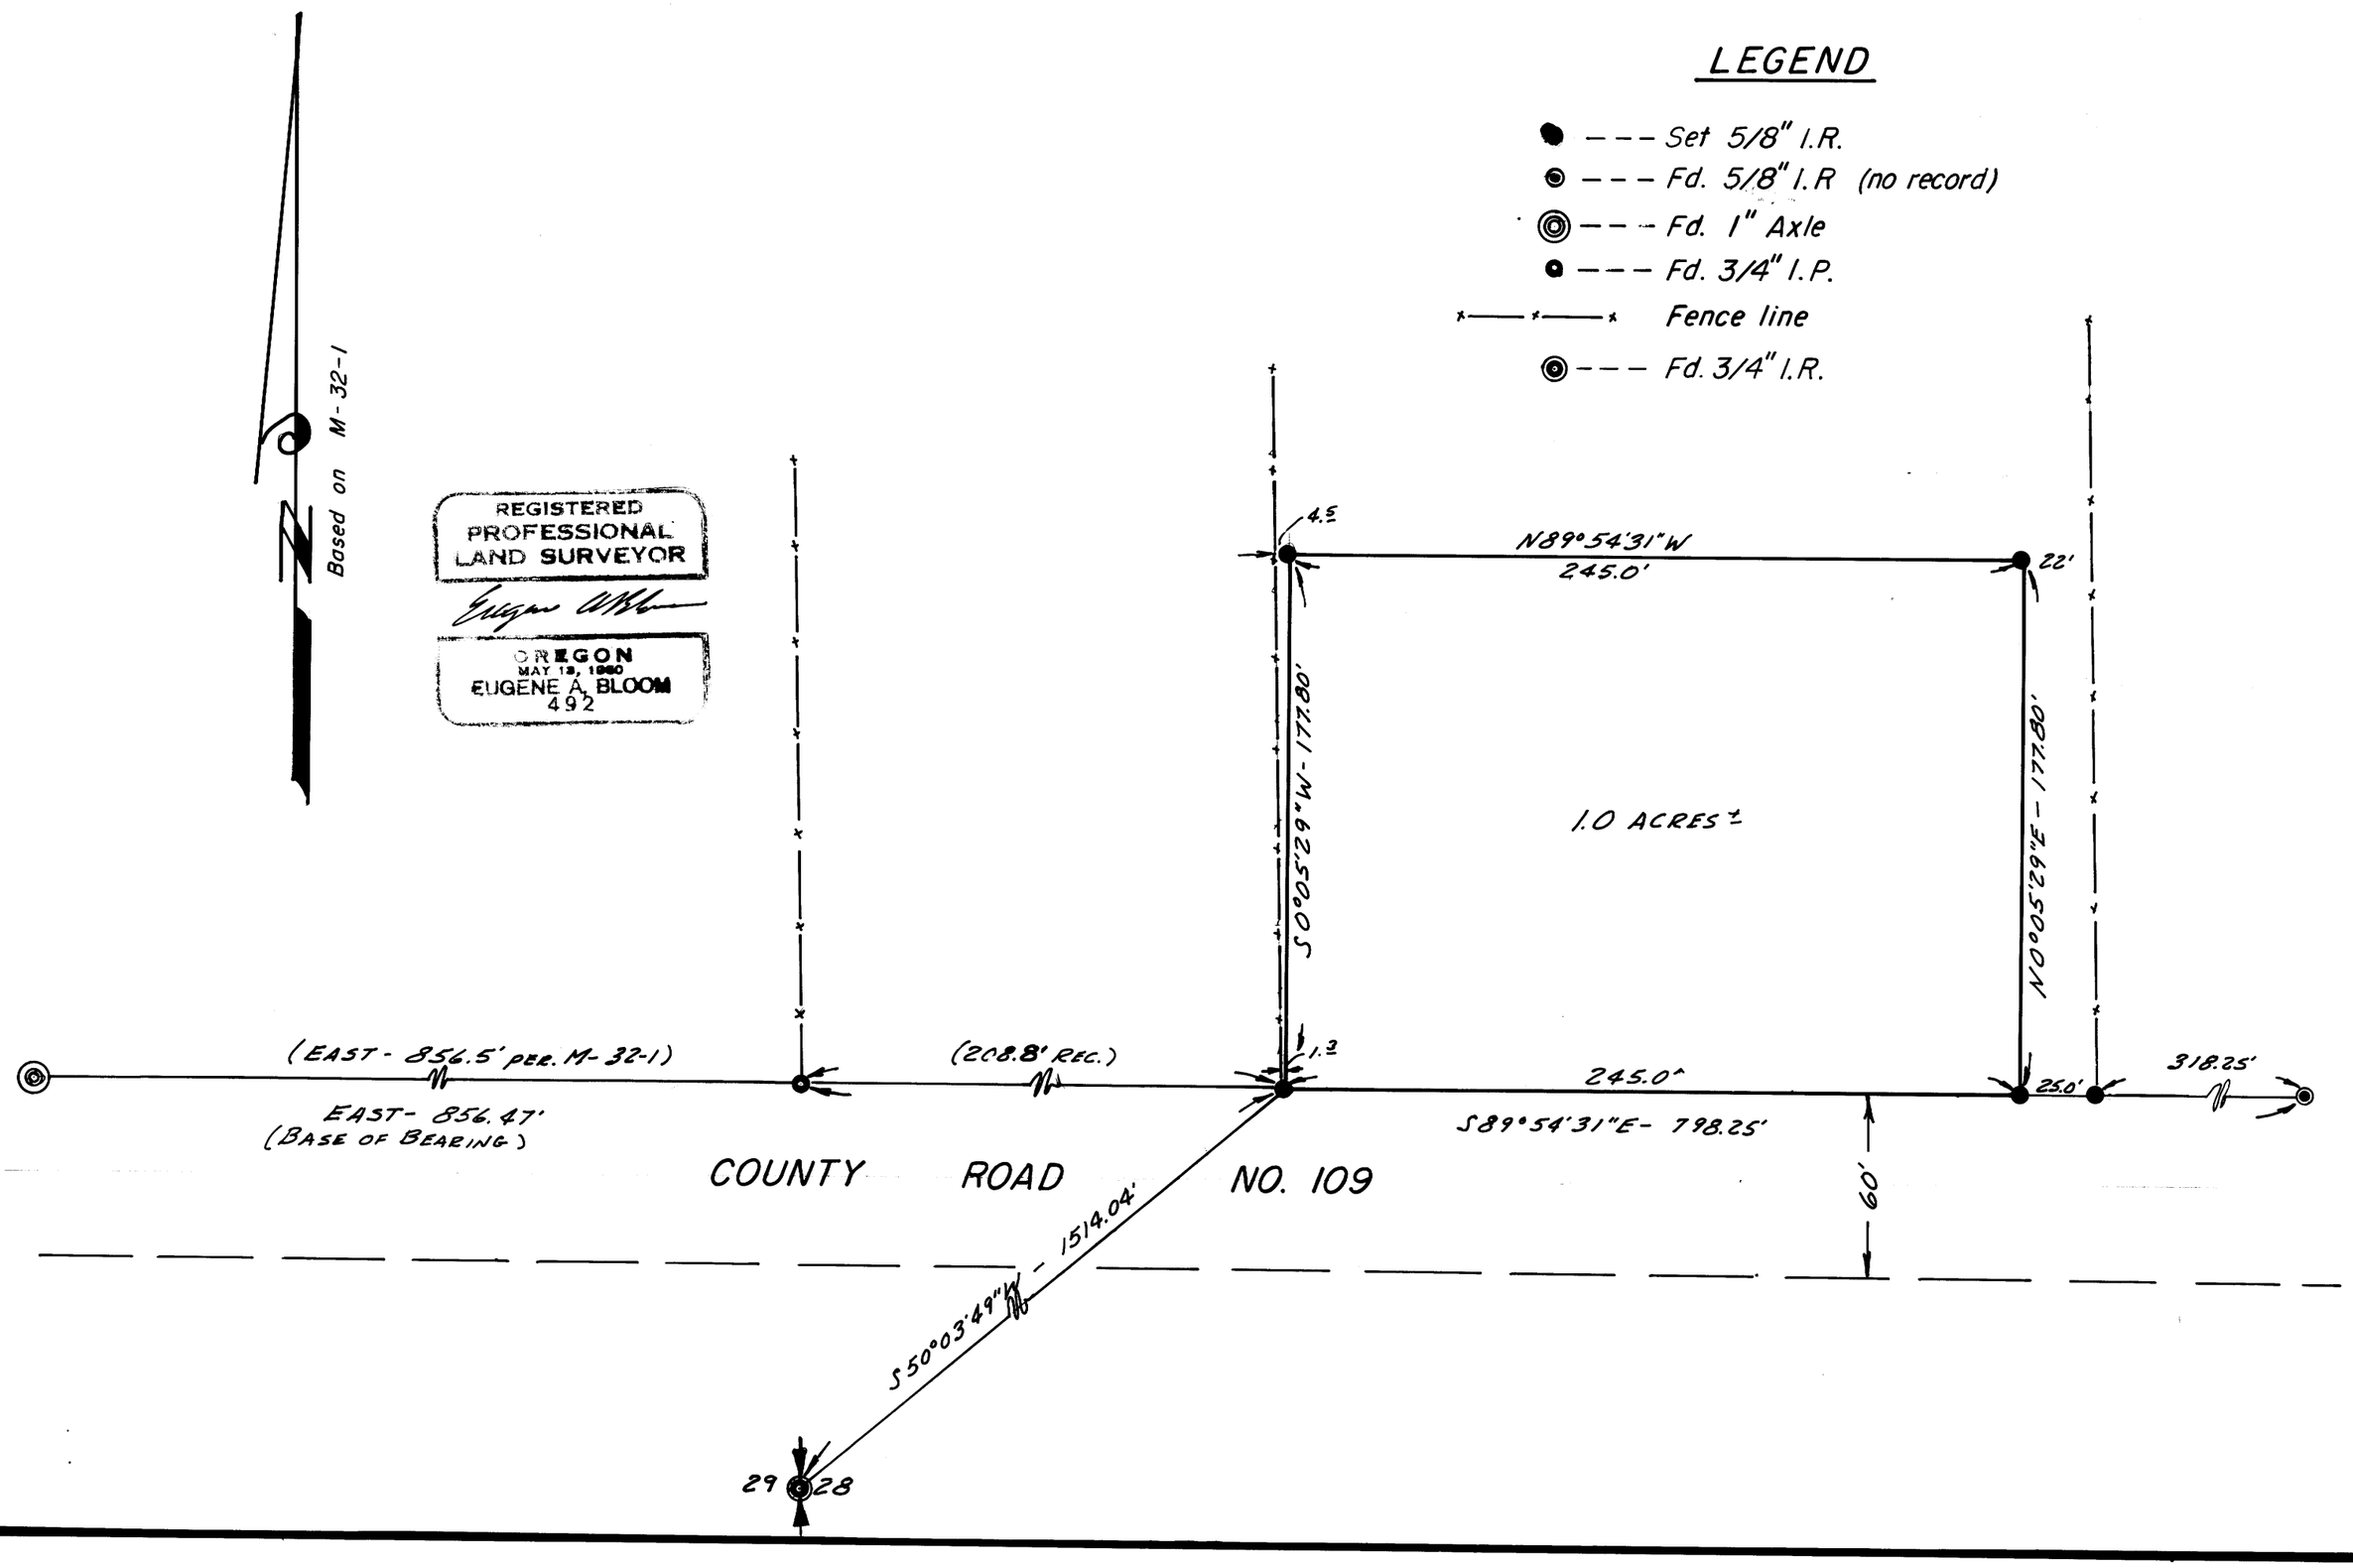

MAP FILE M51 - 29