COUNTY SURVEYORS FILE DATA
DO NOT REMOVE FROM OFFICE

SURVEY FOR PROPERTY CORNERS IN THE E. 1/2 SEC. 1, T. 28 S., R. 5 W., W.M. FOR W. F. BONEBRAKE BY BAUGHMAN SURVEYING SERVICE

SEPTEMBER 1973 SCALE 1" = 100'

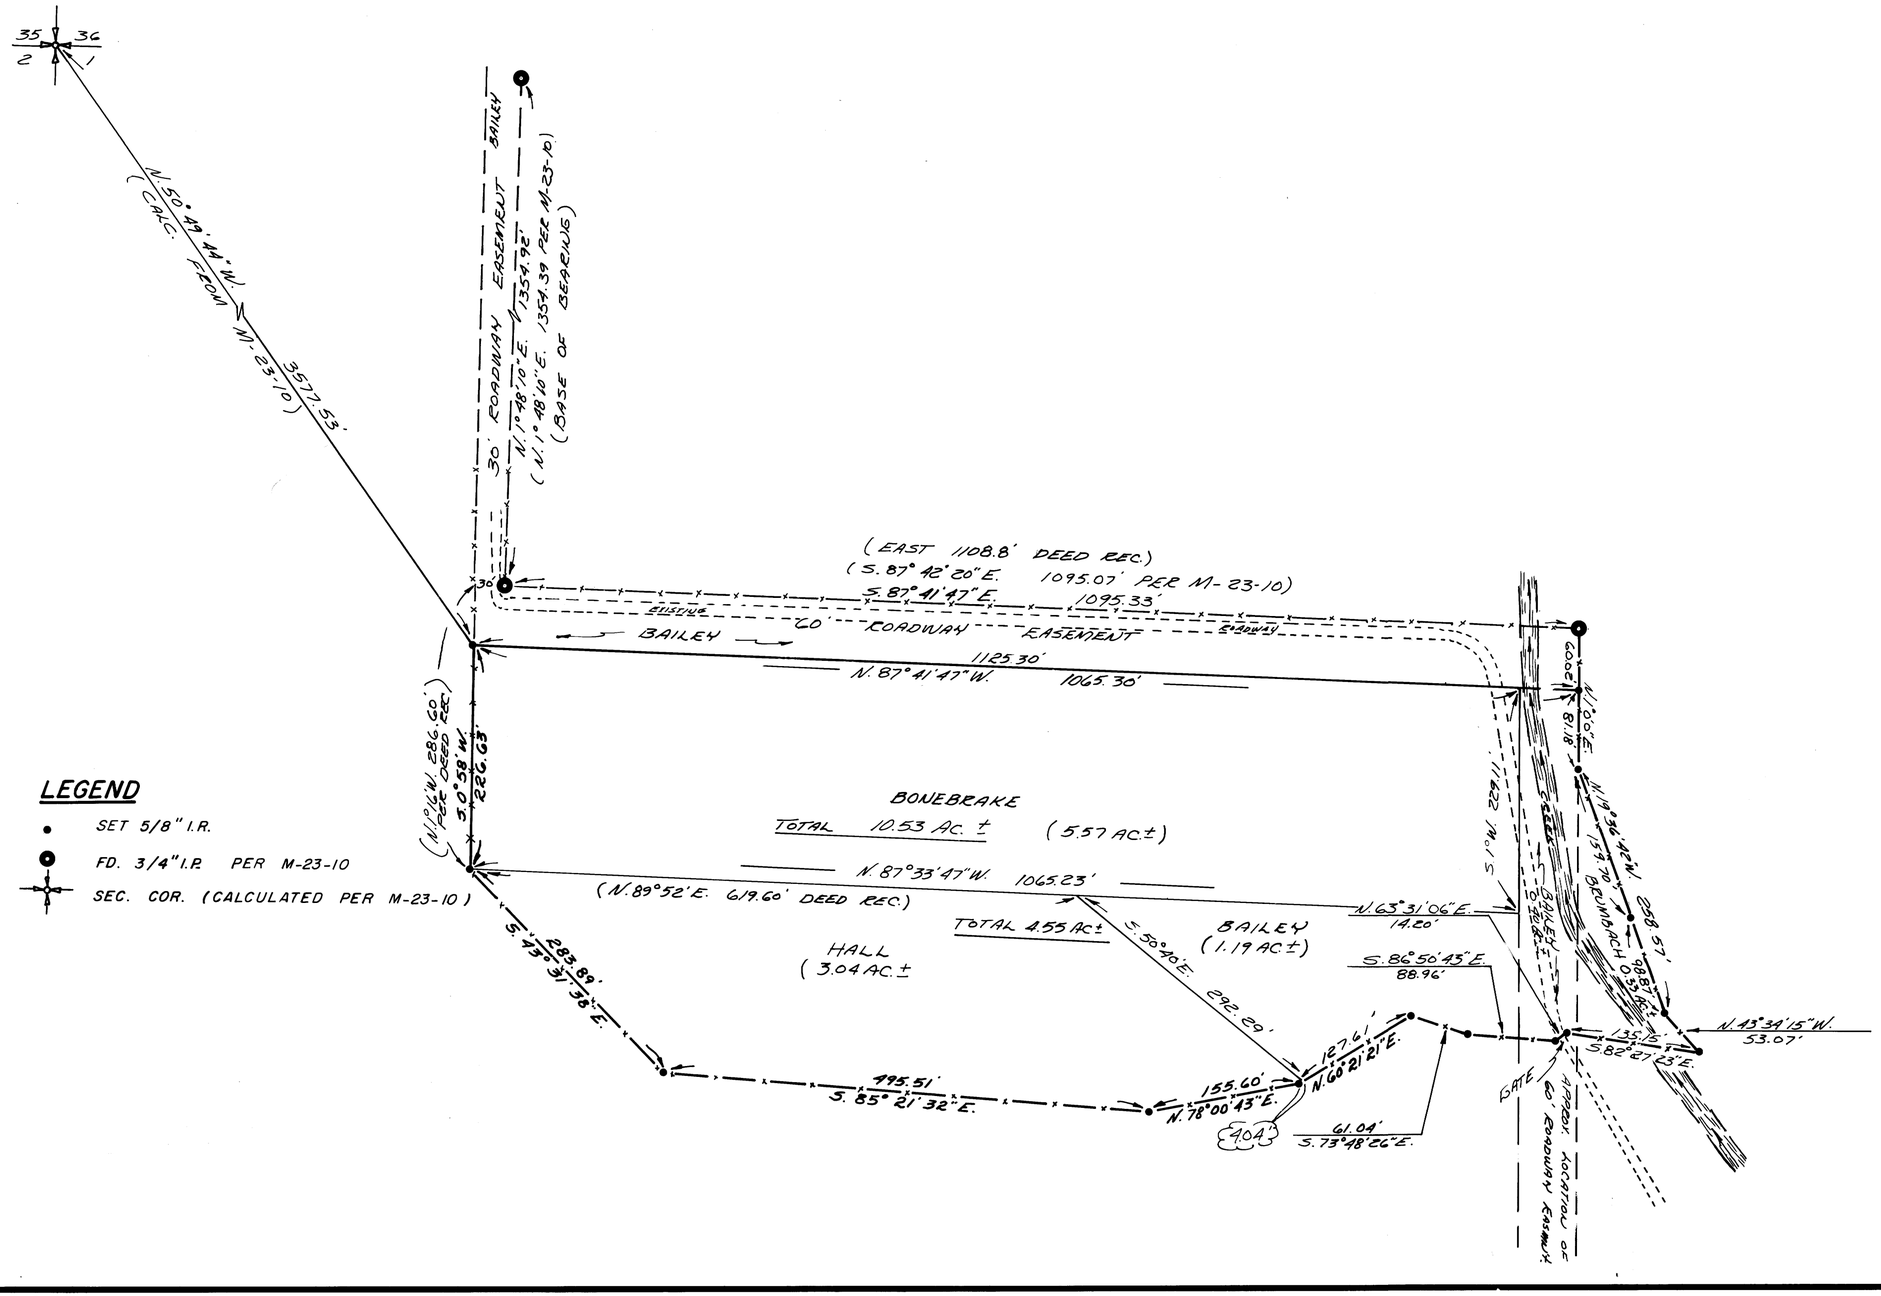

LEGEND

- SET 5/8" I.R.
- FD. 3/4" I.R. PER M-23-10
- SEC. COR. (CALCULATED PER M-23-10)

FILED
MAP F. M51-5
COUNTY SURVEYOR
TOUCHSTONE

PROFESSIONAL LAND SURVEYOR
OREGON