FILED
RECEIVED
DEC 10 1973
COUNTY SURVEYOR

MAP FILE M-51 - 61

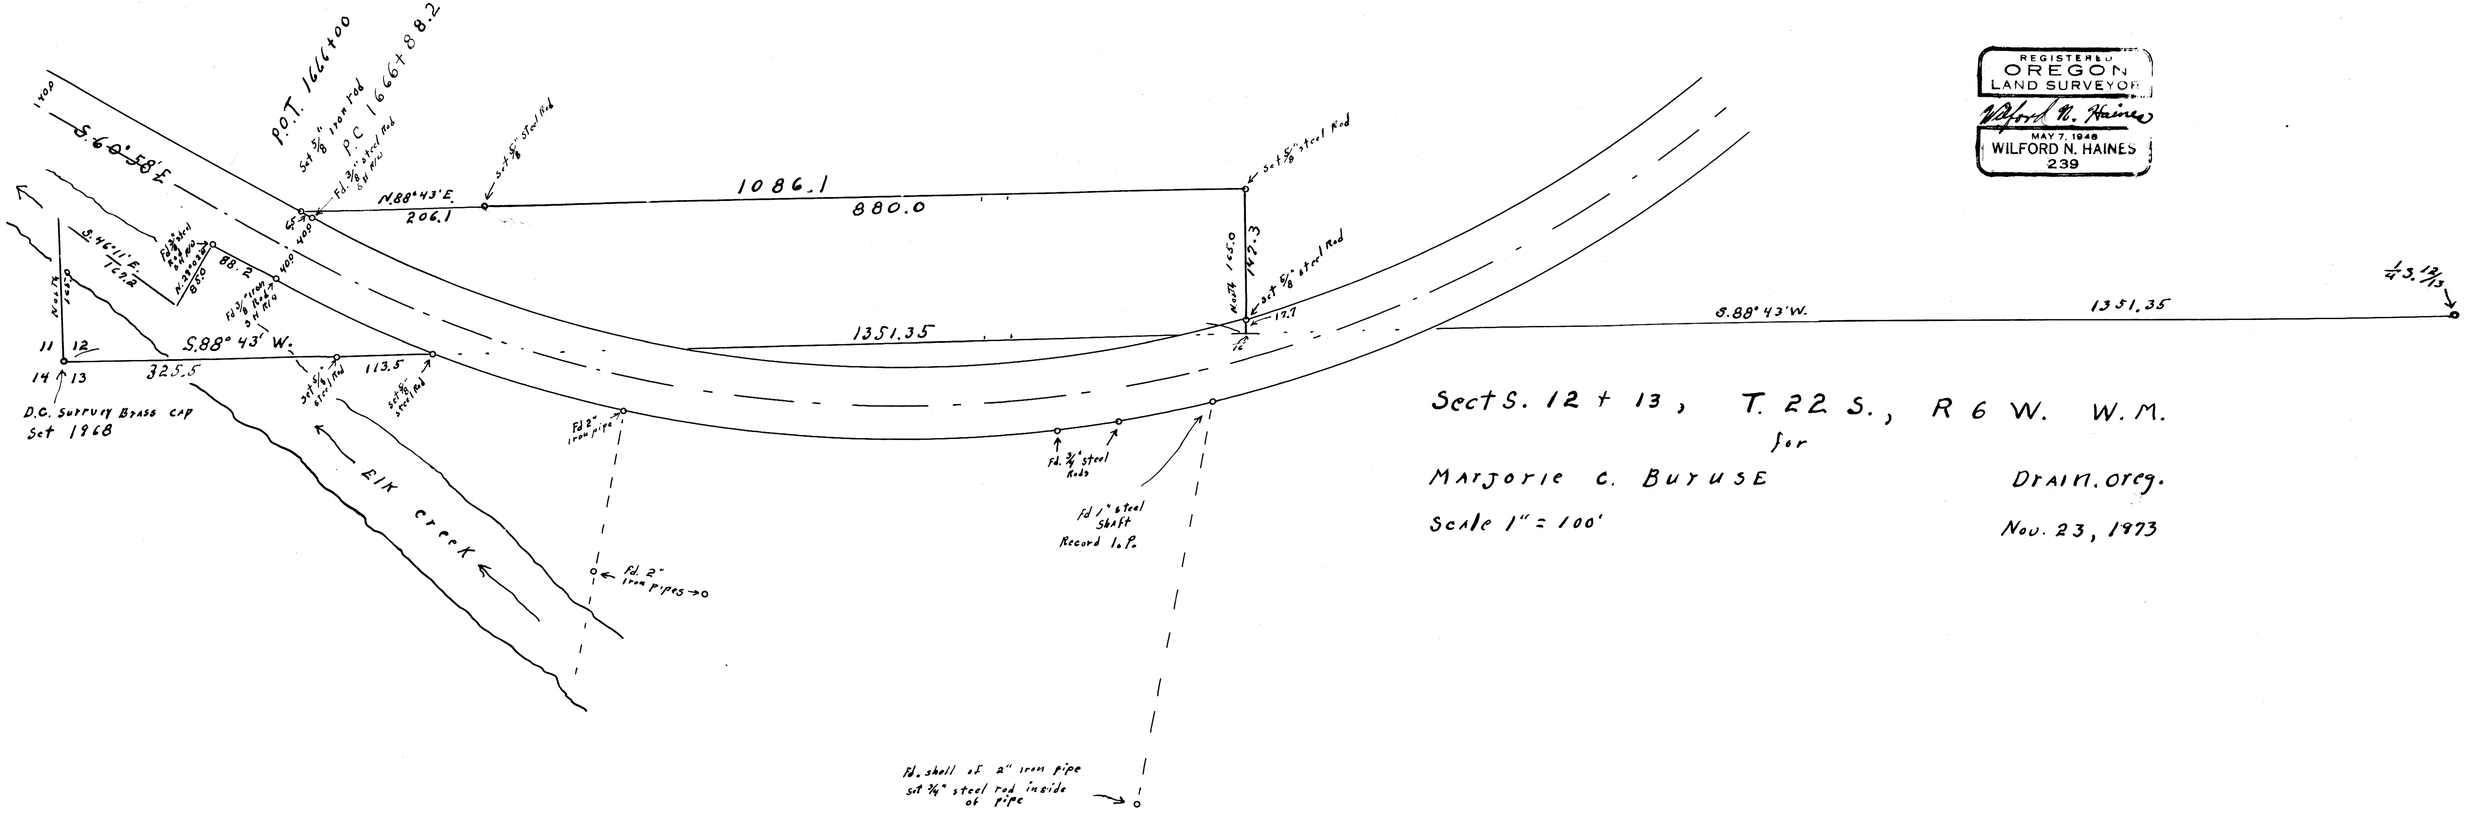

REGISTERED
OREGON
LAND SURVEYOR
Wilford N. Haines
MAY 7, 1948
WILFORD N. HAINES
239

Sect S. 12 + 13, T. 22 S., R 6 W. W.M.
for
Marjorie C. Buruse
Drain. oreg.
Scale 1" = 100'
Nov. 23, 1973

COUNTY SURVEYORS FILE DATA
DO NOT REMOVE FROM OFFICE

MAP FILE M-51 - 61