4L - 15W

COUNTY SURVEYORS FILE DATA
DO NOT REMOVE FROM OFFICE

SURVEY OF BLOCK 22, KINNEY'S IMPROVED PLAT TO CITY OF ROSEBURG TO LOCATE LOTS 5 + 6 SEC. 18, T27S, R5W, W.M. FOR MRS. JAS. G. OSBORNE, 477 N.E. JACKSON ST. ROSEBURG

BY HERBERT L. NORTHCRAFT SCALE 1"=50' NOV. 1973

FILED
RECEIVED
DEC 19 1973
COUNTY SURVEYOR
DOUGLAS COUNTY, ORE.

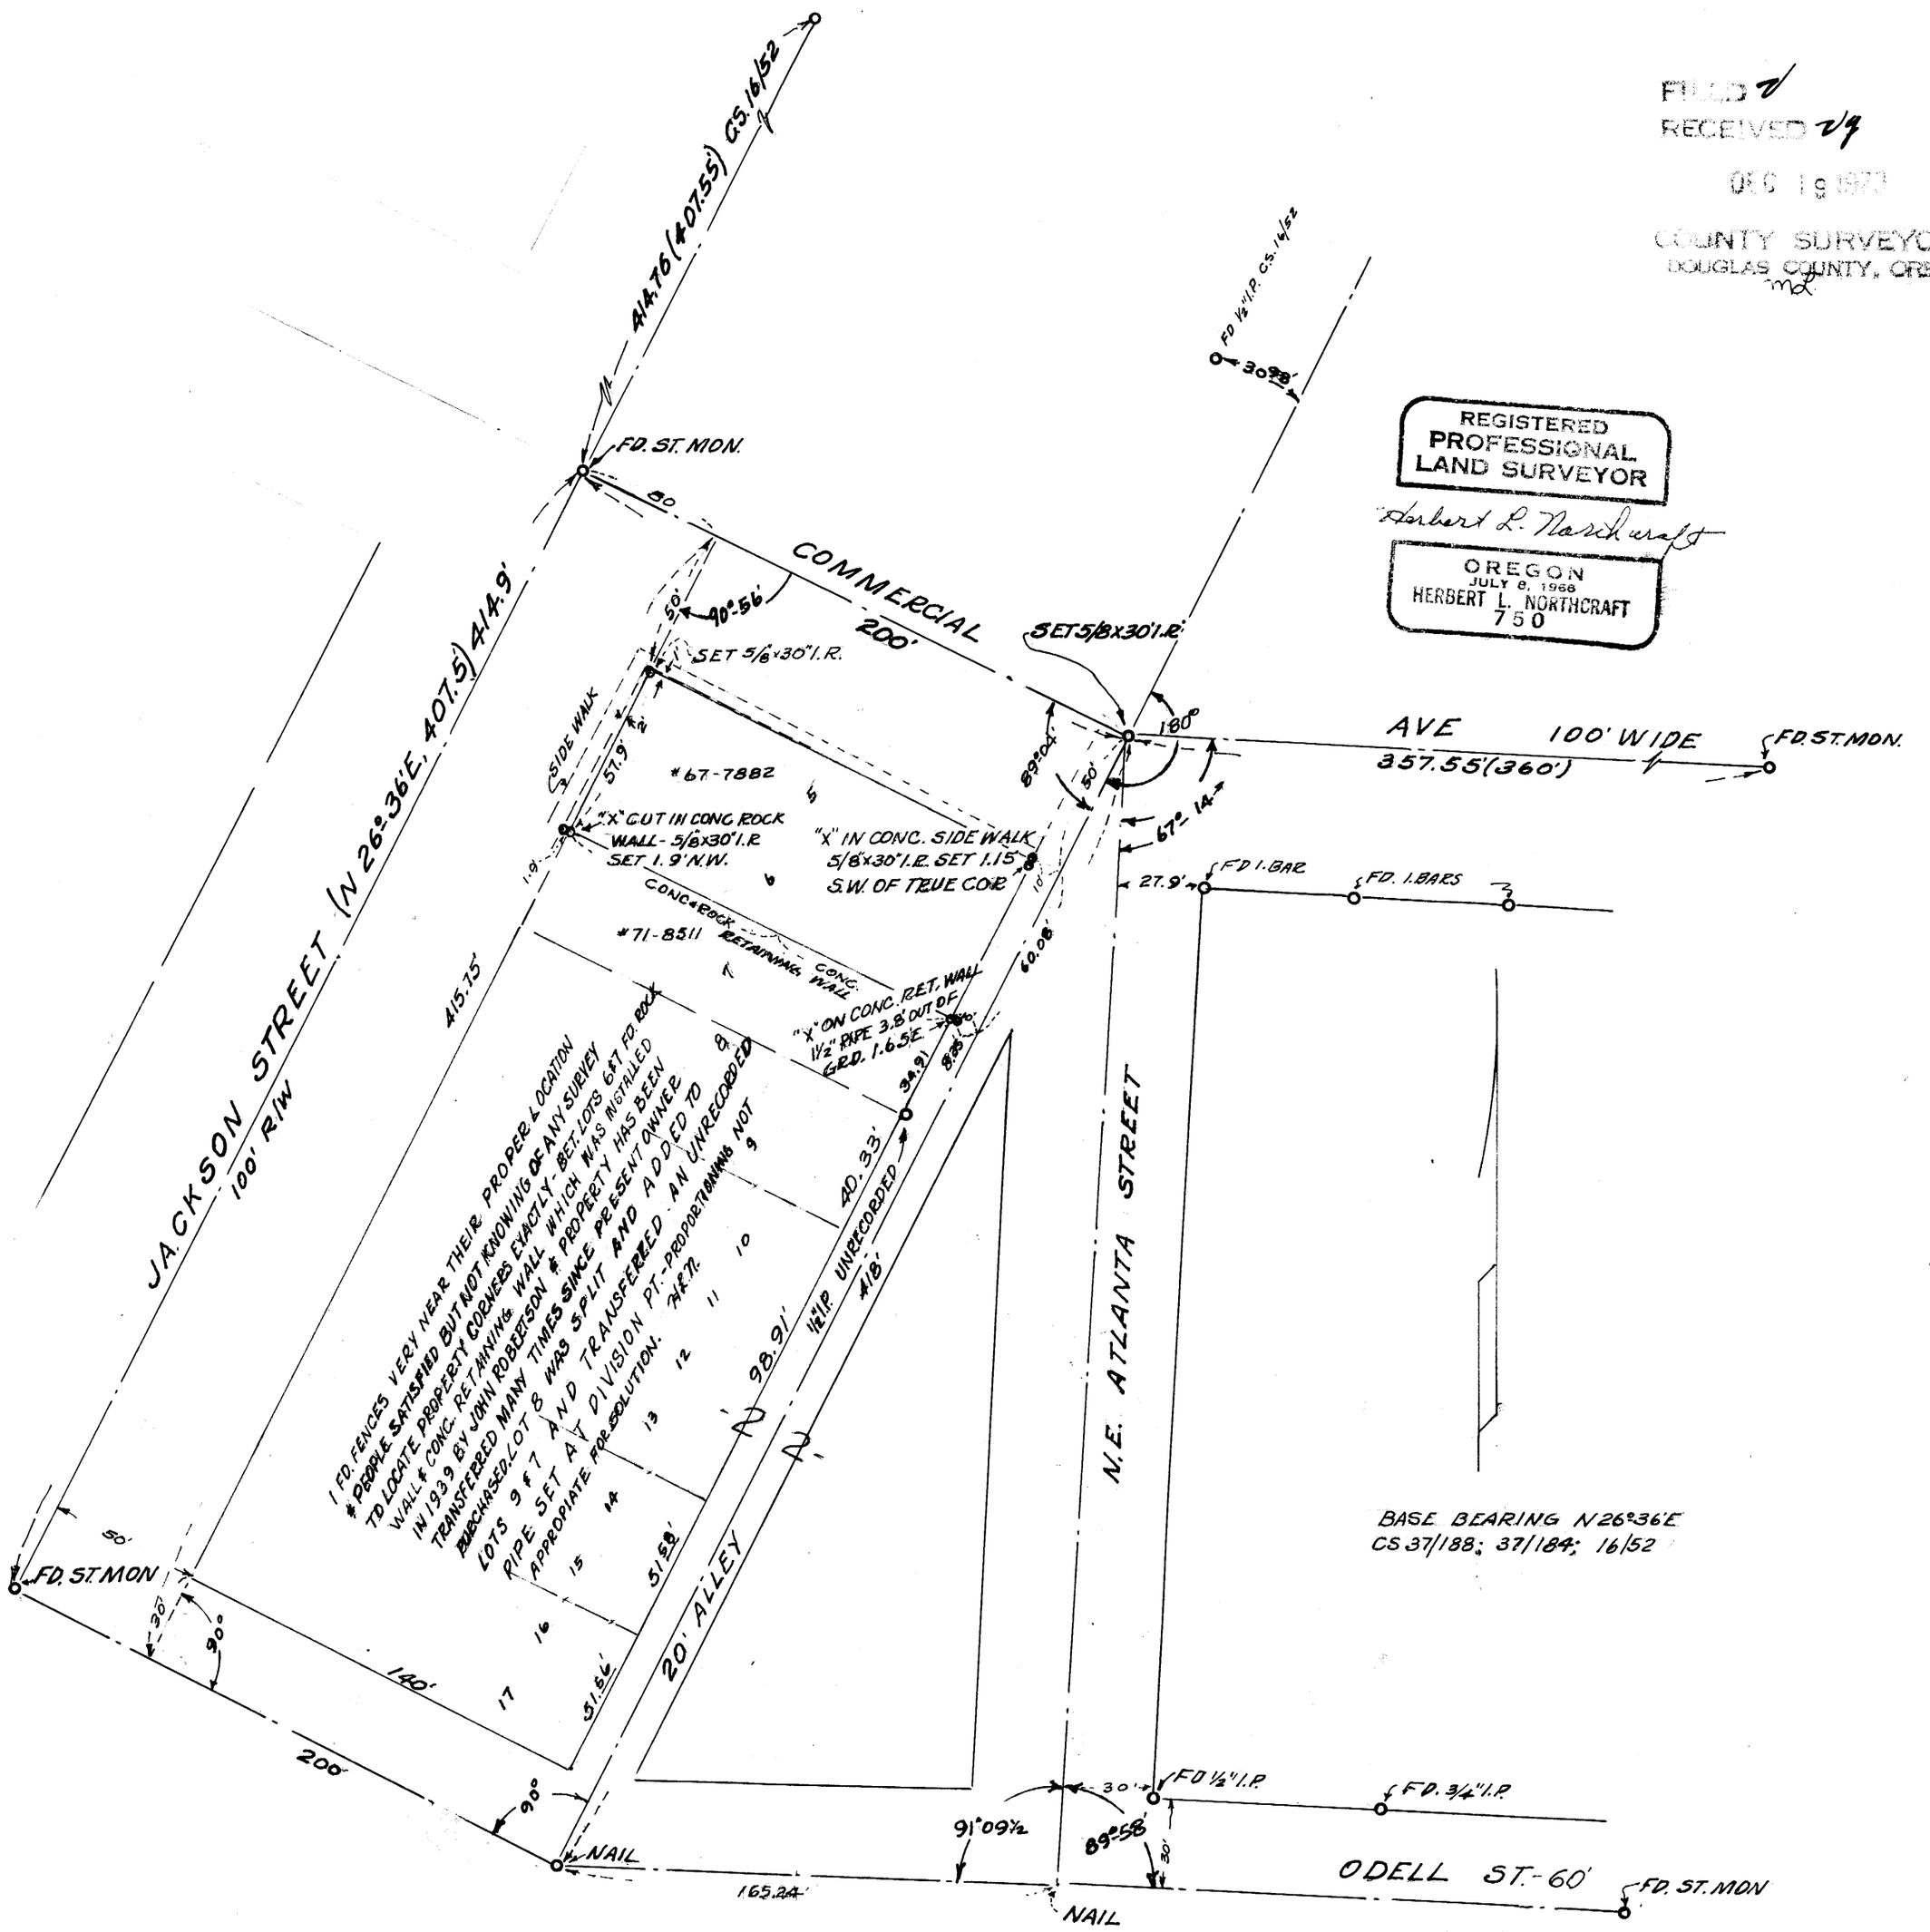

REGISTERED PROFESSIONAL LAND SURVEYOR
Herbert L. Northcraft
OREGON JULY 8, 1966
HERBERT L. NORTHCRAFT
750

MAP FILE M51 - 74