COUNTY SURVEYORS FILE DATA
DO NOT REMOVE FROM OFFICE

FILED
RECEIVED
OCT 8 1973
COUNTY SURVEYOR
DOUGLAS COUNTY, ORE.

MAP FILE M51 - 8

SURVEY TO SHOW 4.02 ACRE PARCEL TO BE CONVEYED FROM LEGORE TO OAKLAND SCHOOL DISTRICT

LOCATED IN SECTION 4, T25S, R5W, WM

FOR TED LEGORE

OCT. 1973

BY HAROLD BALL - CIVIL ENGINEER - ROSEBURG, OREGON

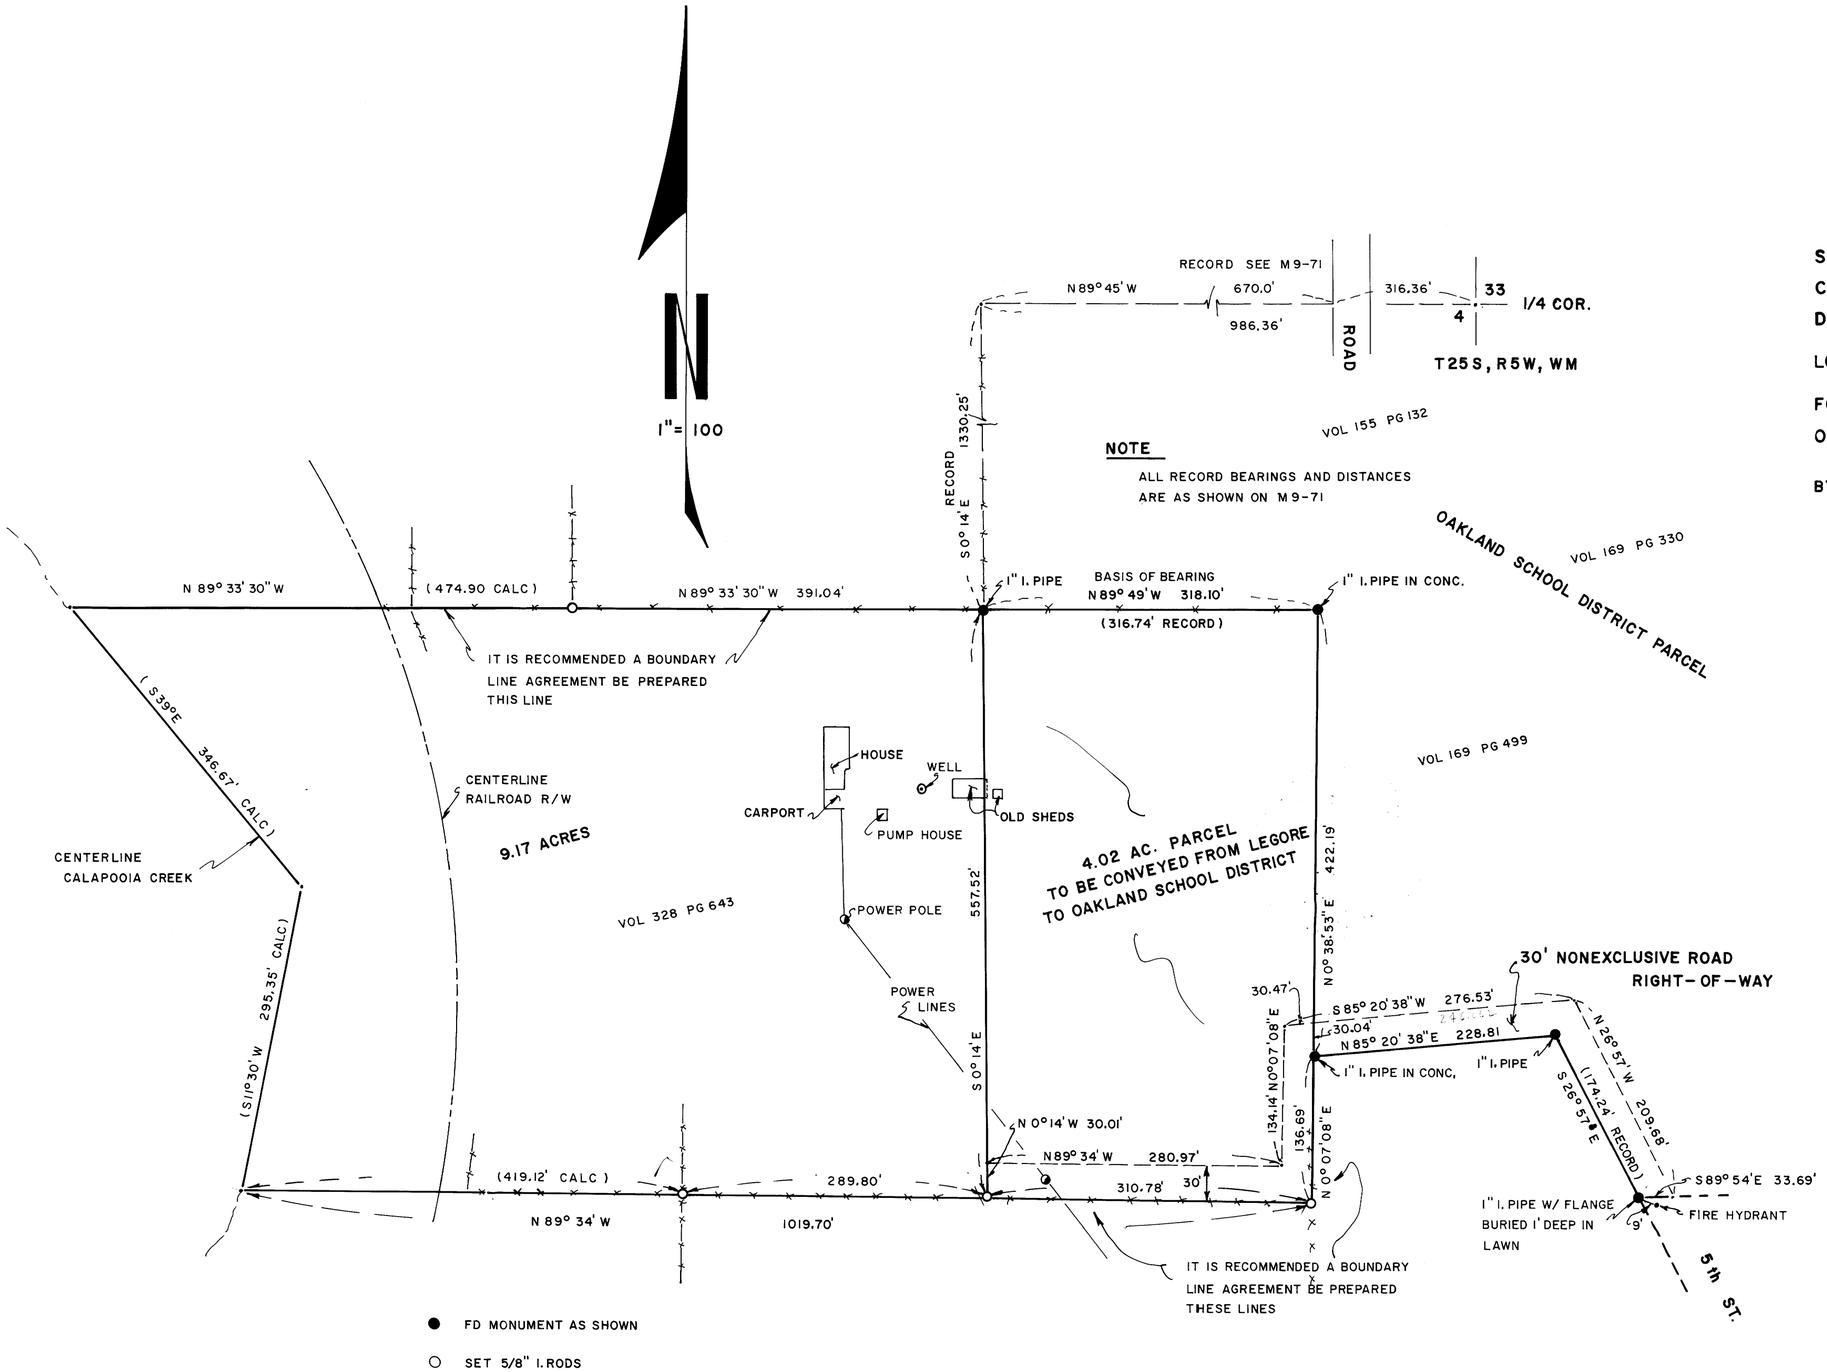

REGISTERED PROFESSIONAL ENGINEER
6025
Harold L. Ball
OREGON
SEPT. 8, 1967
HAROLD L. BALL

MAP FILE M51 - 8