SURVEY IN SECTIONS 21 & 22, TOWNSHIP 27 SOUTH, RANGE 6 WEST, WILLAMETTE MERIDIAN

Surveyed for John Busenbark by Don E. Garrett

December, 1973

COUNTY SURVEYORS FILE DATA
DO NOT REMOVE FROM OFFICE

Scale 1" = 300'

FILED
RECEIVED
JUL 14 1974
COUNTY SURVEYOR

MAP FILE MS2-14

○ Found 5/8" Iron Rod
● Set 5/8" Iron Rod
Bearings based on Solar Observation taken 12/11/73

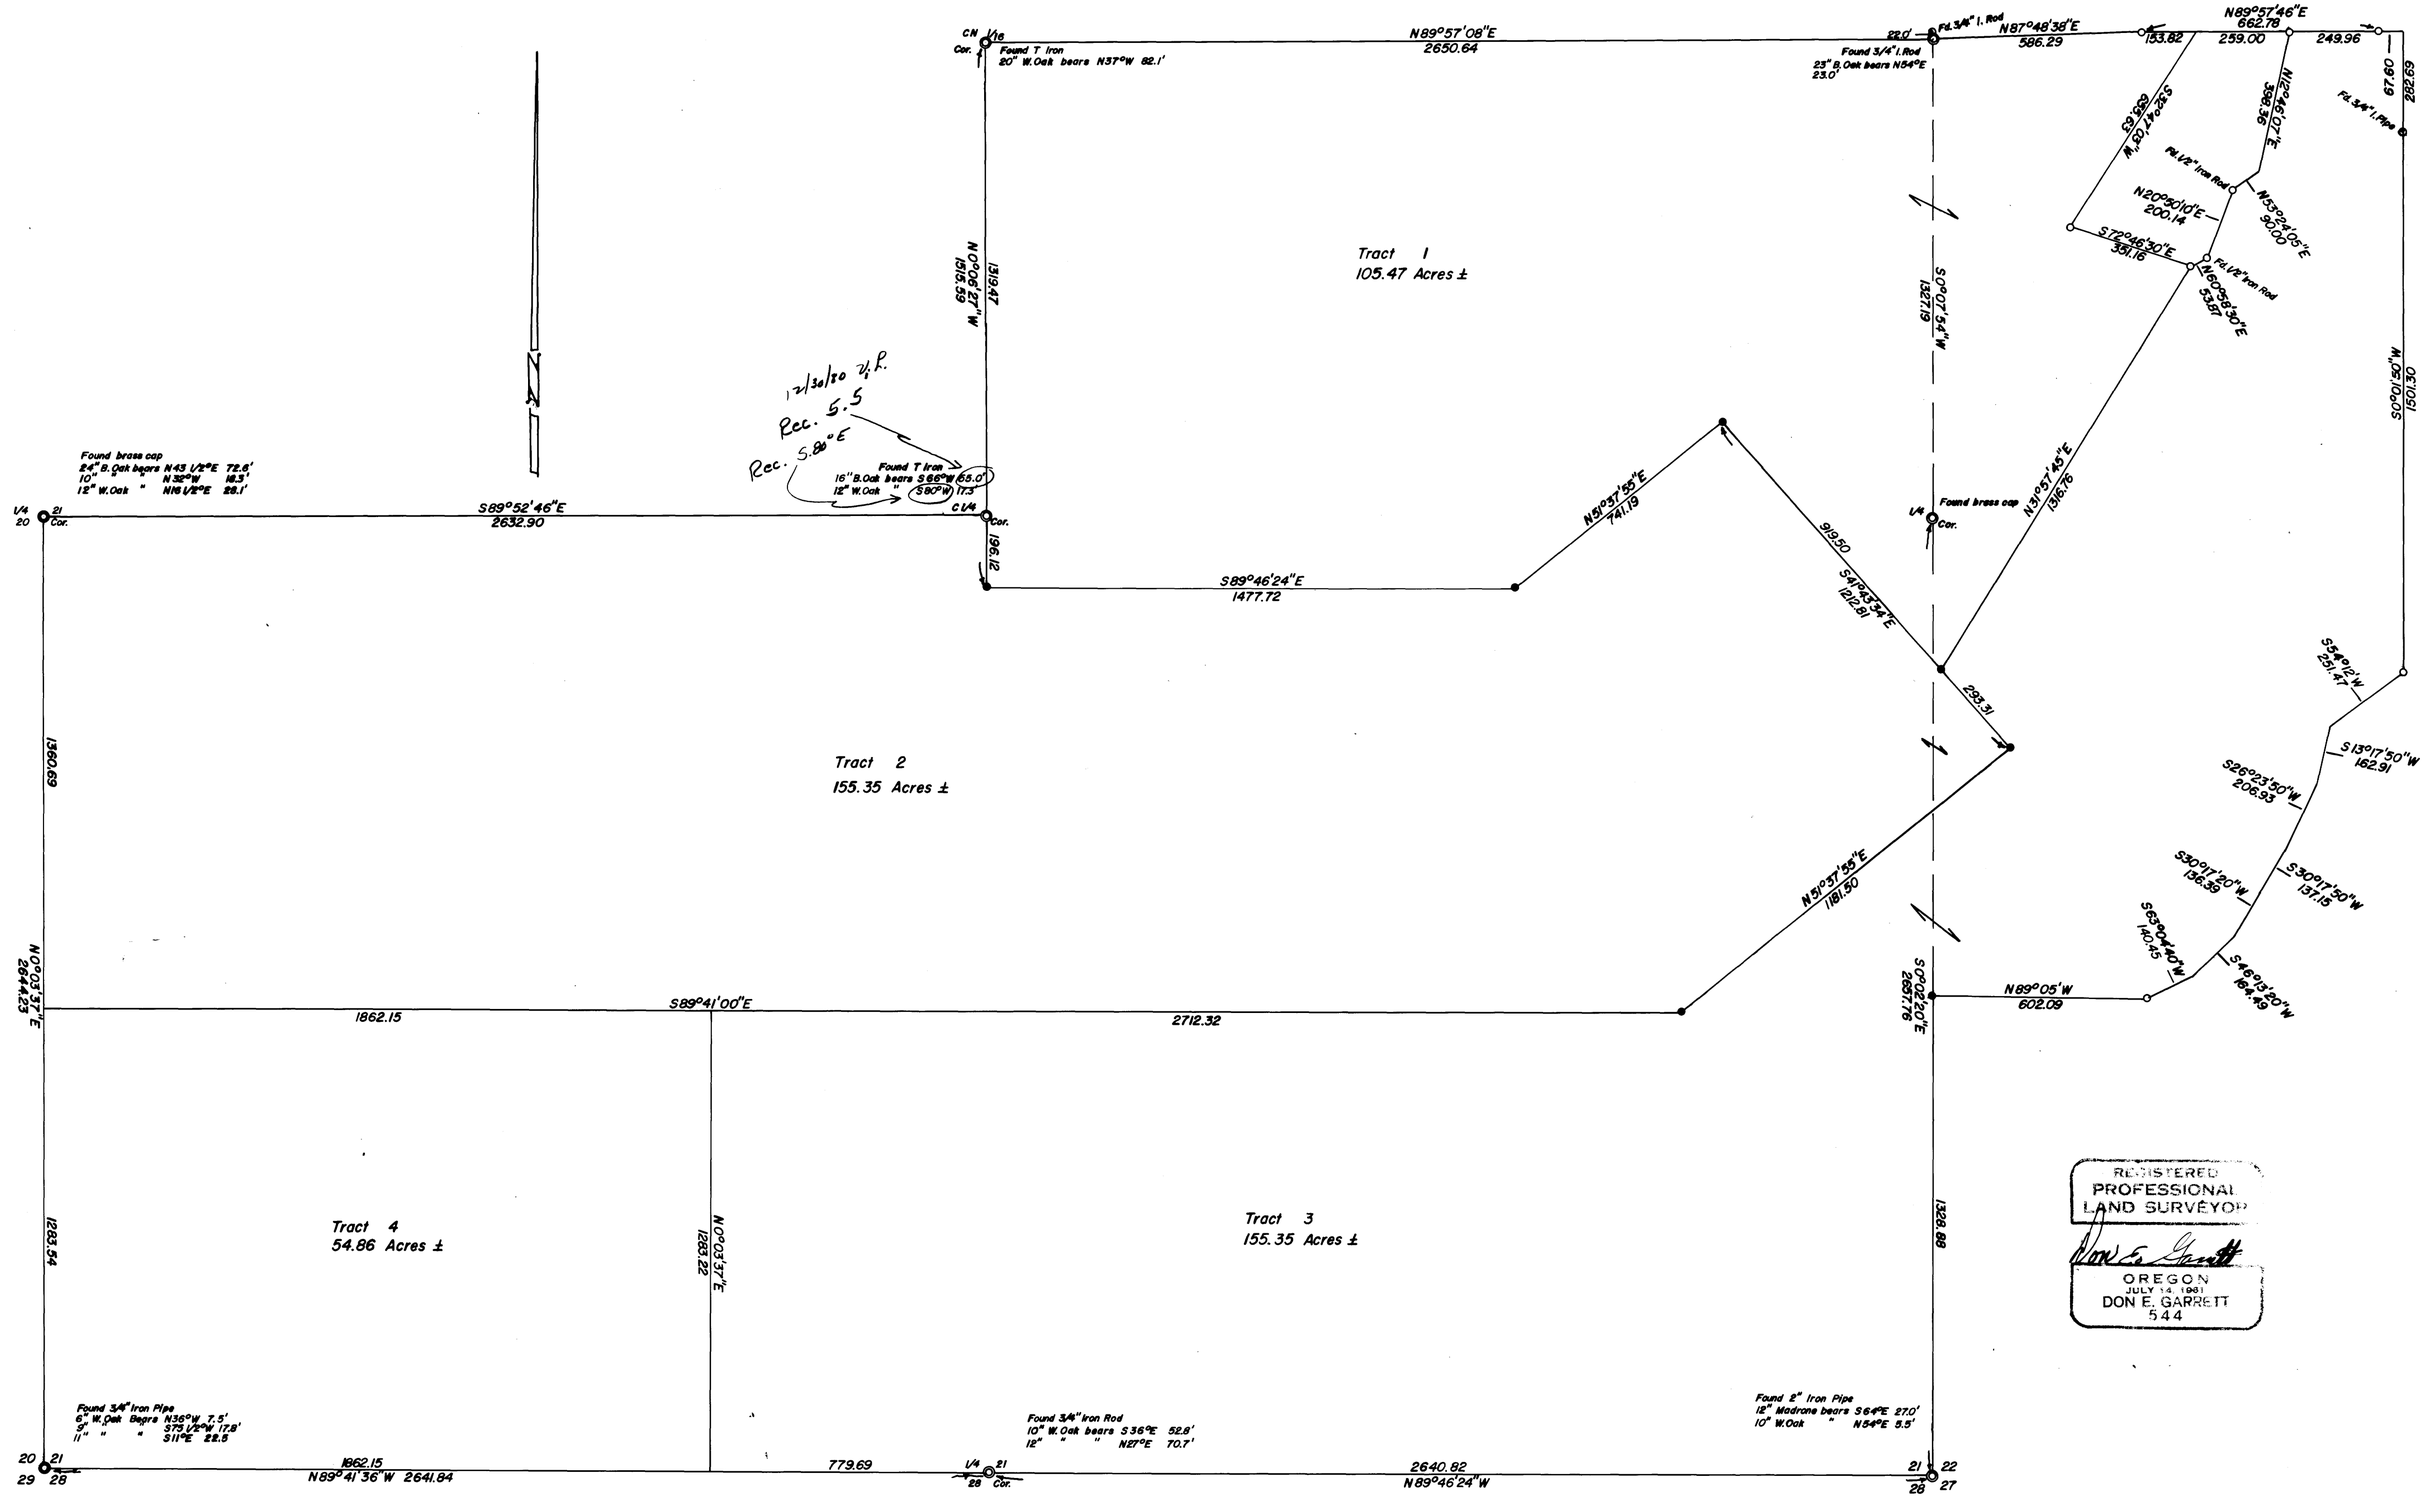

12/30/80 V.F.
Rec. 5.5
Rec. S.80°E

REGISTERED
PROFESSIONAL
LAND SURVEYOR
Don E. Garrett
OREGON
JULY 14, 1981
DON E. GARRETT
544

MAP FILE MS2-14