COUNTY SURVEYORS FILE DATA
DO NOT REMOVE FROM OFFICE

SURVEY IN SECTION 12, TOWNSHIP 24 SOUTH, RANGE 7 WEST, WILLAMETTE MER.

Surveyed for James Newkirk by Don E. Garrett

January, 1974

This survey expressly for mortgage purposes

Scale 1" = 100'

FILED
RECEIVED
JAN 21 '74
COUNTY SURVEYOR
DOUGLAS COUNTY, ORE.

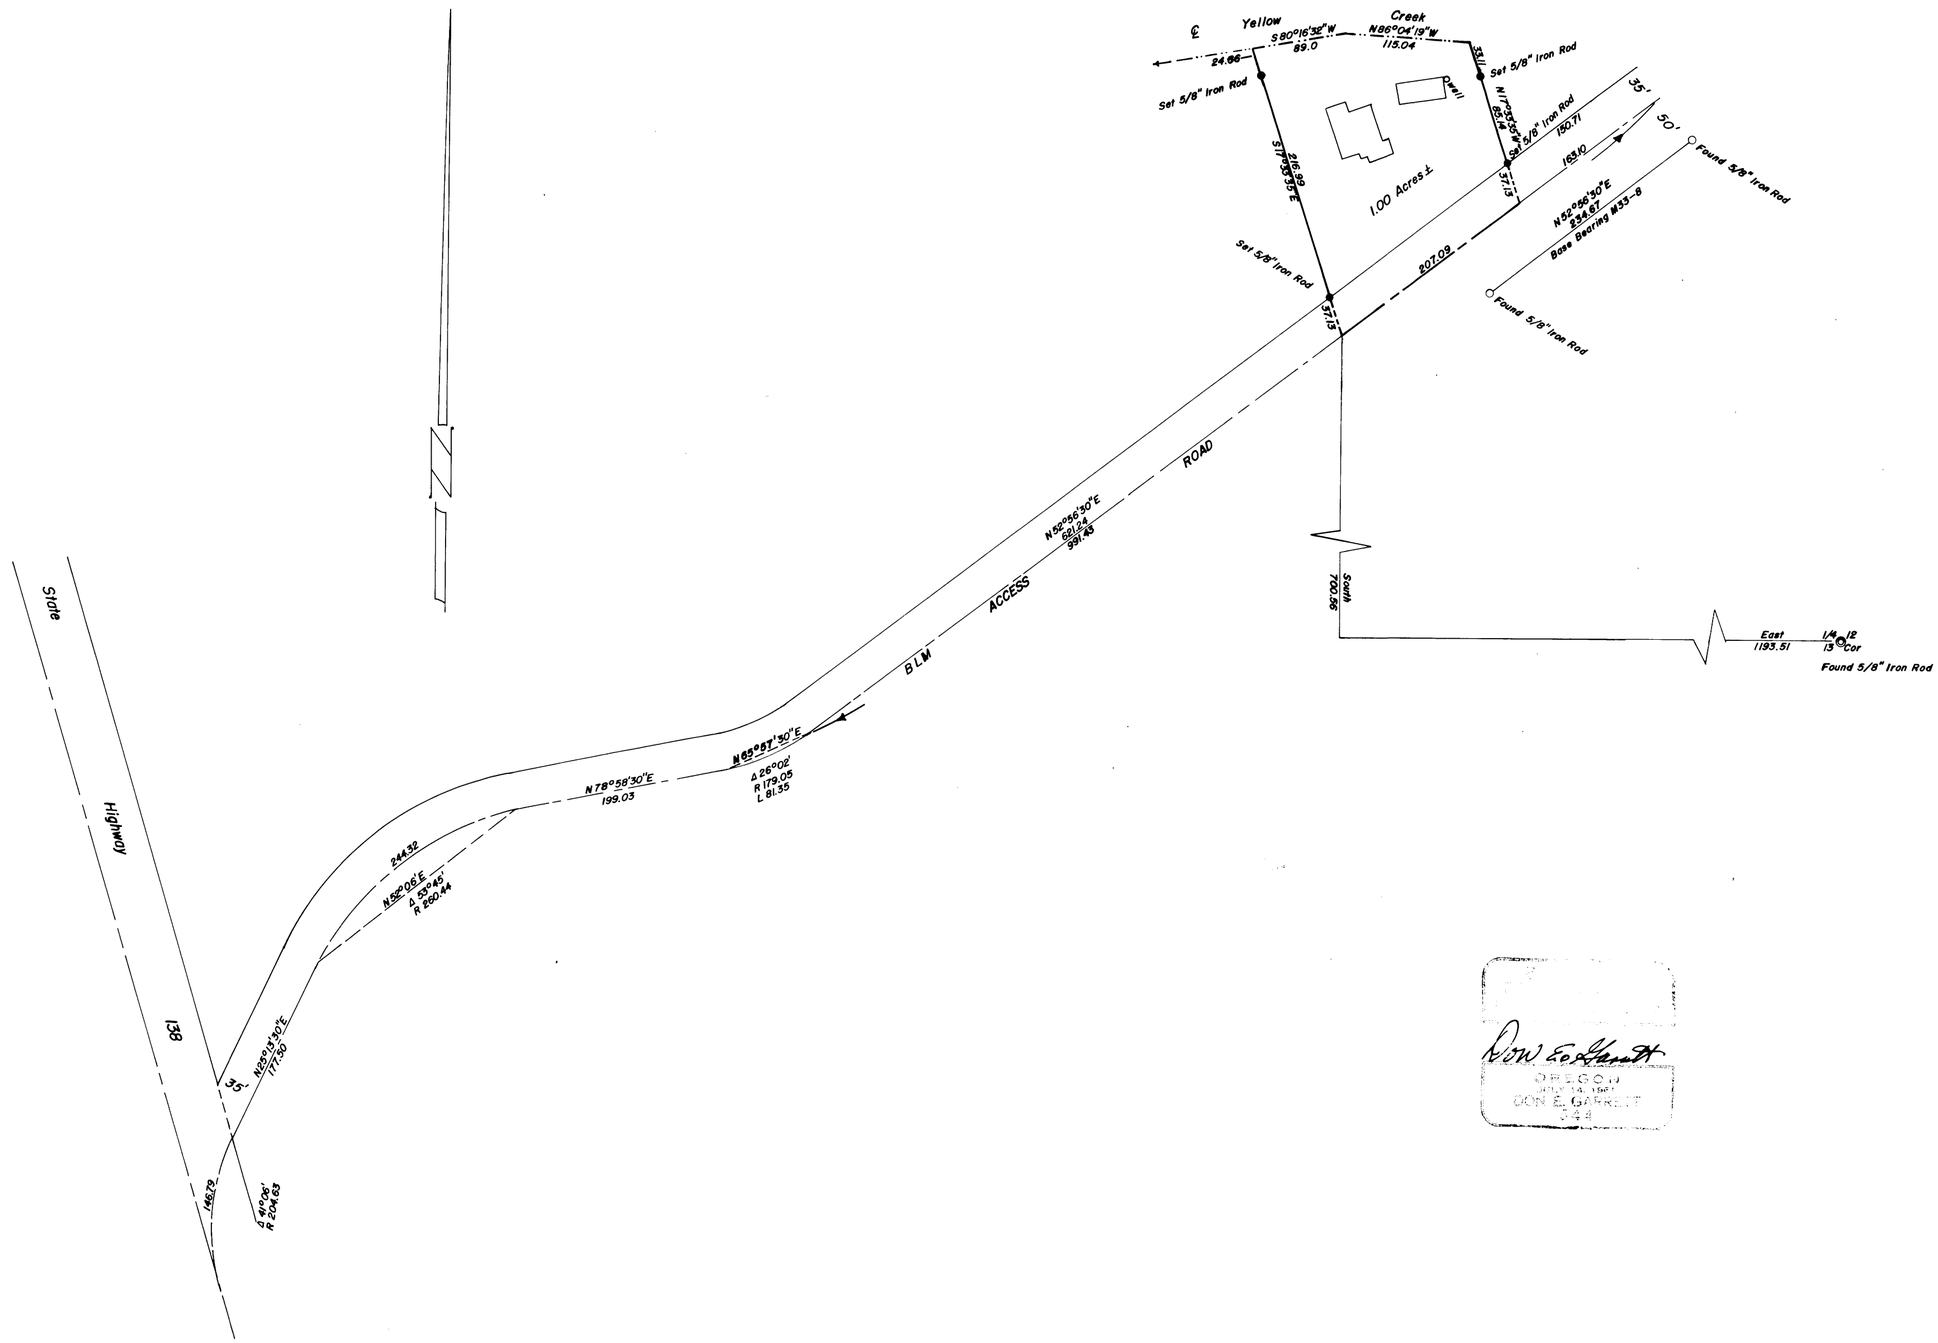

Don E. Garrett
OREGON
JAN 14 1974
DON E. GARRETT
344

MAP FILE M52 - 23