COUNTY SURVEYORS FILE DATA
DO NOT REMOVE FROM OFFICE

# SURVEY TO SET PROPERTY LINES IN BLOCK 2, NEUNER & ANDRIES ADD.

## ROSEBURG, OREGON.

## SEC. 18, T27S, R5W. W.M.

FILED ✓
RECEIVED Pd
FEB 21 1974
COUNTY SURVEYOR
DOUGLAS COUNTY, ORE.

SURVEYED FOR - STEVE FOWLER — FEB. 1974

SURVEYED BY - W.S. BARNES — SCALE 1"=50'

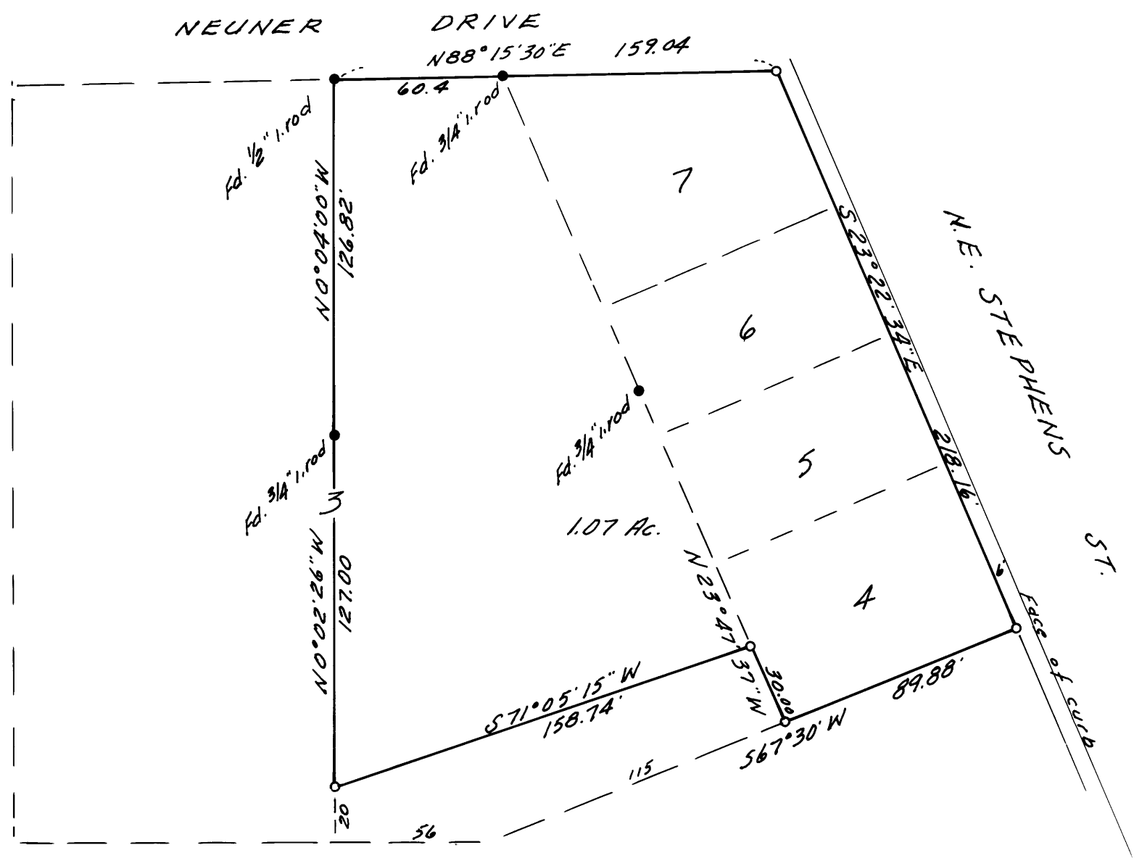


To Whom It May Concern

I recommend that the property lines shown hereon be confirmed by exchange of quit claim deeds or by boundary line agreements.

W. S. Barnes

• Monuments found.

○ 5/8" iron rods set.

Base bearing taken from west property line, see C.S.M.F. 42/351

Refr. C.S.M.F 42/351 & 42/352.

REGISTERED PROFESSIONAL ENGINEER 2128 OREGON SEPT 5 1941 William S. Barnes

W. S. Barnes

MAP FILE M52-38