COUNTY SURVEYORS FILE DATA
DO NOT REMOVE FROM OFFICE

SURVEY IN SECTION 13, TOWNSHIP 27 SOUTH, RANGE 5 WEST, WILLAMETTE MERIDIAN

Surveyed for Pete Serafin by Don E. Garrett

February, 1974

Scale 1" = 200'

○ Set 5/8" I. Rod
● Fd. 5/8" I. Rod
Section corner 13, 14, 23, 24 set by double proportion method

FILED
RECEIVED
MAR 1
COUNTY SURVEYOR
DOUGLAS COUNTY, OREG.

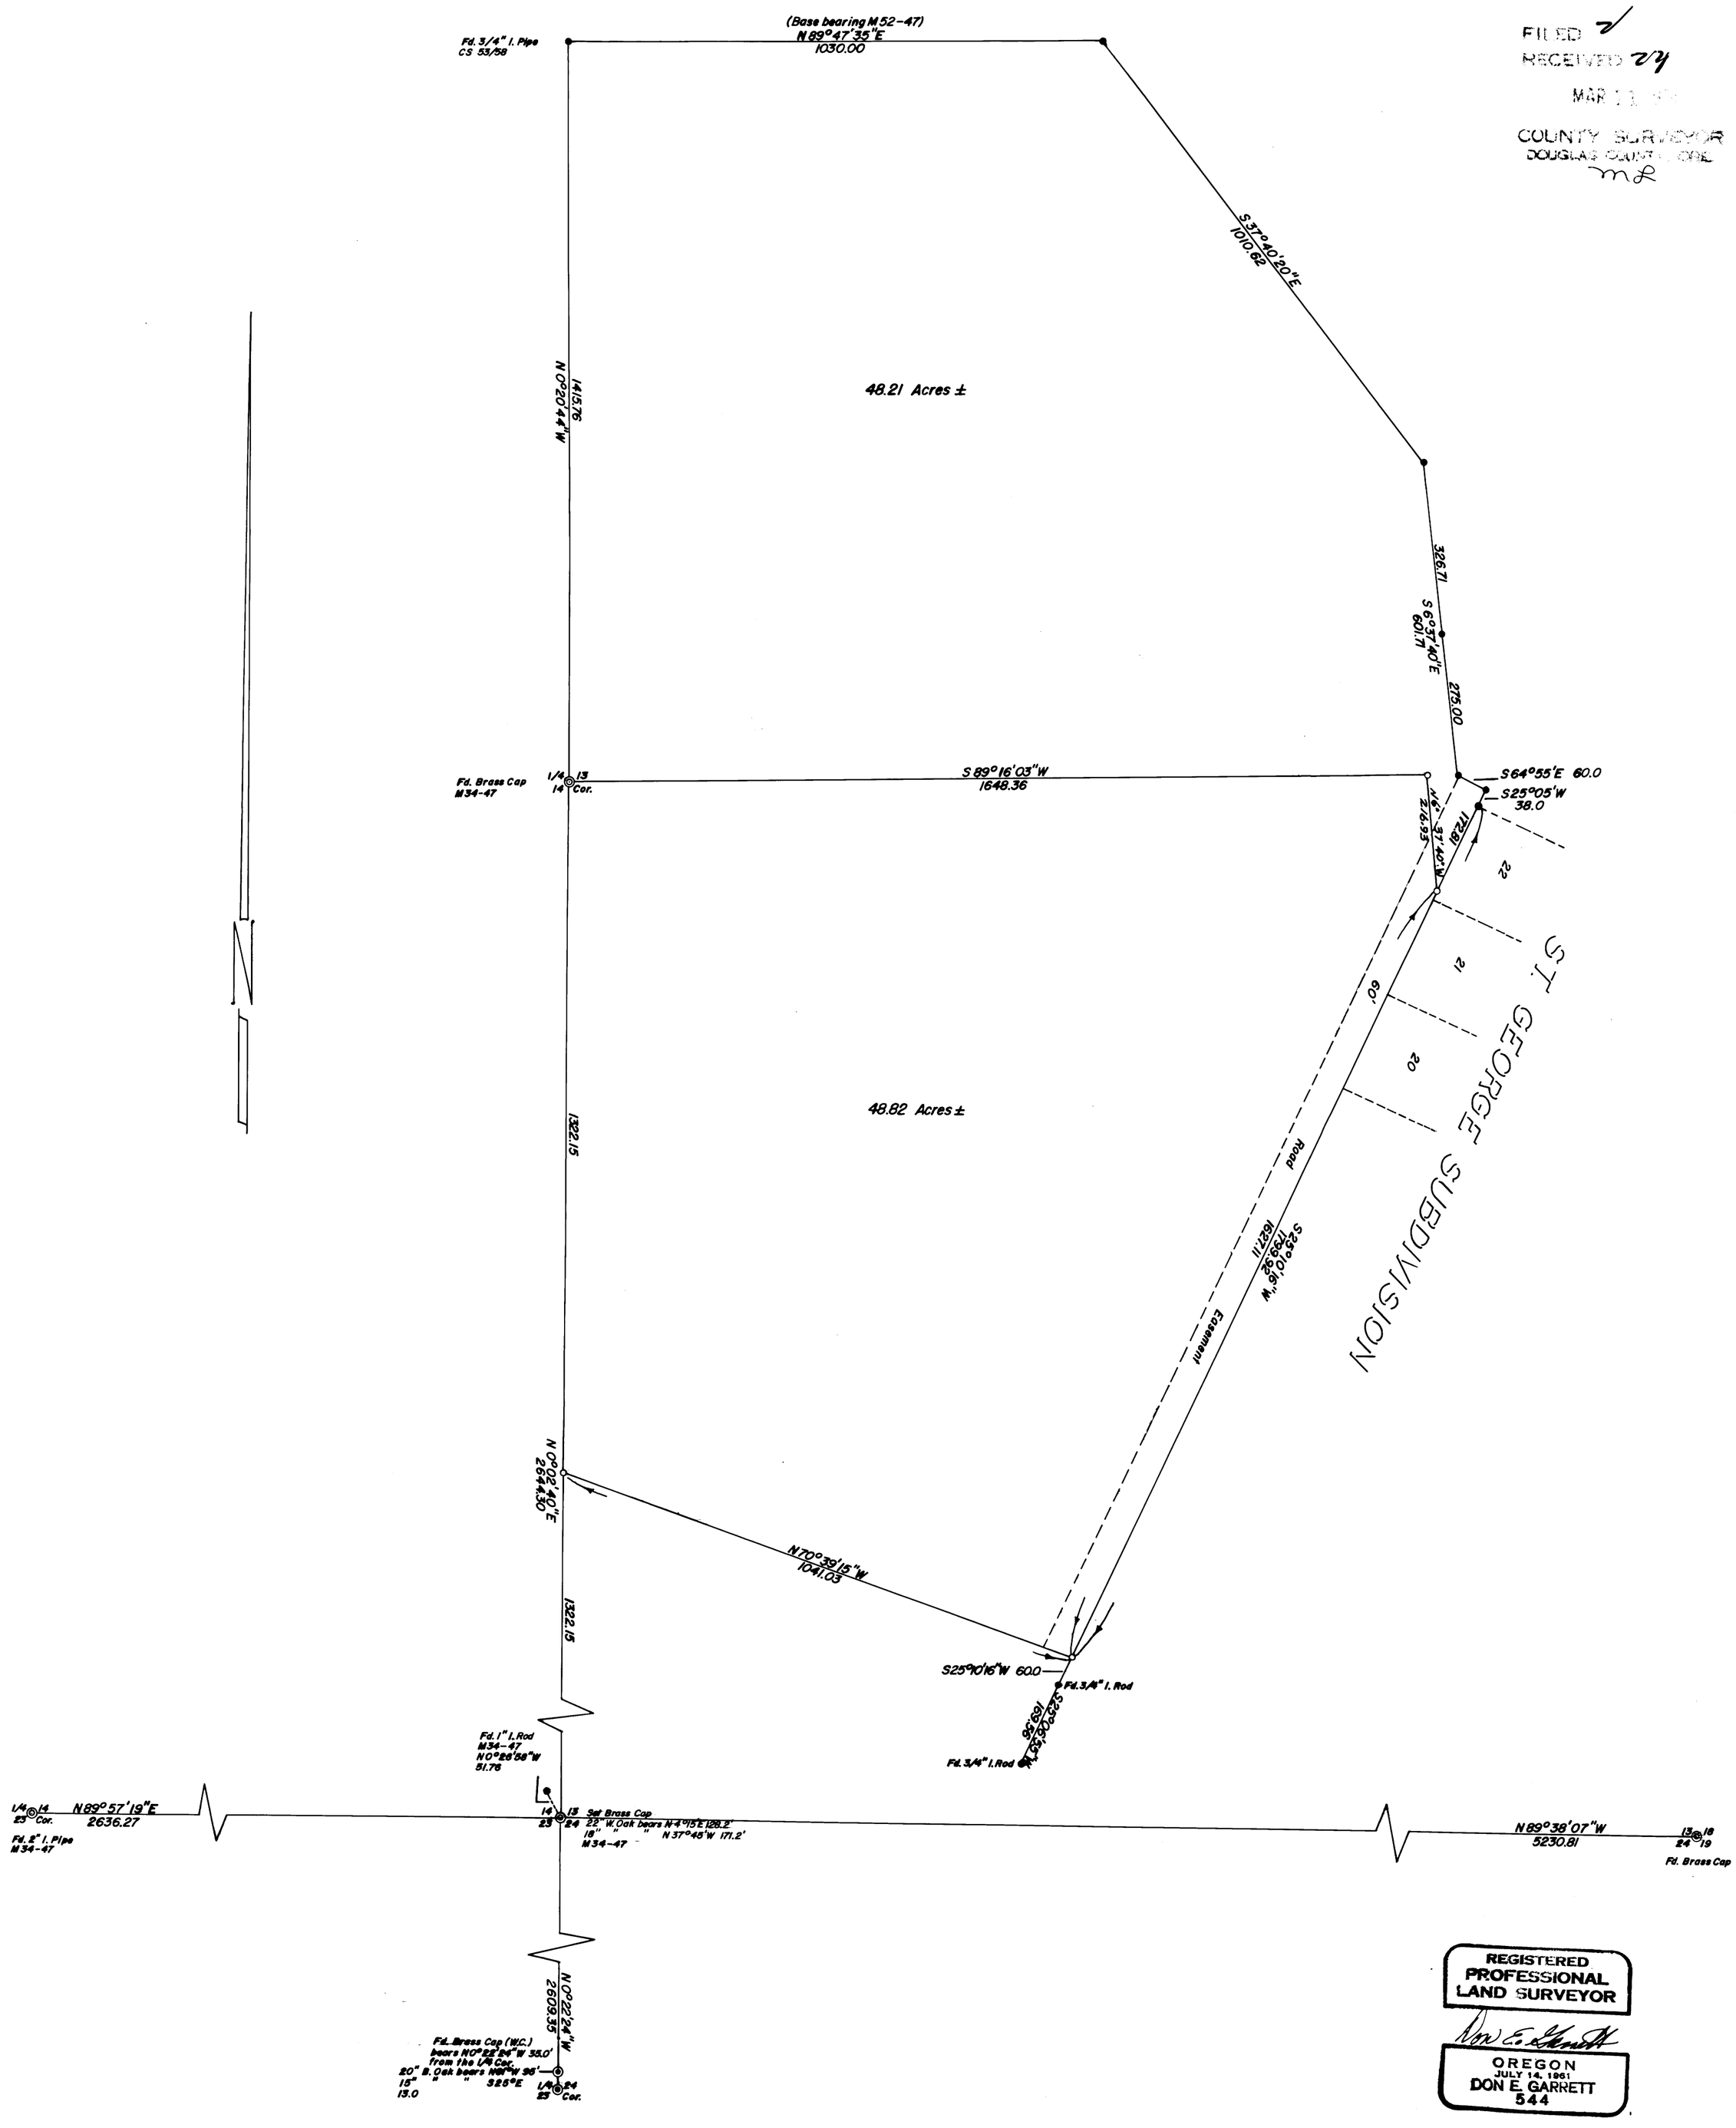

REGISTERED
PROFESSIONAL
LAND SURVEYOR

Don E. Garrett

OREGON
JULY 14, 1961
DON E. GARRETT
544

M52-58