MAP FILE M52 - 6

# SURVEY IN W½NW¼, Sec. 9, T.25S., R.6W., W.M.

Surveyed for Joe Cole — Dec. 28, 1973

Owner of Record: Guy & Maude Cole — Scale: 1" = 200'

COUNTY SURVEYORS FILE DATA
DO NOT REMOVE FROM OFFICE

FILED
RECEIVED
JAN 2, 1974
COUNTY SURVEYOR
DOUGLAS COUNTY, ORE.

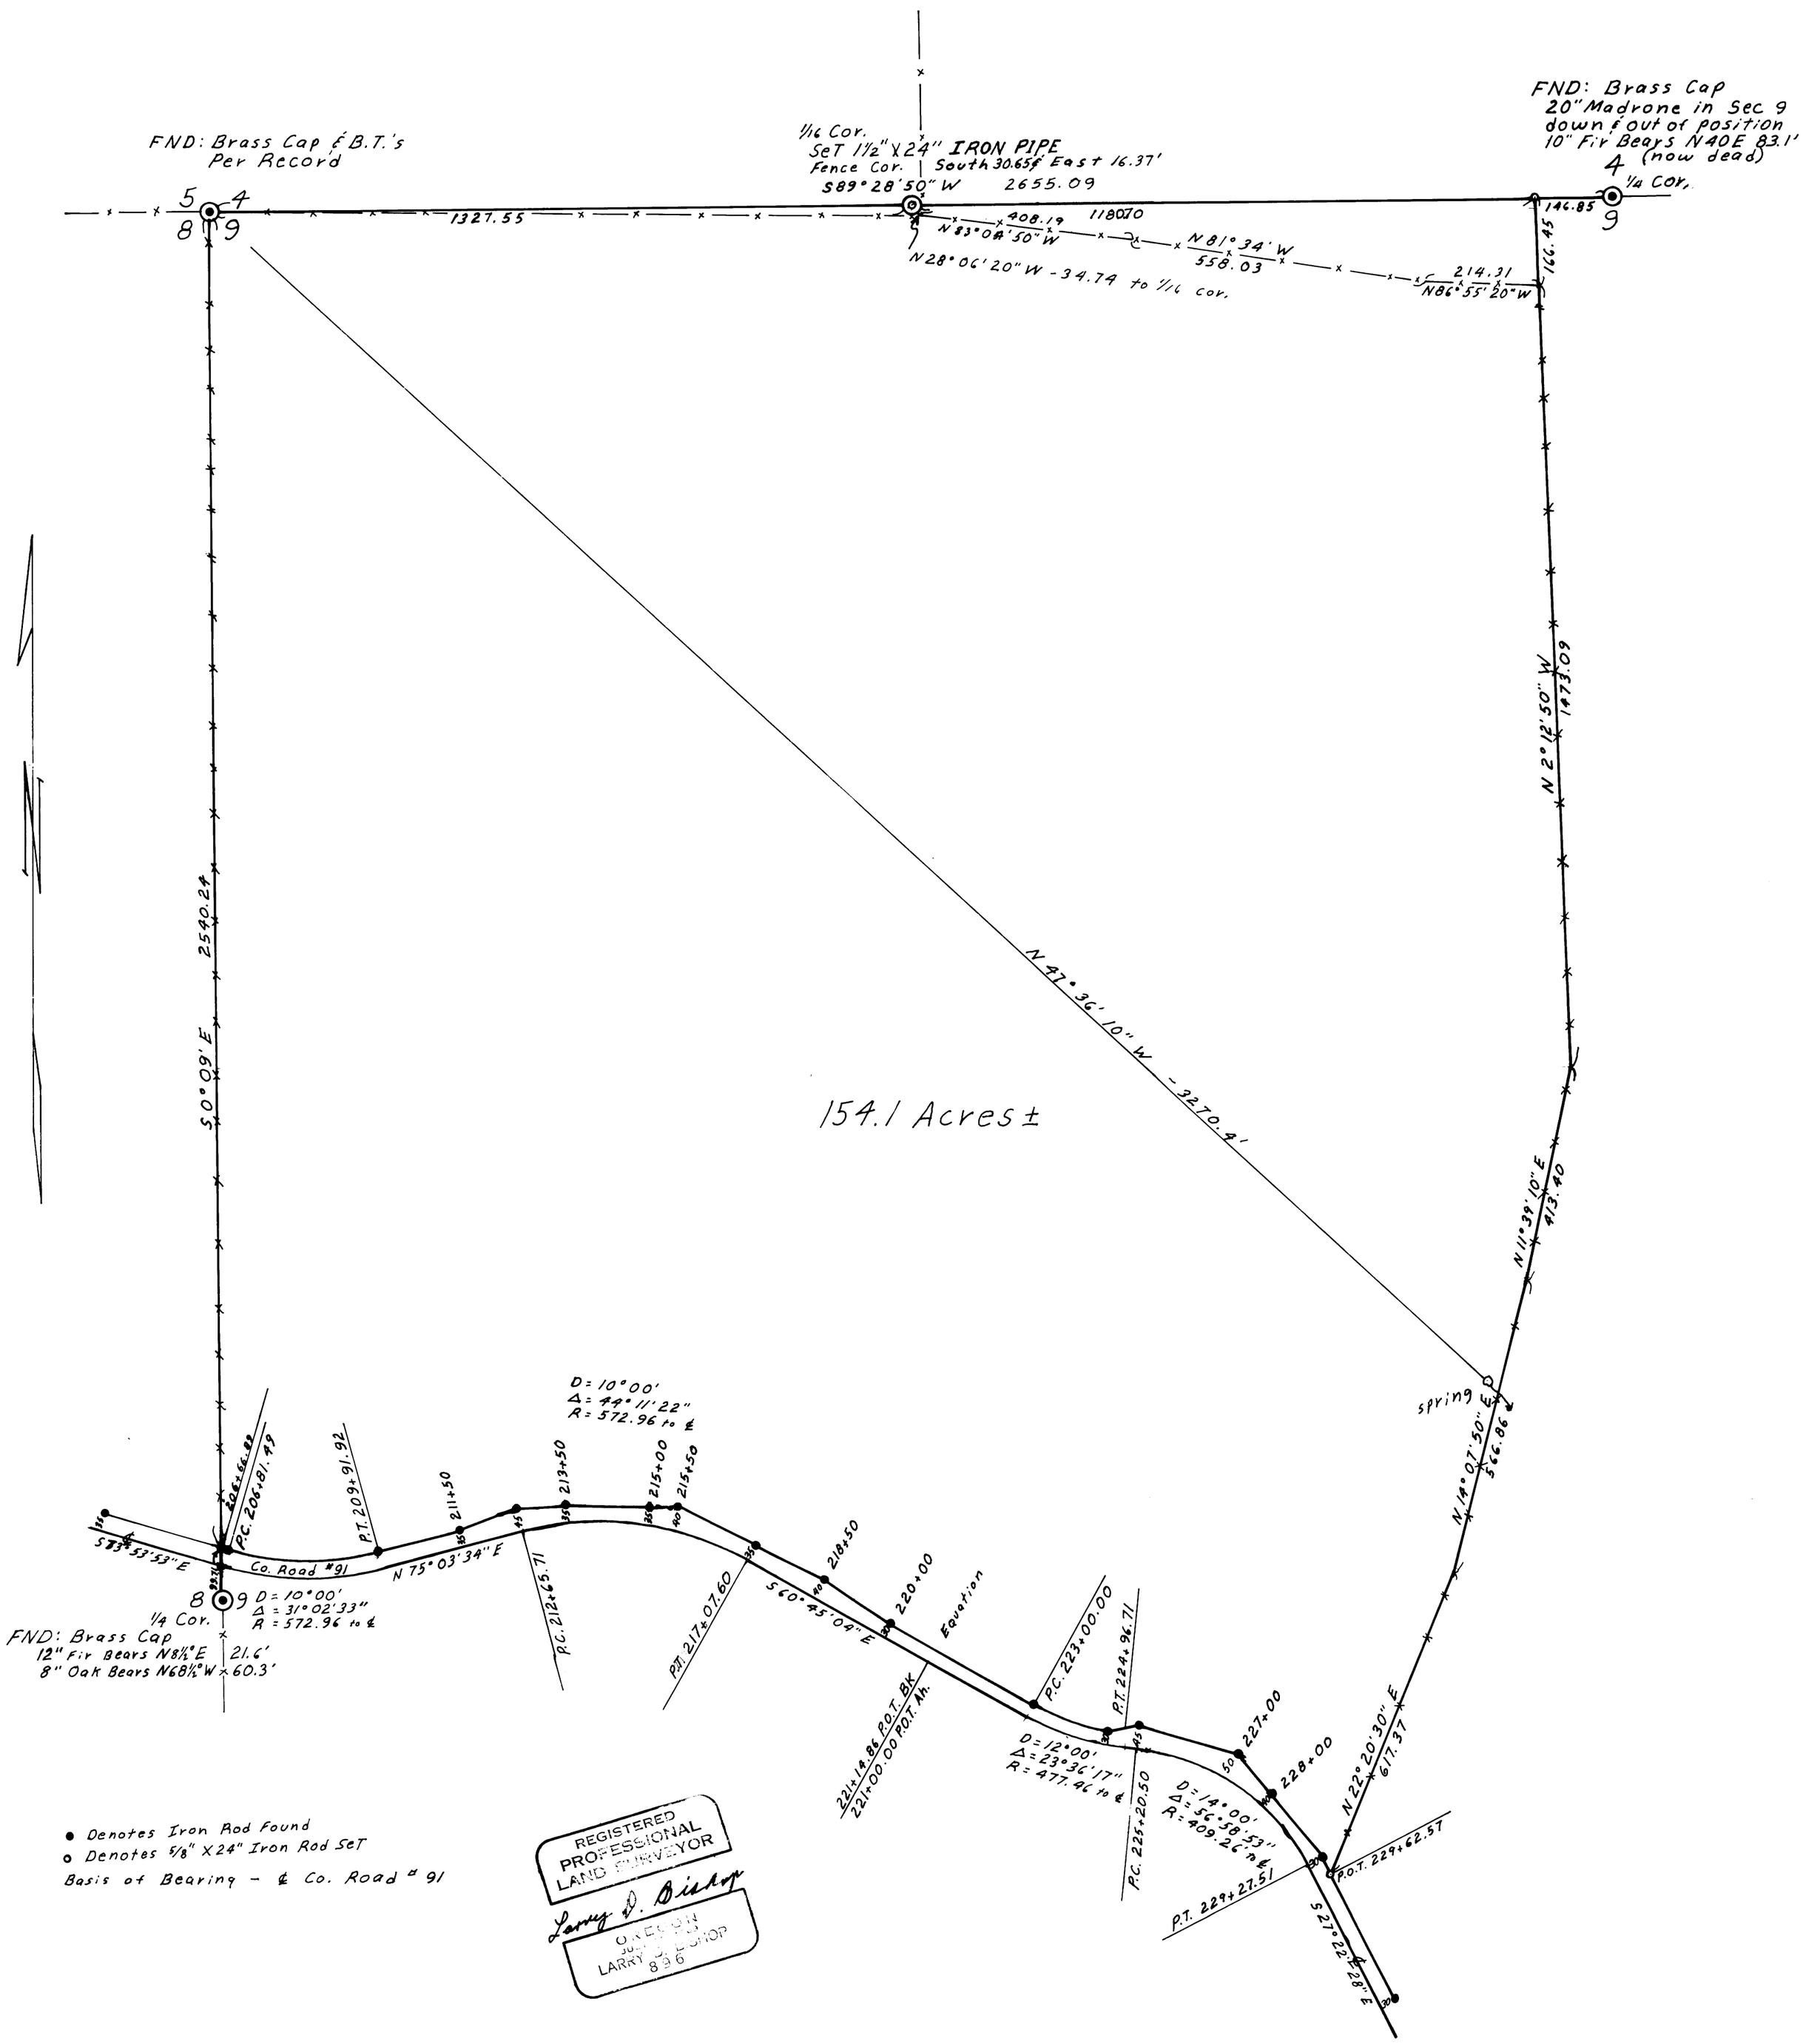


MAP FILE M52 - 6