COUNTY SURVEYORS FILE DATA
DO NOT REMOVE FROM OFFICE

SURVEY IN SECTION 31, T. 28 S., R. 7 W., W. M.
SURVEYED FOR ROY WILLIS
SURVEYED BY R. H. GEE – OCTOBER, 1970
SCALE 1" = 100'

FILED
RECEIVED
MAR 12 1971
COUNTY SURVEYOR
DOUGLAS COUNTY, ORE.

MAP FILE M52 - 60

REGISTERED PROFESSIONAL ENGINEER
R. H. GEE
OREGON
OCT. 28, 1966

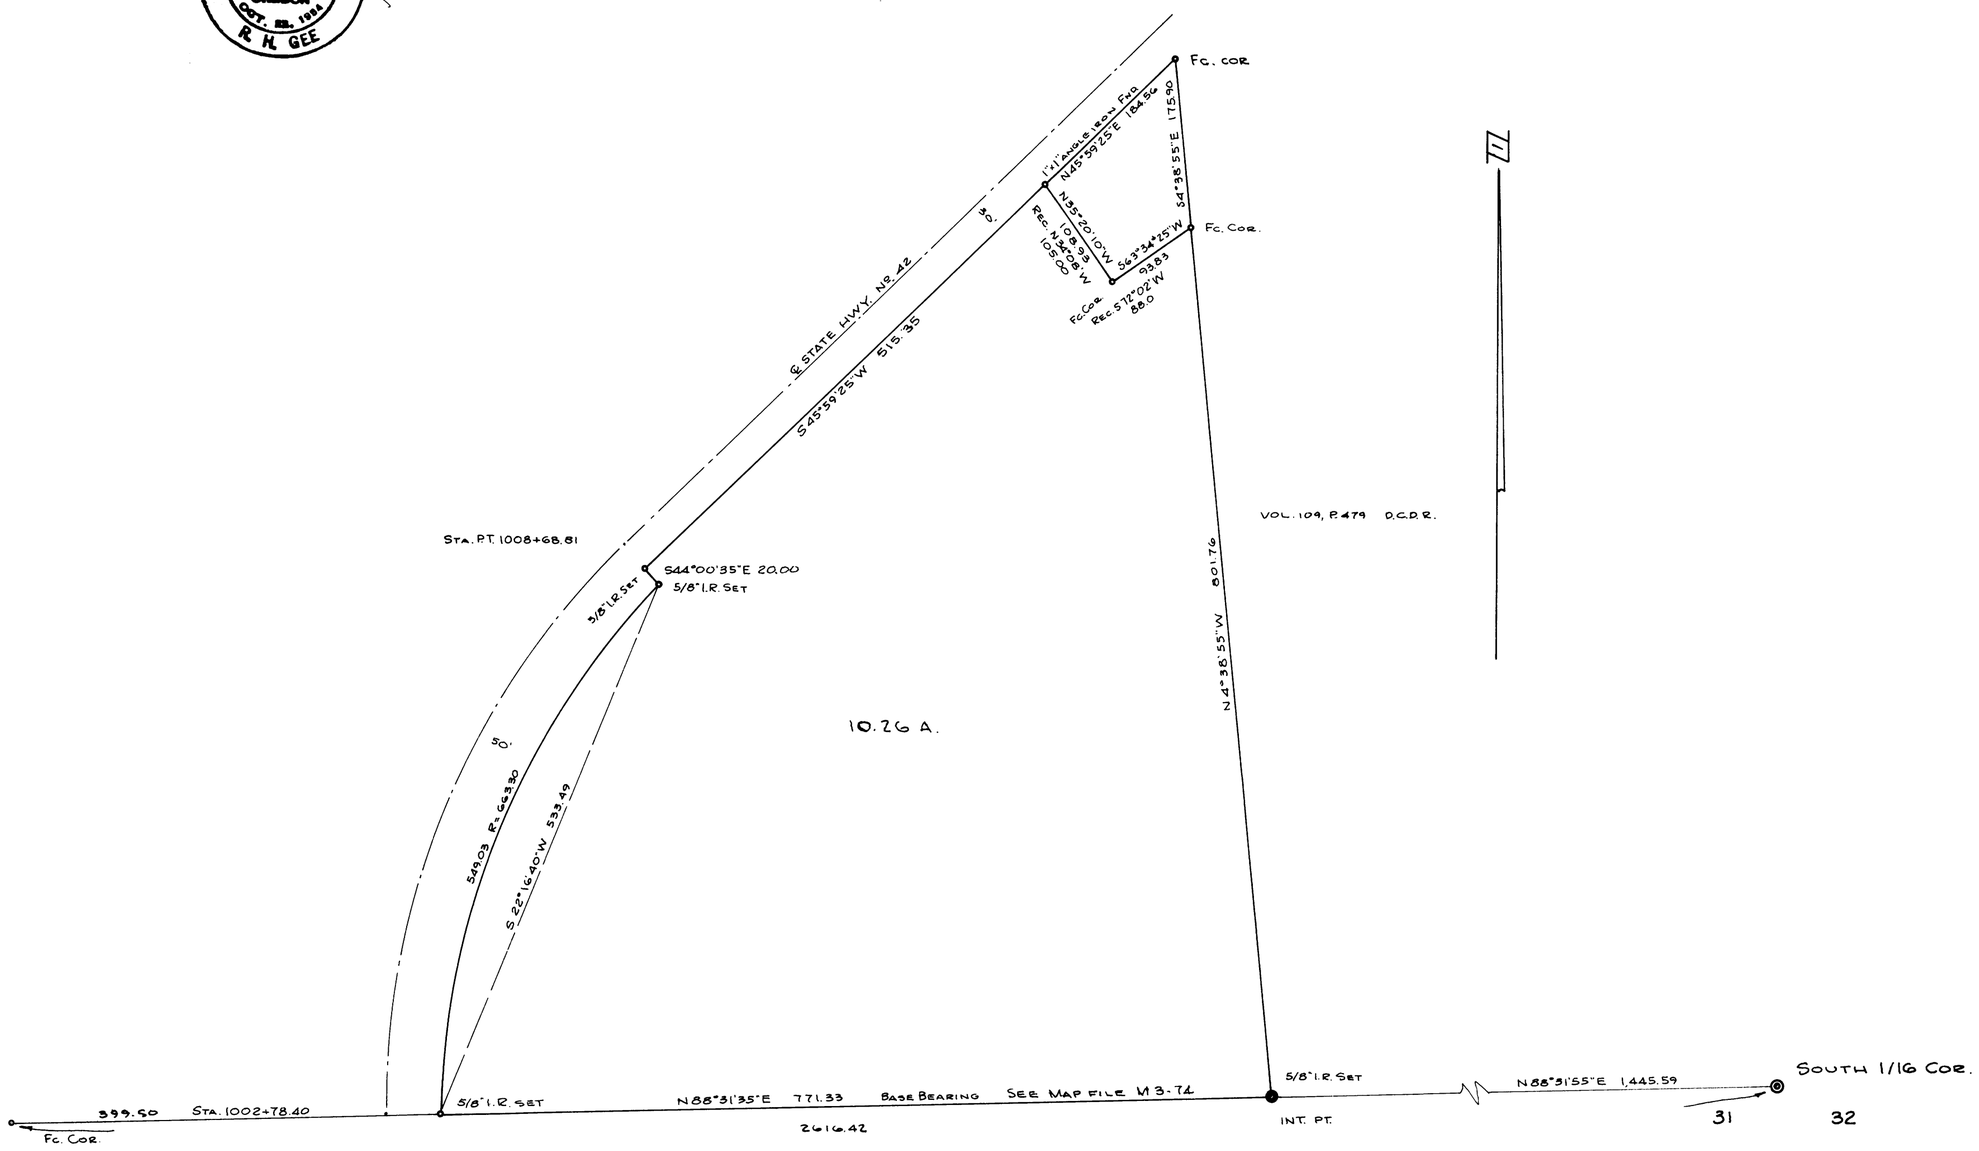


MAP FILE M52 - 60