FILED ✓
RECEIVED ✓
MAR 29 1974
COUNTY SURVEYOR
DOUGLAS COUNTY, ORE.
ML

SURVEY IN E.H. BRANTON SUBDIVISION OF LOT 3, BLOCK 3, PLAT "O" SUTHERLIN LAND & WATER CO. T.25-5 SEC. 19-20

Surveyed for LEO SANDERS by W.S. BARNES

MARCH 1974 SCALE 1" = 100'

- FOUND ½" I. PIPE
- SET ½" I. ROD

COUNTY SURVEYORS FILE DATA
DO NOT REMOVE FROM OFFICE

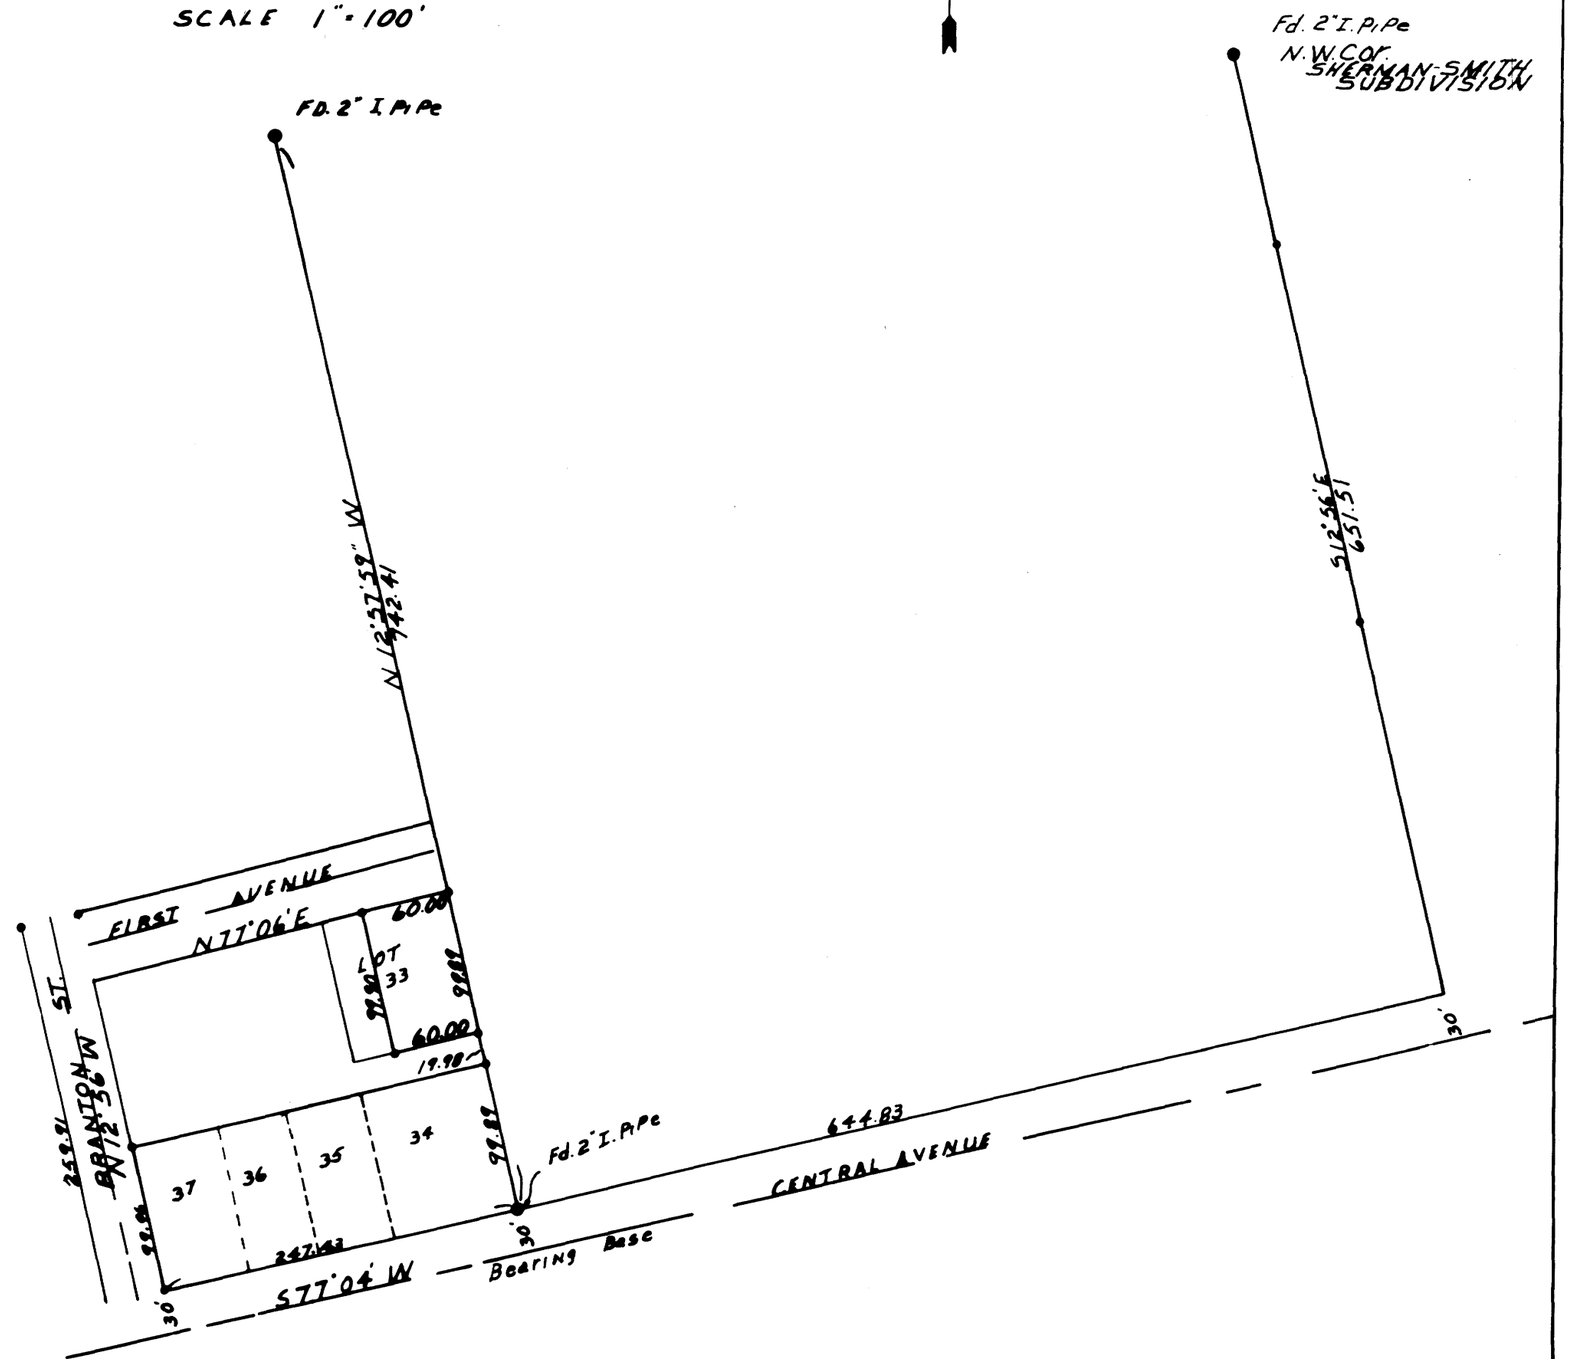

REGISTERED PROFESSIONAL ENGINEER
2199
W. S. Barnes
OREGON
SEPT. 5, 1961
William S. Barnes

MAP FILE M-53 - 1

MAP FILE M-53 - 1