COUNTY SURVEYORS FILE DATA
DO NOT REMOVE FROM OFFICE

SURVEY IN ELKTON ESTATES

IN SEC. 32, T22S, R7W. W.M.

SURVEYED FOR - GENE LACEY

SURVEYED BY - W. S. BARNES MAR. 1974

FILED
RECEIVED
APR 15 1974
COUNTY SURVEYOR
DOUGLAS COUNTY, ORE.

MAP FILE M-53-10

SCALE 1" = 100'

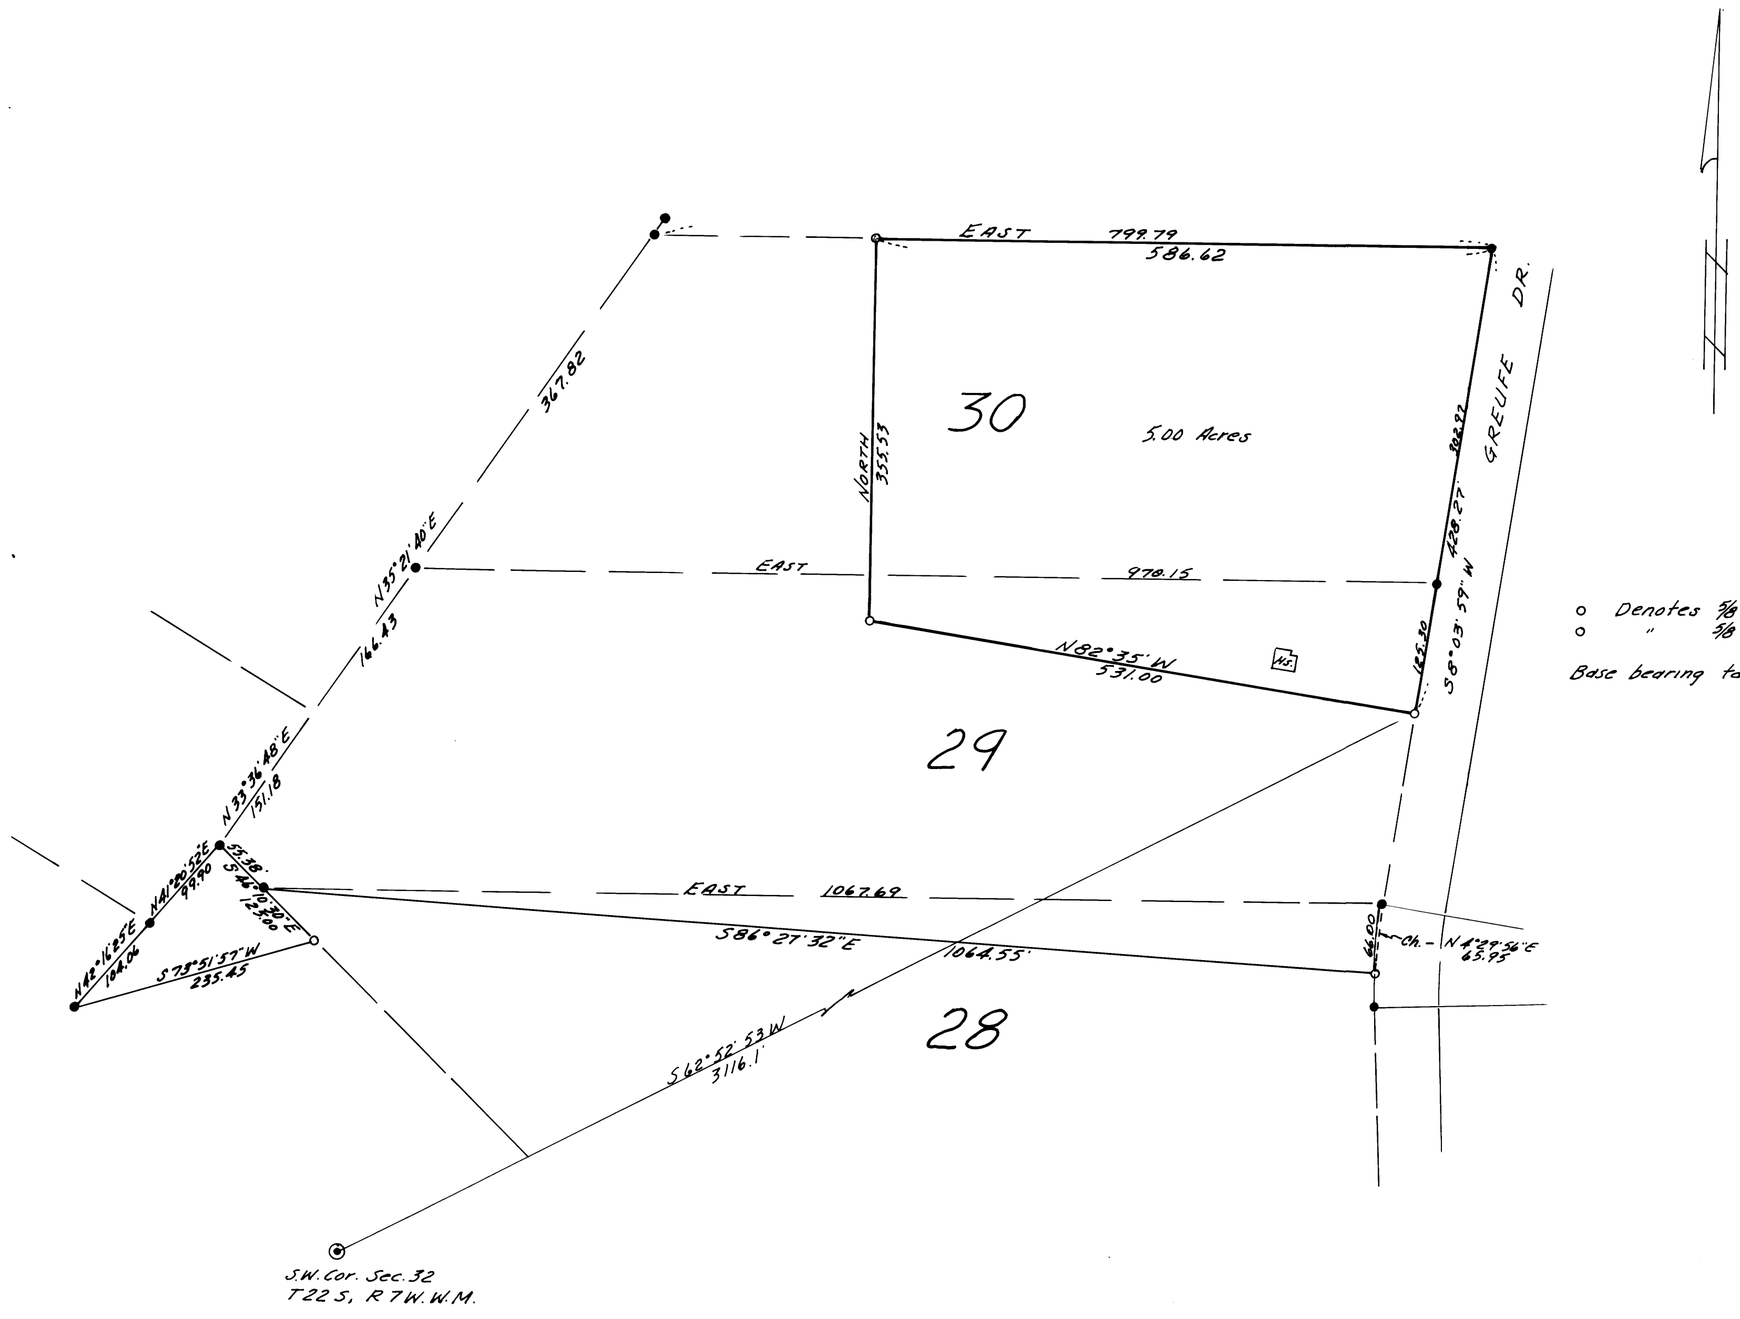

o Denotes 5/8" iron rods set
o " 5/8" iron rods found.

Base bearing taken from ELTON ESTATES survey

MAP FILE M-53-10