M53 - 17

SURVEY FOR MORTGAGE PURPOSES IN SECTIONS 15 & 22, T.27S., R.5W.W.M.

FOR: DOLPH BOYER

BY: BAUGHMAN SURVEYING SERVICE

APRIL 1974 SCALE: 1"=200'

COUNTY SURVEYORS FILE DATA
DO NOT REMOVE FROM OFFICE

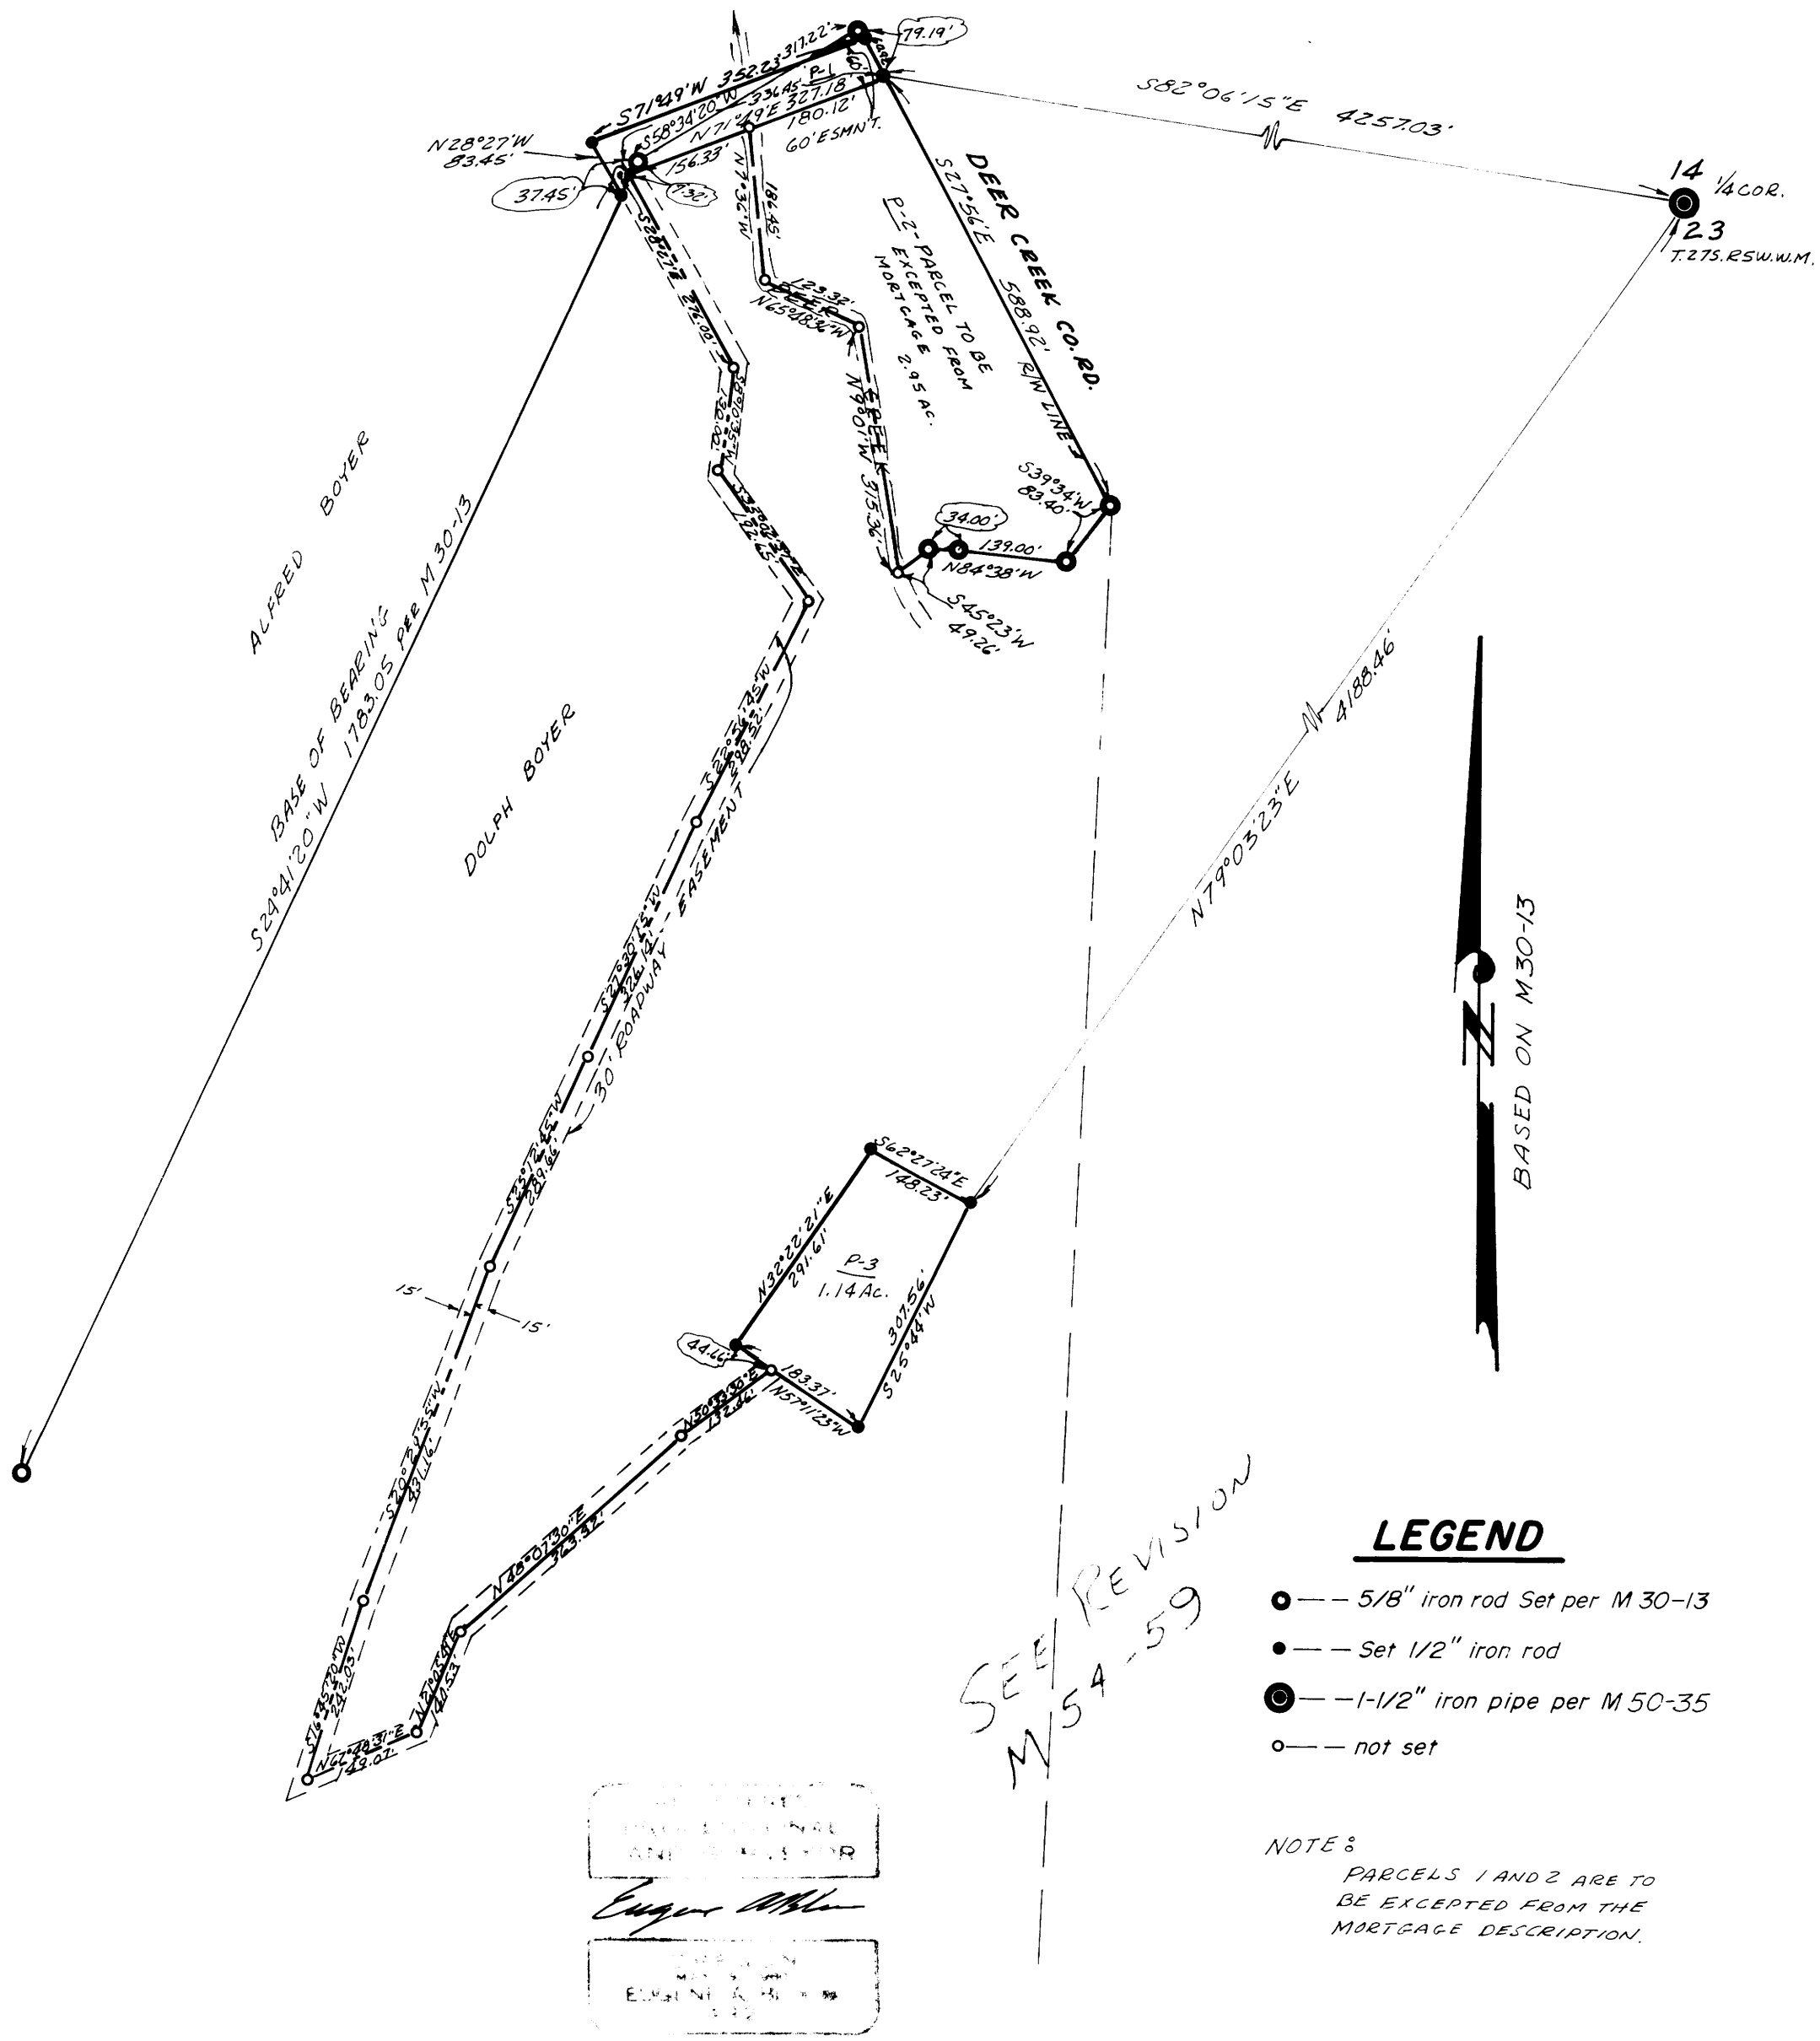

LEGEND

- 5/8" iron rod Set per M 30-13
- Set 1/2" iron rod
- 1-1/2" iron pipe per M 50-35
- not set

NOTE:
PARCELS 1 AND 2 ARE TO BE EXCEPTED FROM THE MORTGAGE DESCRIPTION.

M53 - 17