COUNTY SURVEYORS FILE DATA
DO NOT REMOVE FROM OFFICE

FILED 2/3
RECEIVED 2/3
MAY 3 1974
COUNTY SURVEYOR
DOUGLAS COUNTY, ORE.

SURVEY IN SECTION 9, TOWNSHIP 27 SOUTH, RANGE 6 WEST, WILLAMETTE MERIDIAN

Surveyed for Blake Conn by Don E. Garrett

April , 1974

Scale 1" = 200'

Bearings based on the North line of that property M 26-68

○ Set 5/8" Iron Rod

● Found 5/8" Iron Rod

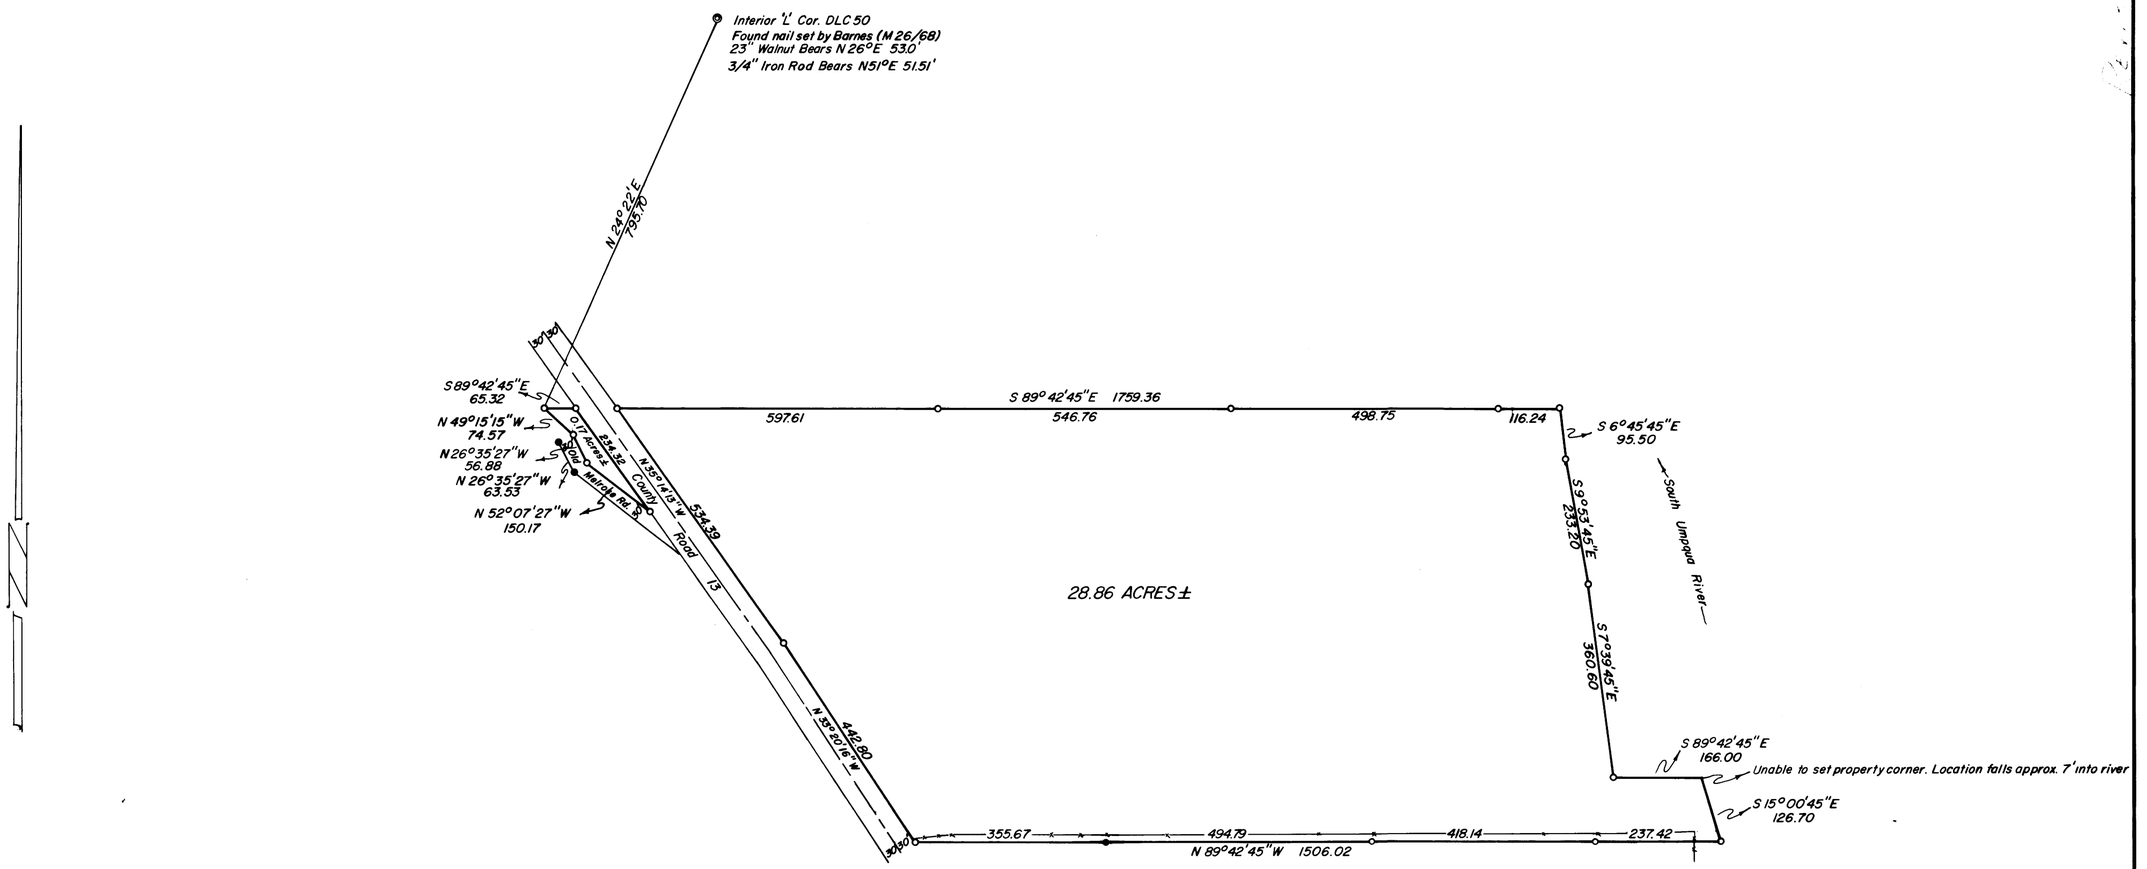

REGISTERED
PROFESSIONAL
LAND SURVEYOR
Don E. Garrett
OREGON
DEC. 6, 1971

MAP FILE M53-18

M53-18