FILED ✓
RECEIVED ✓
JUN 4 1974
COUNTY SURVEYOR
DOUGLAS COUNTY, ORE.
ml

MAP FILE M-53 - 35

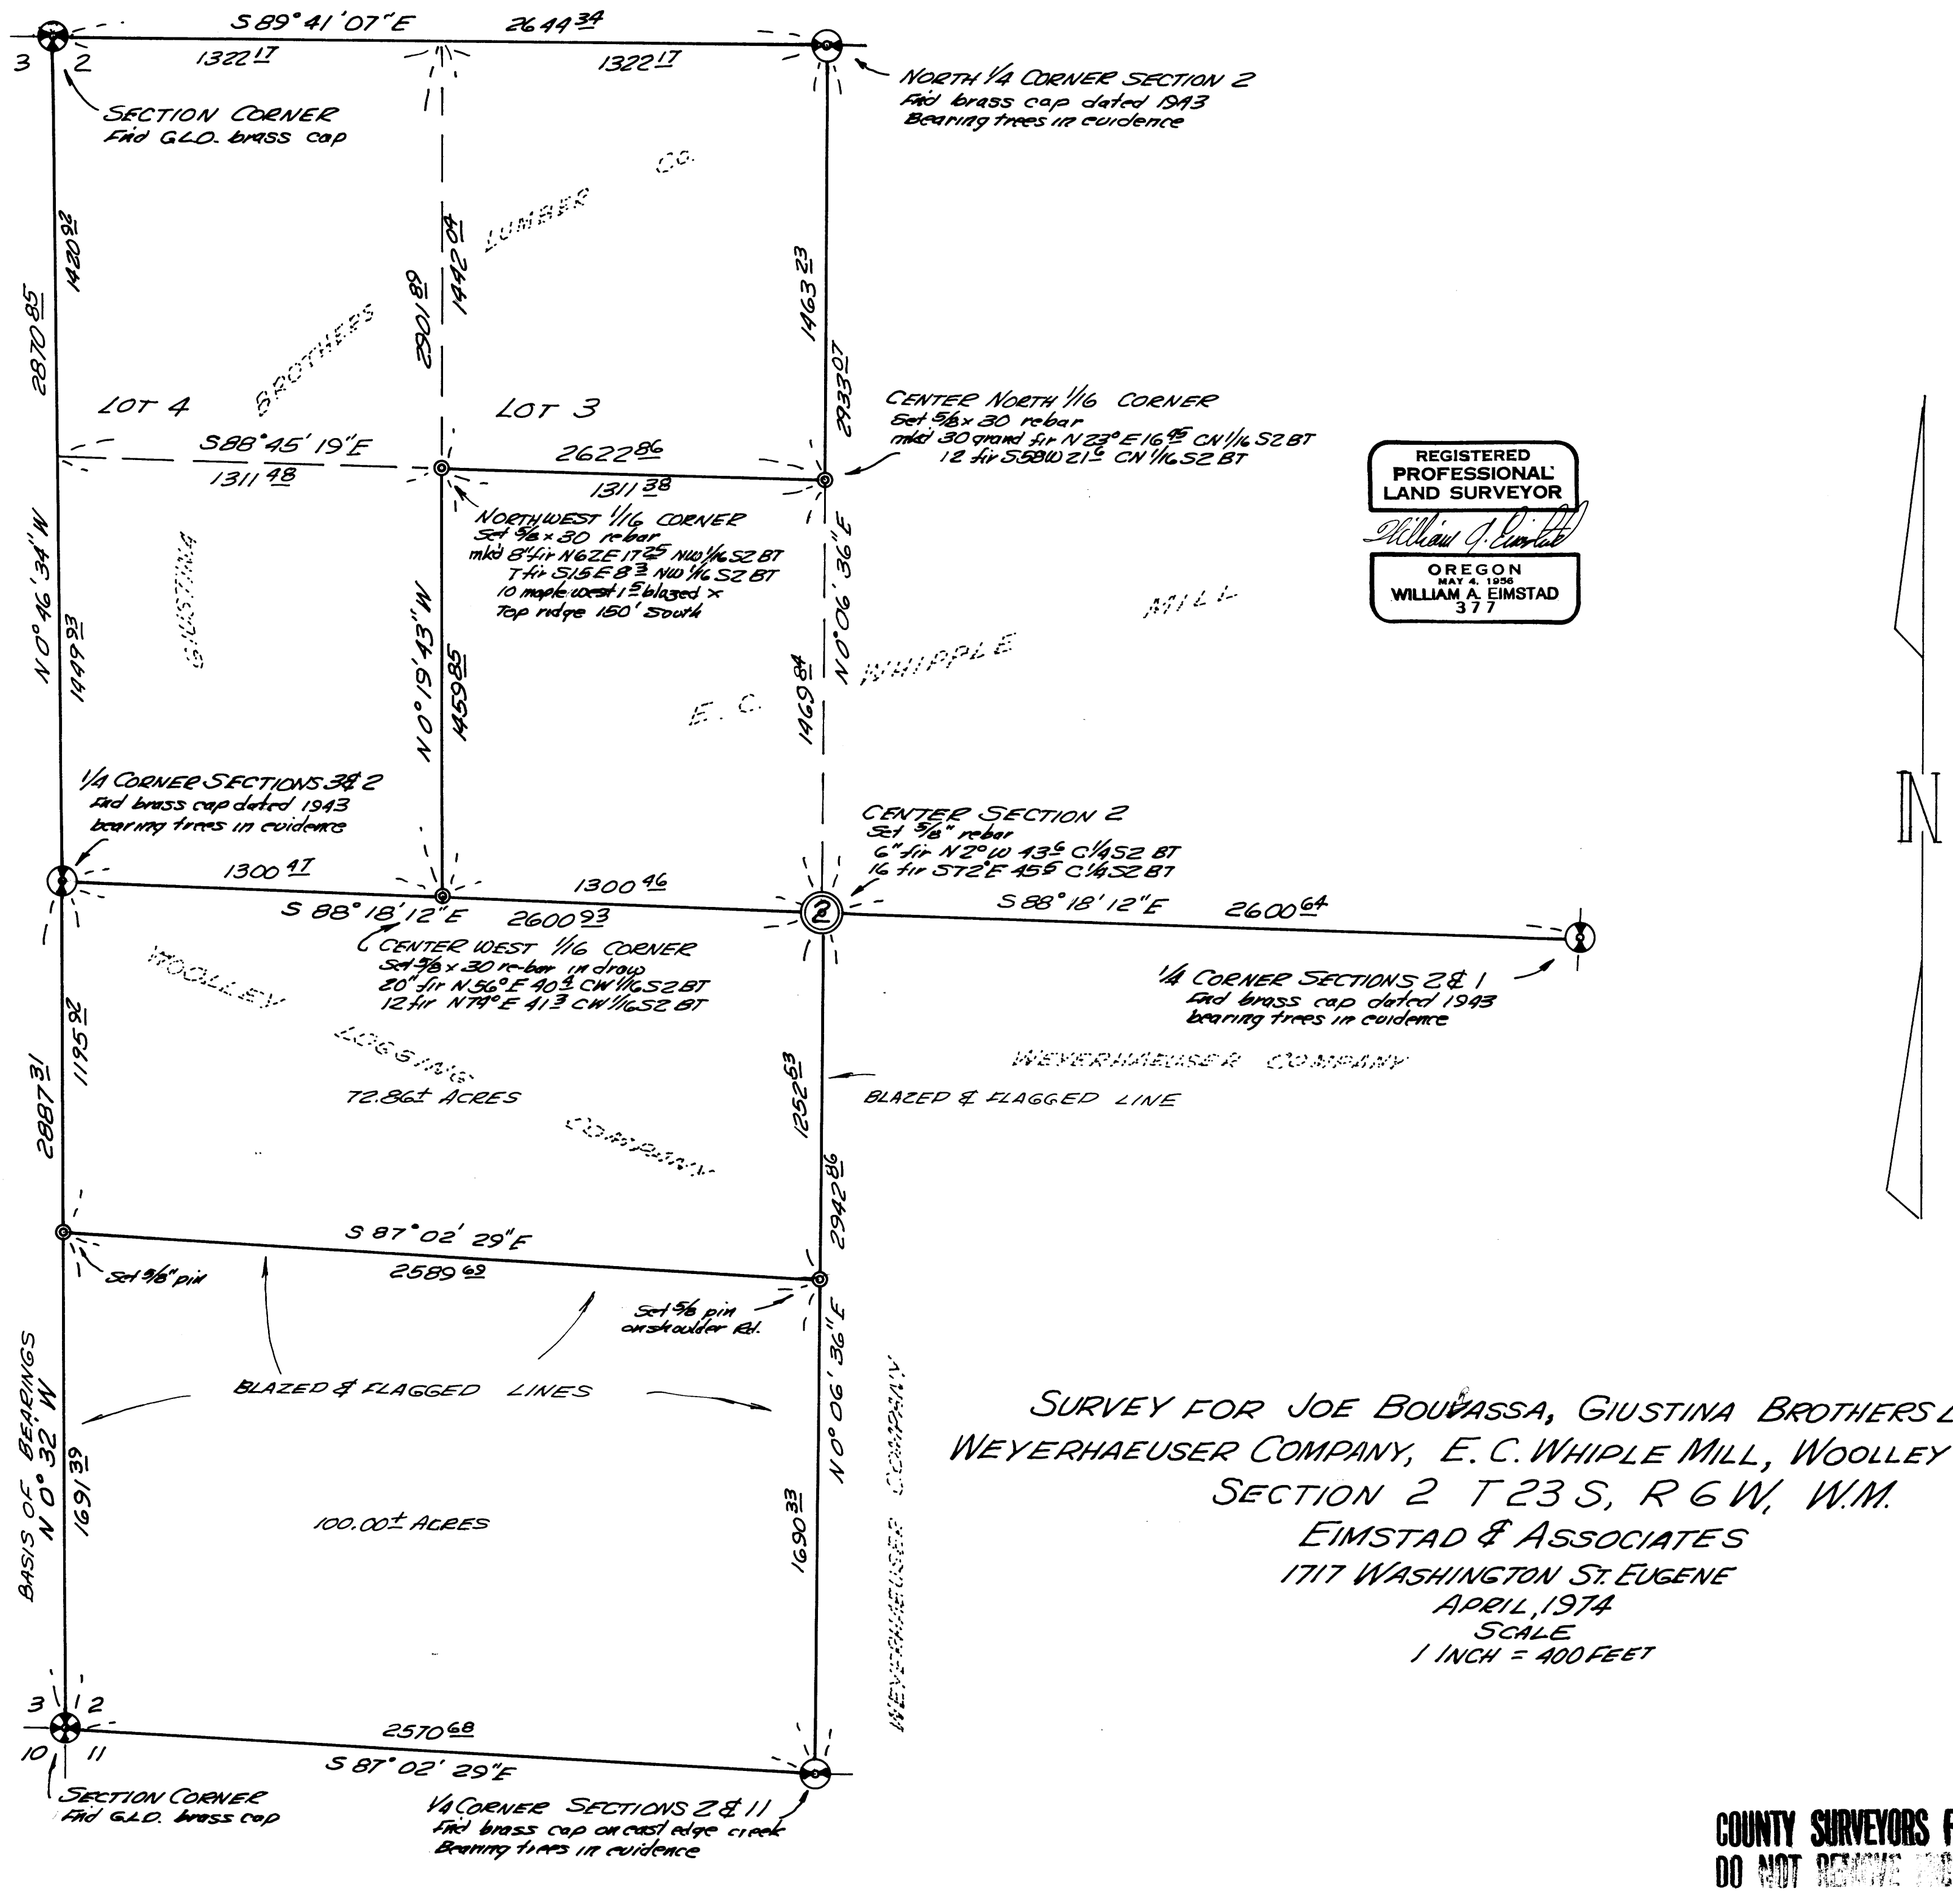

SURVEY FOR JOE BOUVASSA, GIUSTINA BROTHERS LUMBER CO.
WEYERHAEUSER COMPANY, E. C. WHIPLE MILL, WOOLLEY LOGGING CO.
SECTION 2 T 23 S, R 6 W, W.M.
EIMSTAD & ASSOCIATES
1717 WASHINGTON ST. EUGENE
APRIL, 1974
SCALE
1 INCH = 400 FEET

COUNTY SURVEYORS FILE DATA
DO NOT REMOVE FROM OFFICE

MAP FILE M-53 - 35