MAP FILE M 53-76

COUNTY SURVEYORS FILE DATA
DO NOT REMOVE FROM OFFICE

FILED
RECEIVED
JUL 26 1974
COUNTY SURVEYOR
DOUGLAS COUNTY, ORE.

SURVEY IN SEC. 34, T22S, R5W. W.M.

SURVEYED FOR- REX APPLEGATE — JULY 1974

SURVEYED BY- W. S. BARNES — SCALE 1"=100'

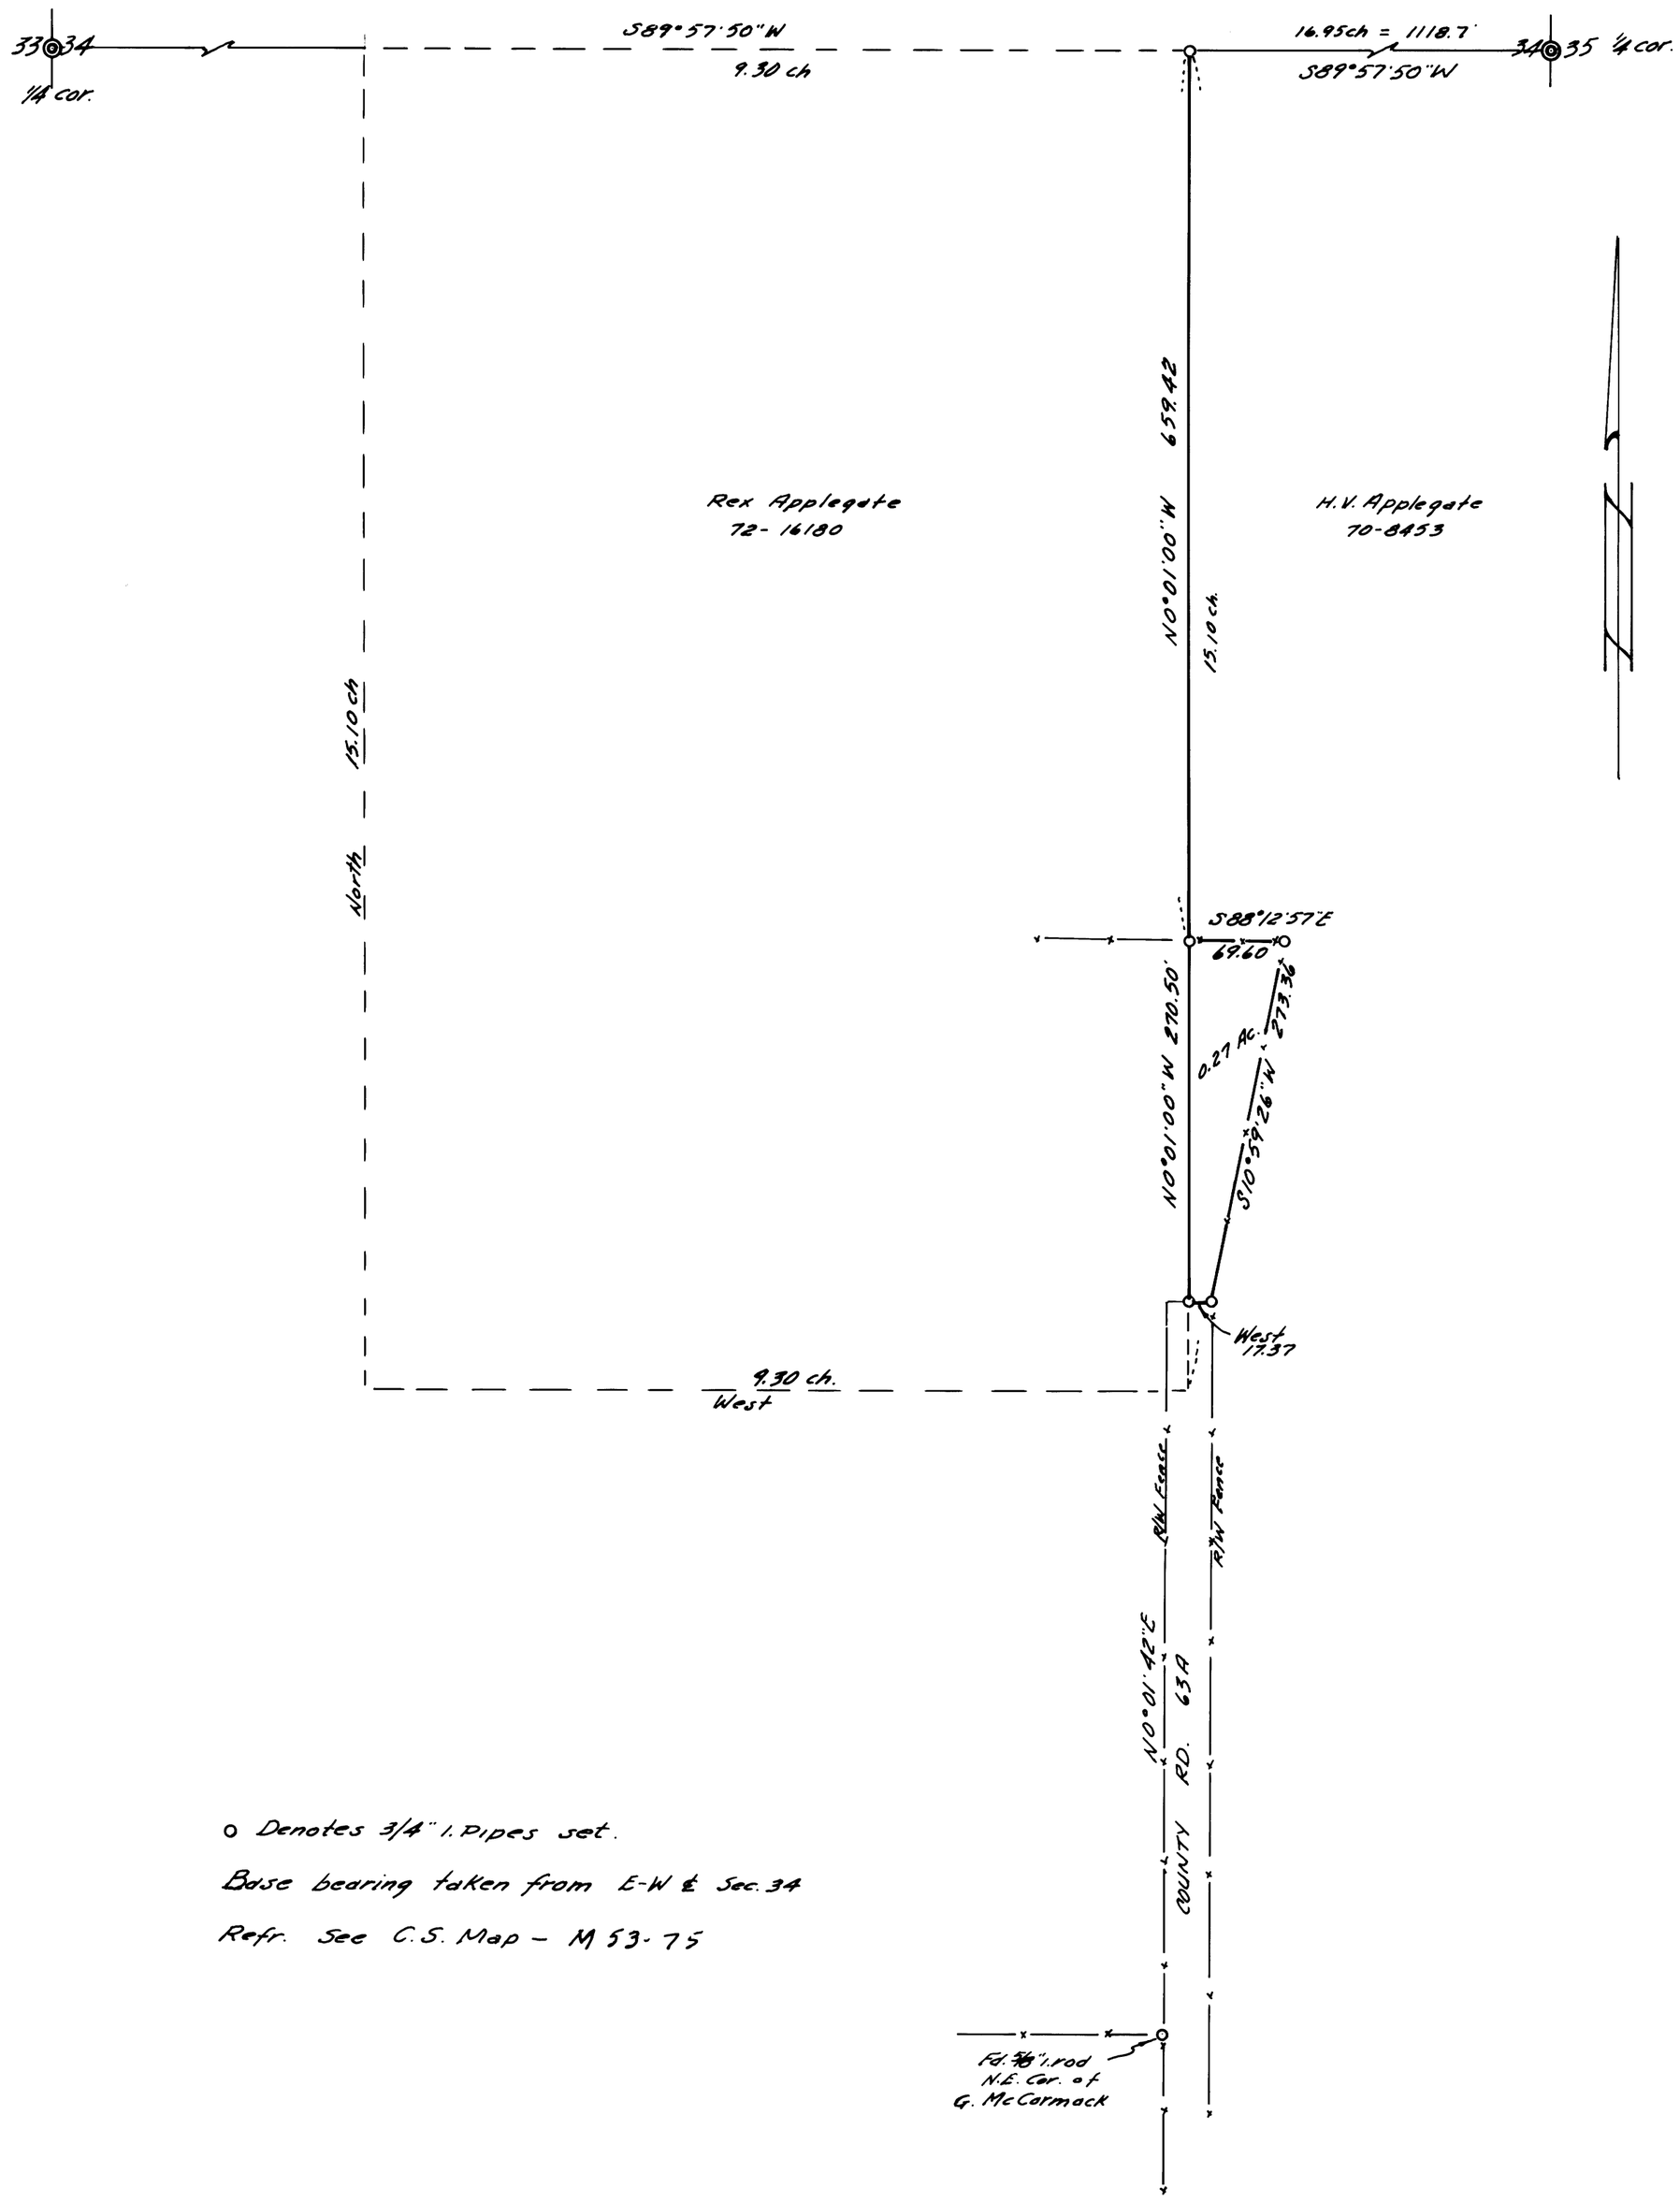

o Denotes 3/4" I. Pipes set.

Base bearing taken from E-W ¼ Sec. 34

Refr. See C.S. Map - M 53-75

REGISTERED PROFESSIONAL ENGINEER
2128
OREGON
SEPT. 8, 1971
William S. Barnes

MAP FILE M 53-76