MAP FILE M 54-16

COUNTY SURVEYORS FILE DATA
DO NOT REMOVE FROM OFFICE

FILED
RECEIVED
AUG 20 1974
COUNTY SURVEYOR
DOUGLAS COUNTY, ORE.

SURVEY IN SECTION 15, TOWNSHIP 28 SOUTH, RANGE 8 WEST, WILLAMETTE MERIDIAN

Surveyed for Michael Smith by Don E. Garrett

August 1974 — Scale 1" = 200'

Subdivision of Sect. 15 is Based on a Survey by Shener Engineering, M42-66

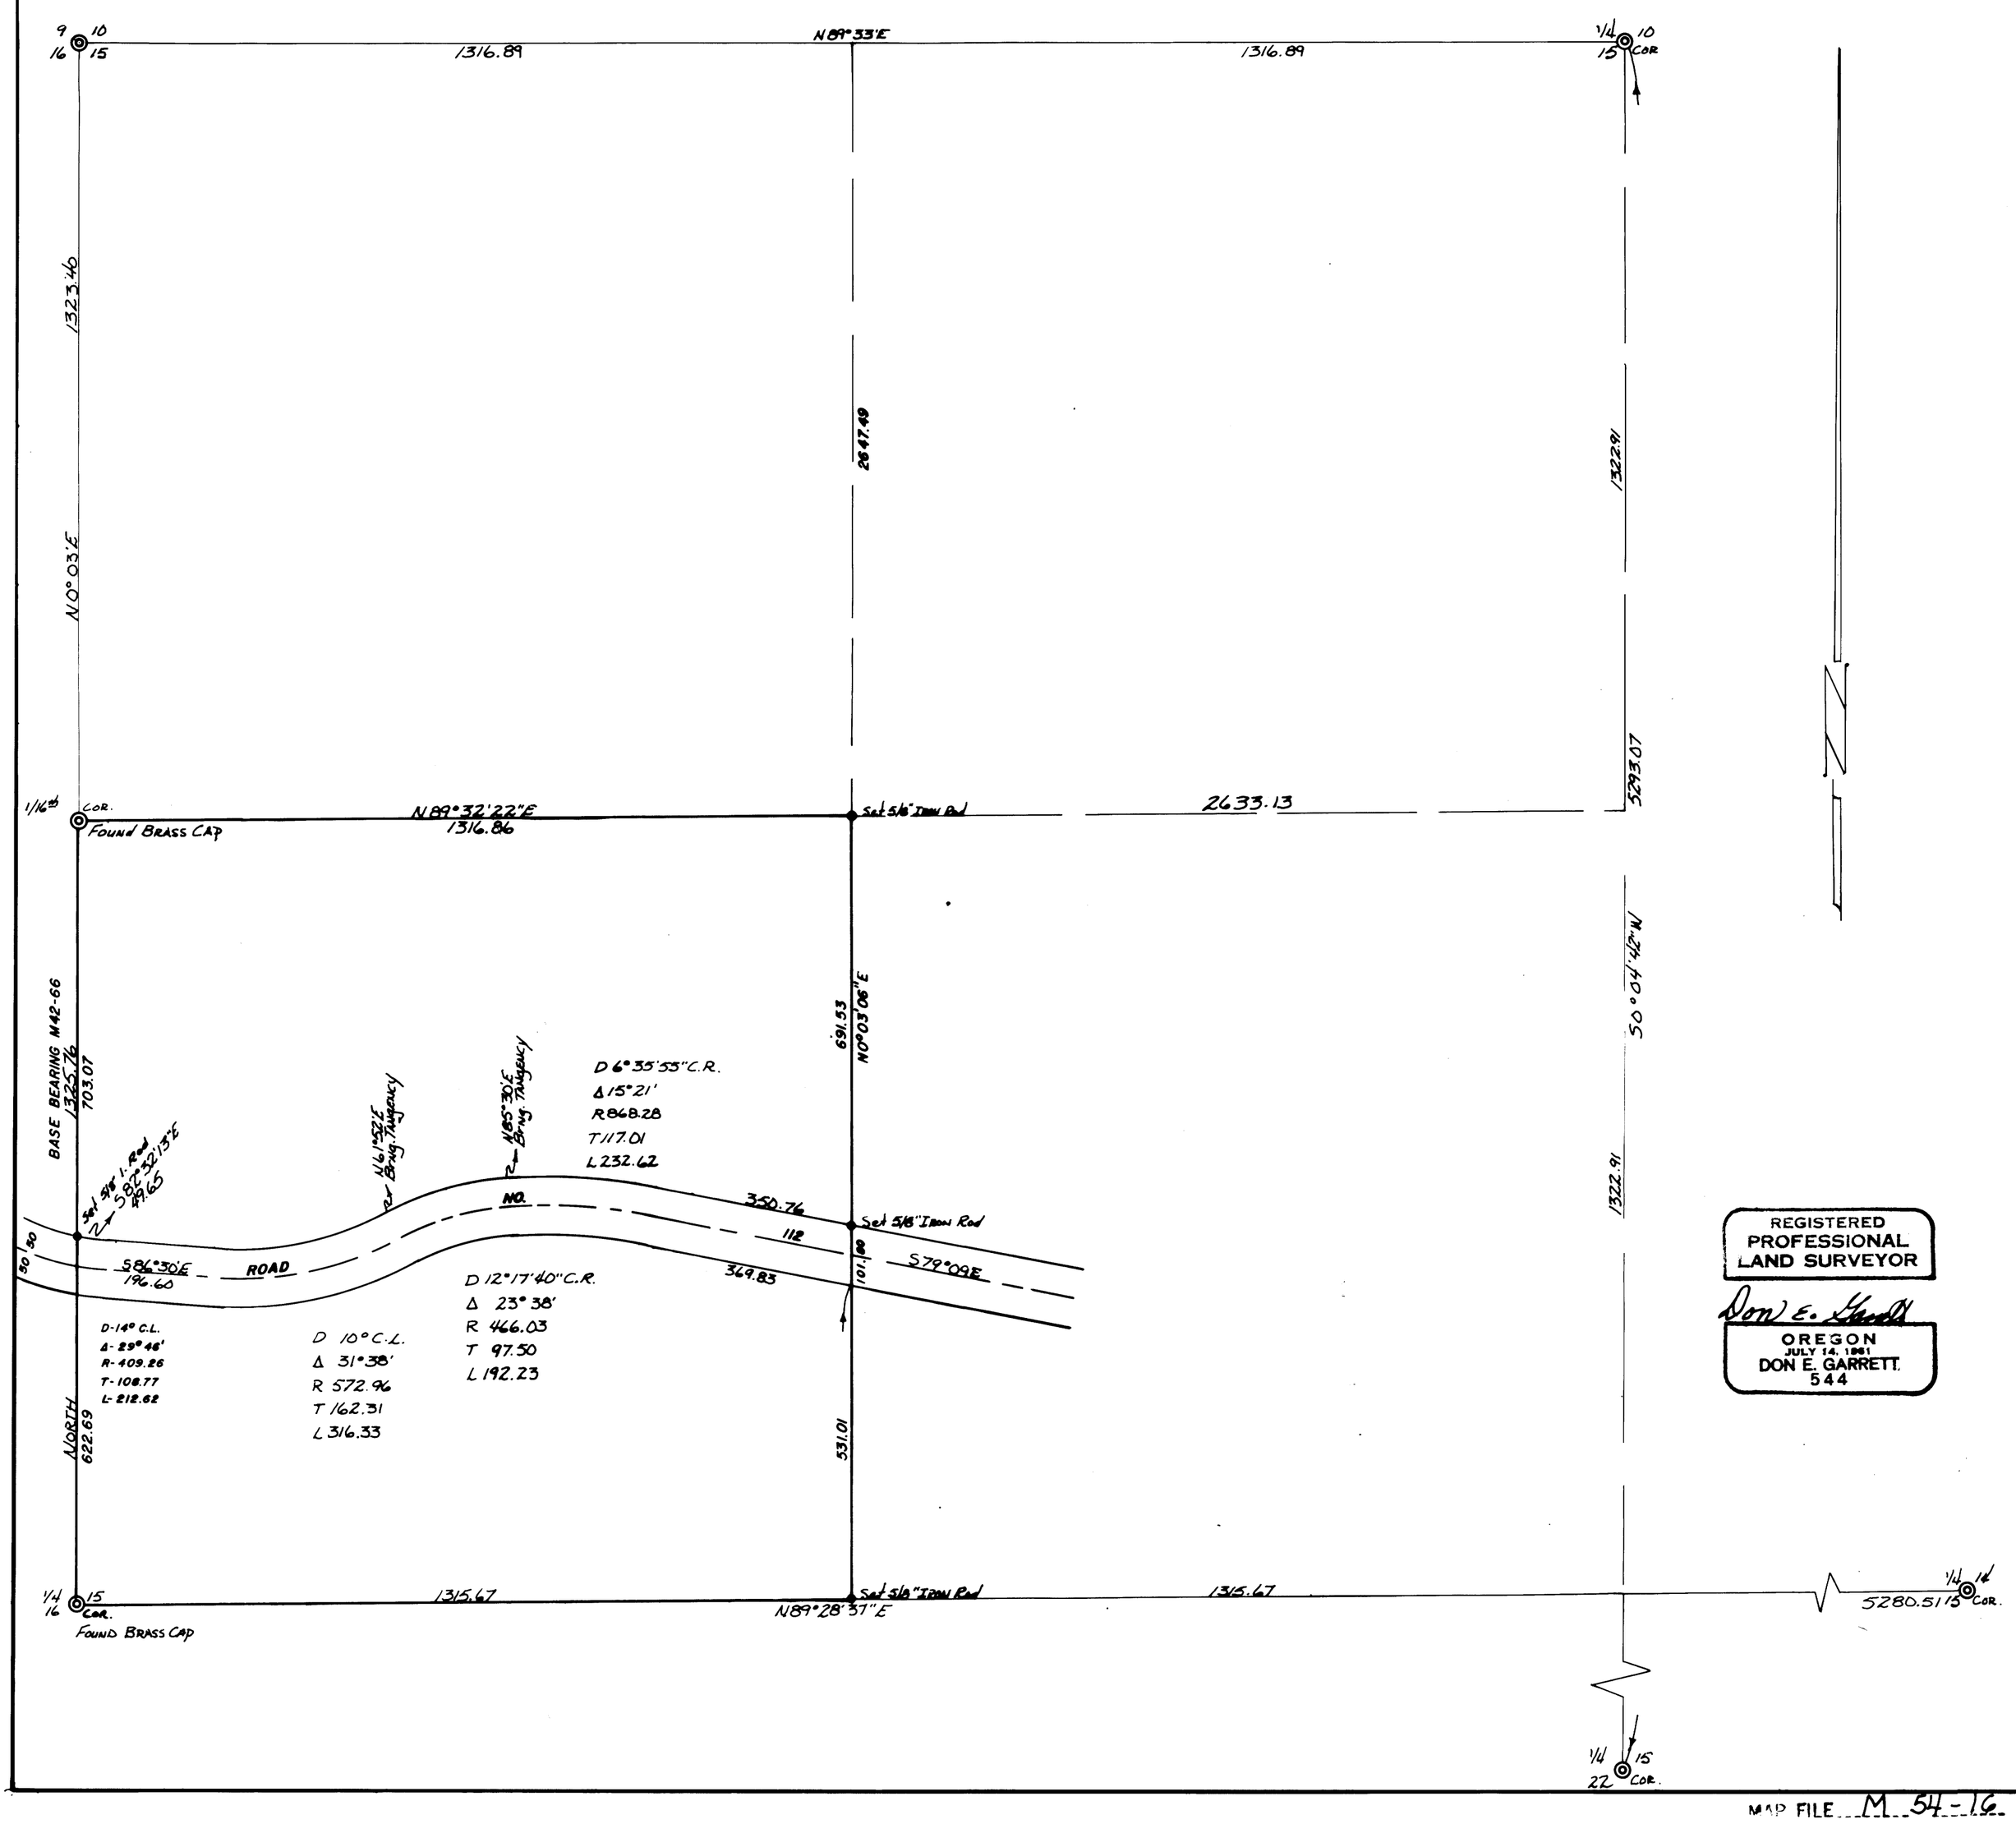

REGISTERED
PROFESSIONAL
LAND SURVEYOR

Don E. Garrett

OREGON
JULY 14, 1961
DON E. GARRETT
544

MAP FILE M 54-16