COUNTY SURVEYORS FILE DATA
DO NOT REMOVE FROM OFFICE

FILED ✓
RECEIVED ✓✓
SEP 12 1974
COUNTY SURVEYOR
DOUGLAS COUNTY, ORE.

MAP FILE M54 - 27

SURVEY FOR MRS. YOUNG

FOR CONVEYANCE OF A PORTION OF LOTS 3 & 4, BLOCK 12, BROWN'S ADDITION CITY OF OAKLAND, SECTION 4, T 25S, R 5W, W.M.

SEPT., 1974

BY HAROLD BALL - CIVIL ENGINEER - ROSEBURG, ORE.

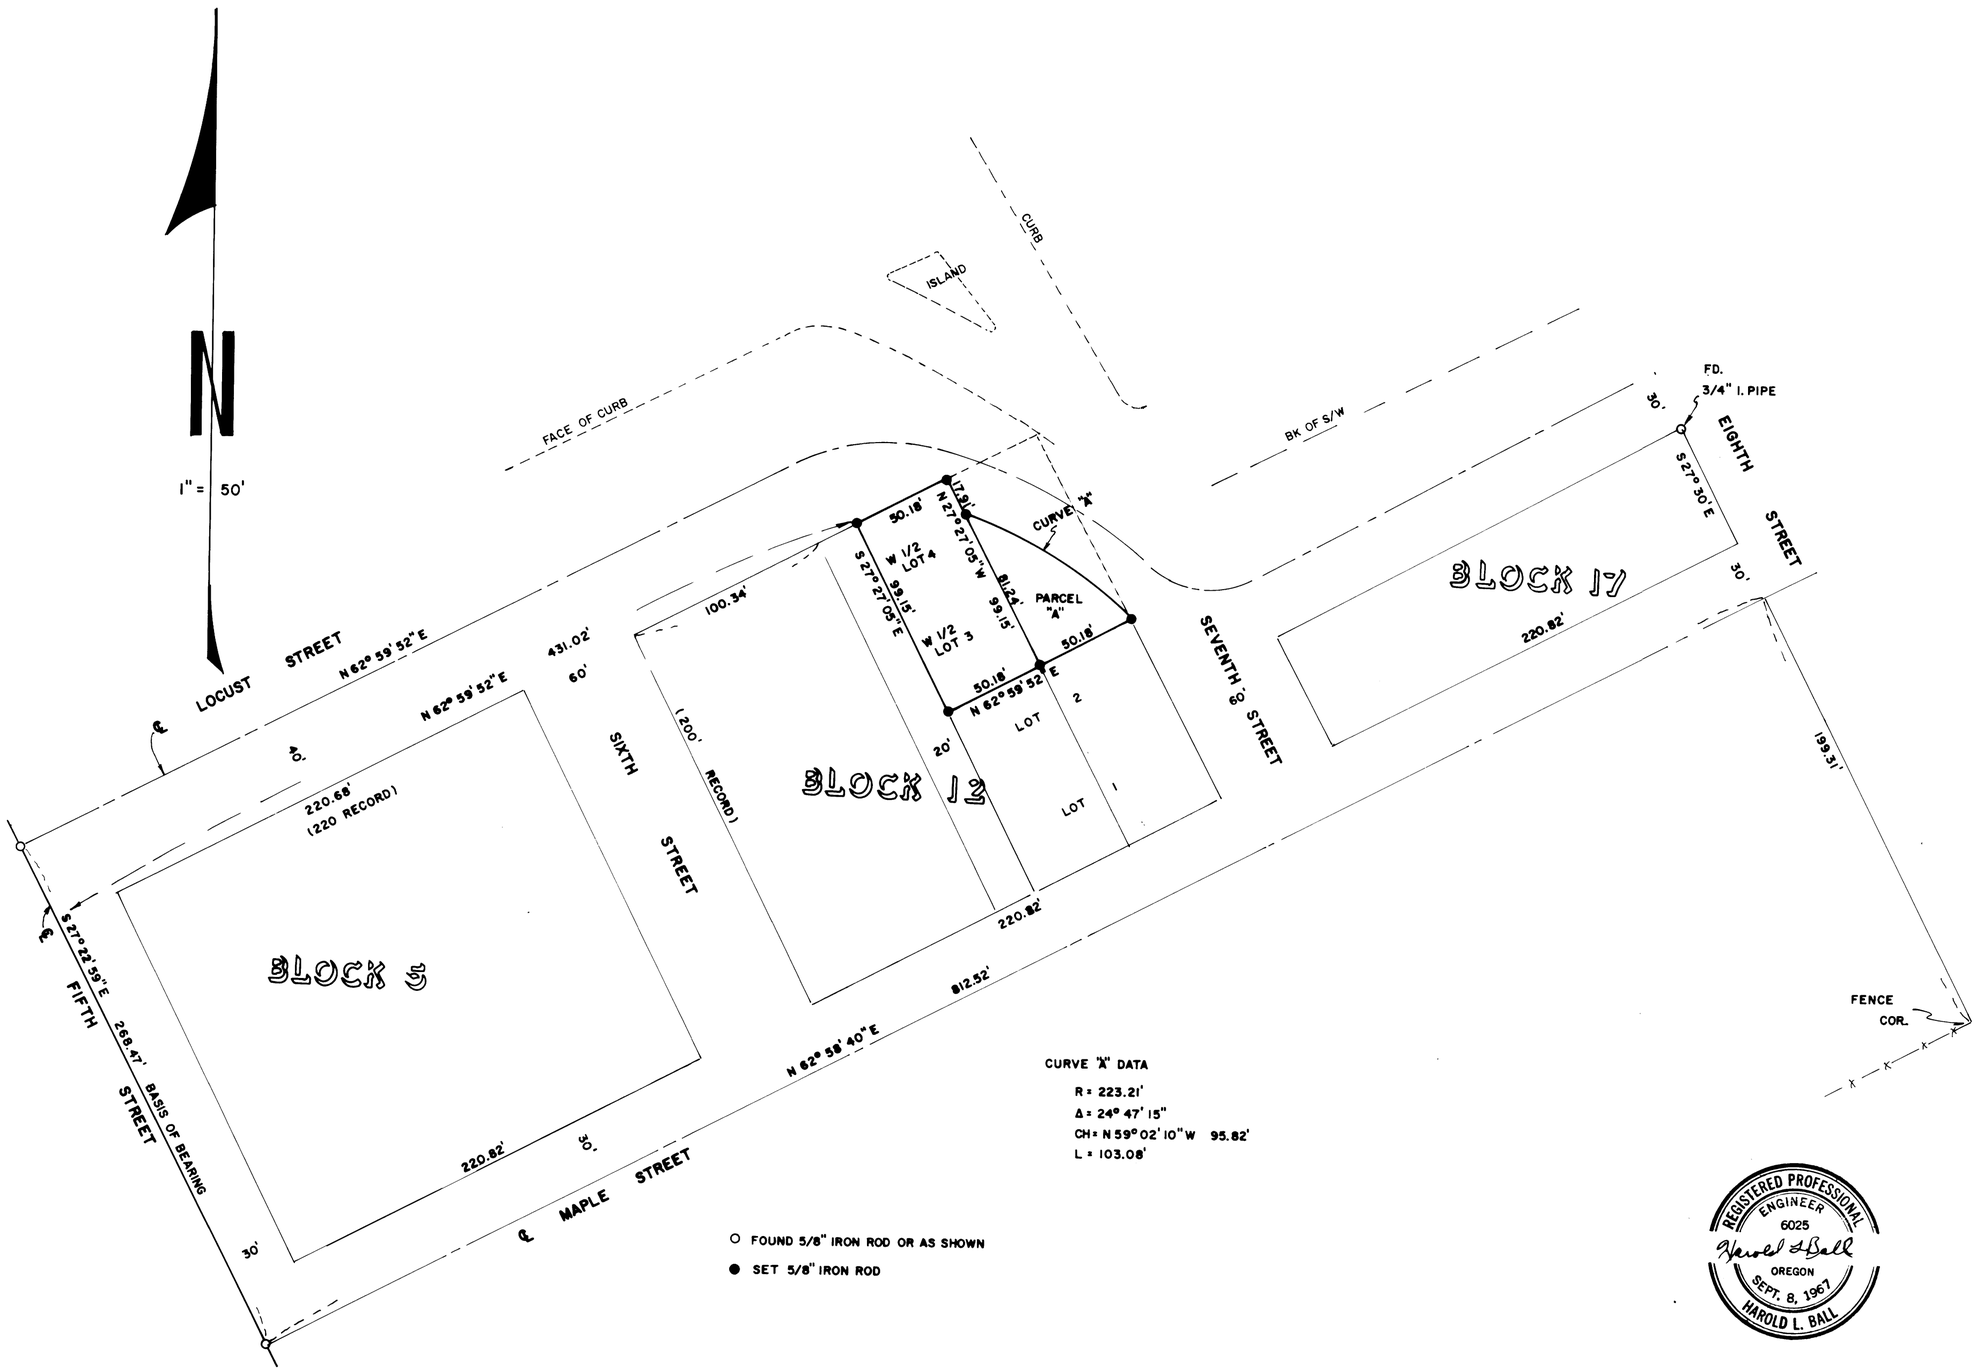

CURVE "A" DATA

R = 223.21'
Δ = 24° 47' 15"
CH = N 59° 02' 10" W 95.82'
L = 103.08'

○ FOUND 5/8" IRON ROD OR AS SHOWN
● SET 5/8" IRON ROD

REGISTERED PROFESSIONAL ENGINEER
6025
Harold L Ball
OREGON
SEPT. 8, 1967
HAROLD L. BALL

MAP FILE M54 - 27