SURVEY OF THE WEST LINE OF SECTION 18, T.25S.R.2W.W.M.
FOR: WEYERHAEUSER TIMBER COMPANY
BY: BAUGHMAN SURVEYING SERVICE

OCTOBER 1974 SCALE: 1" = 500'

COUNTY SURVEYORS FILE DATA
DO NOT REMOVE FROM OFFICE

FILED
RECEIVED KR

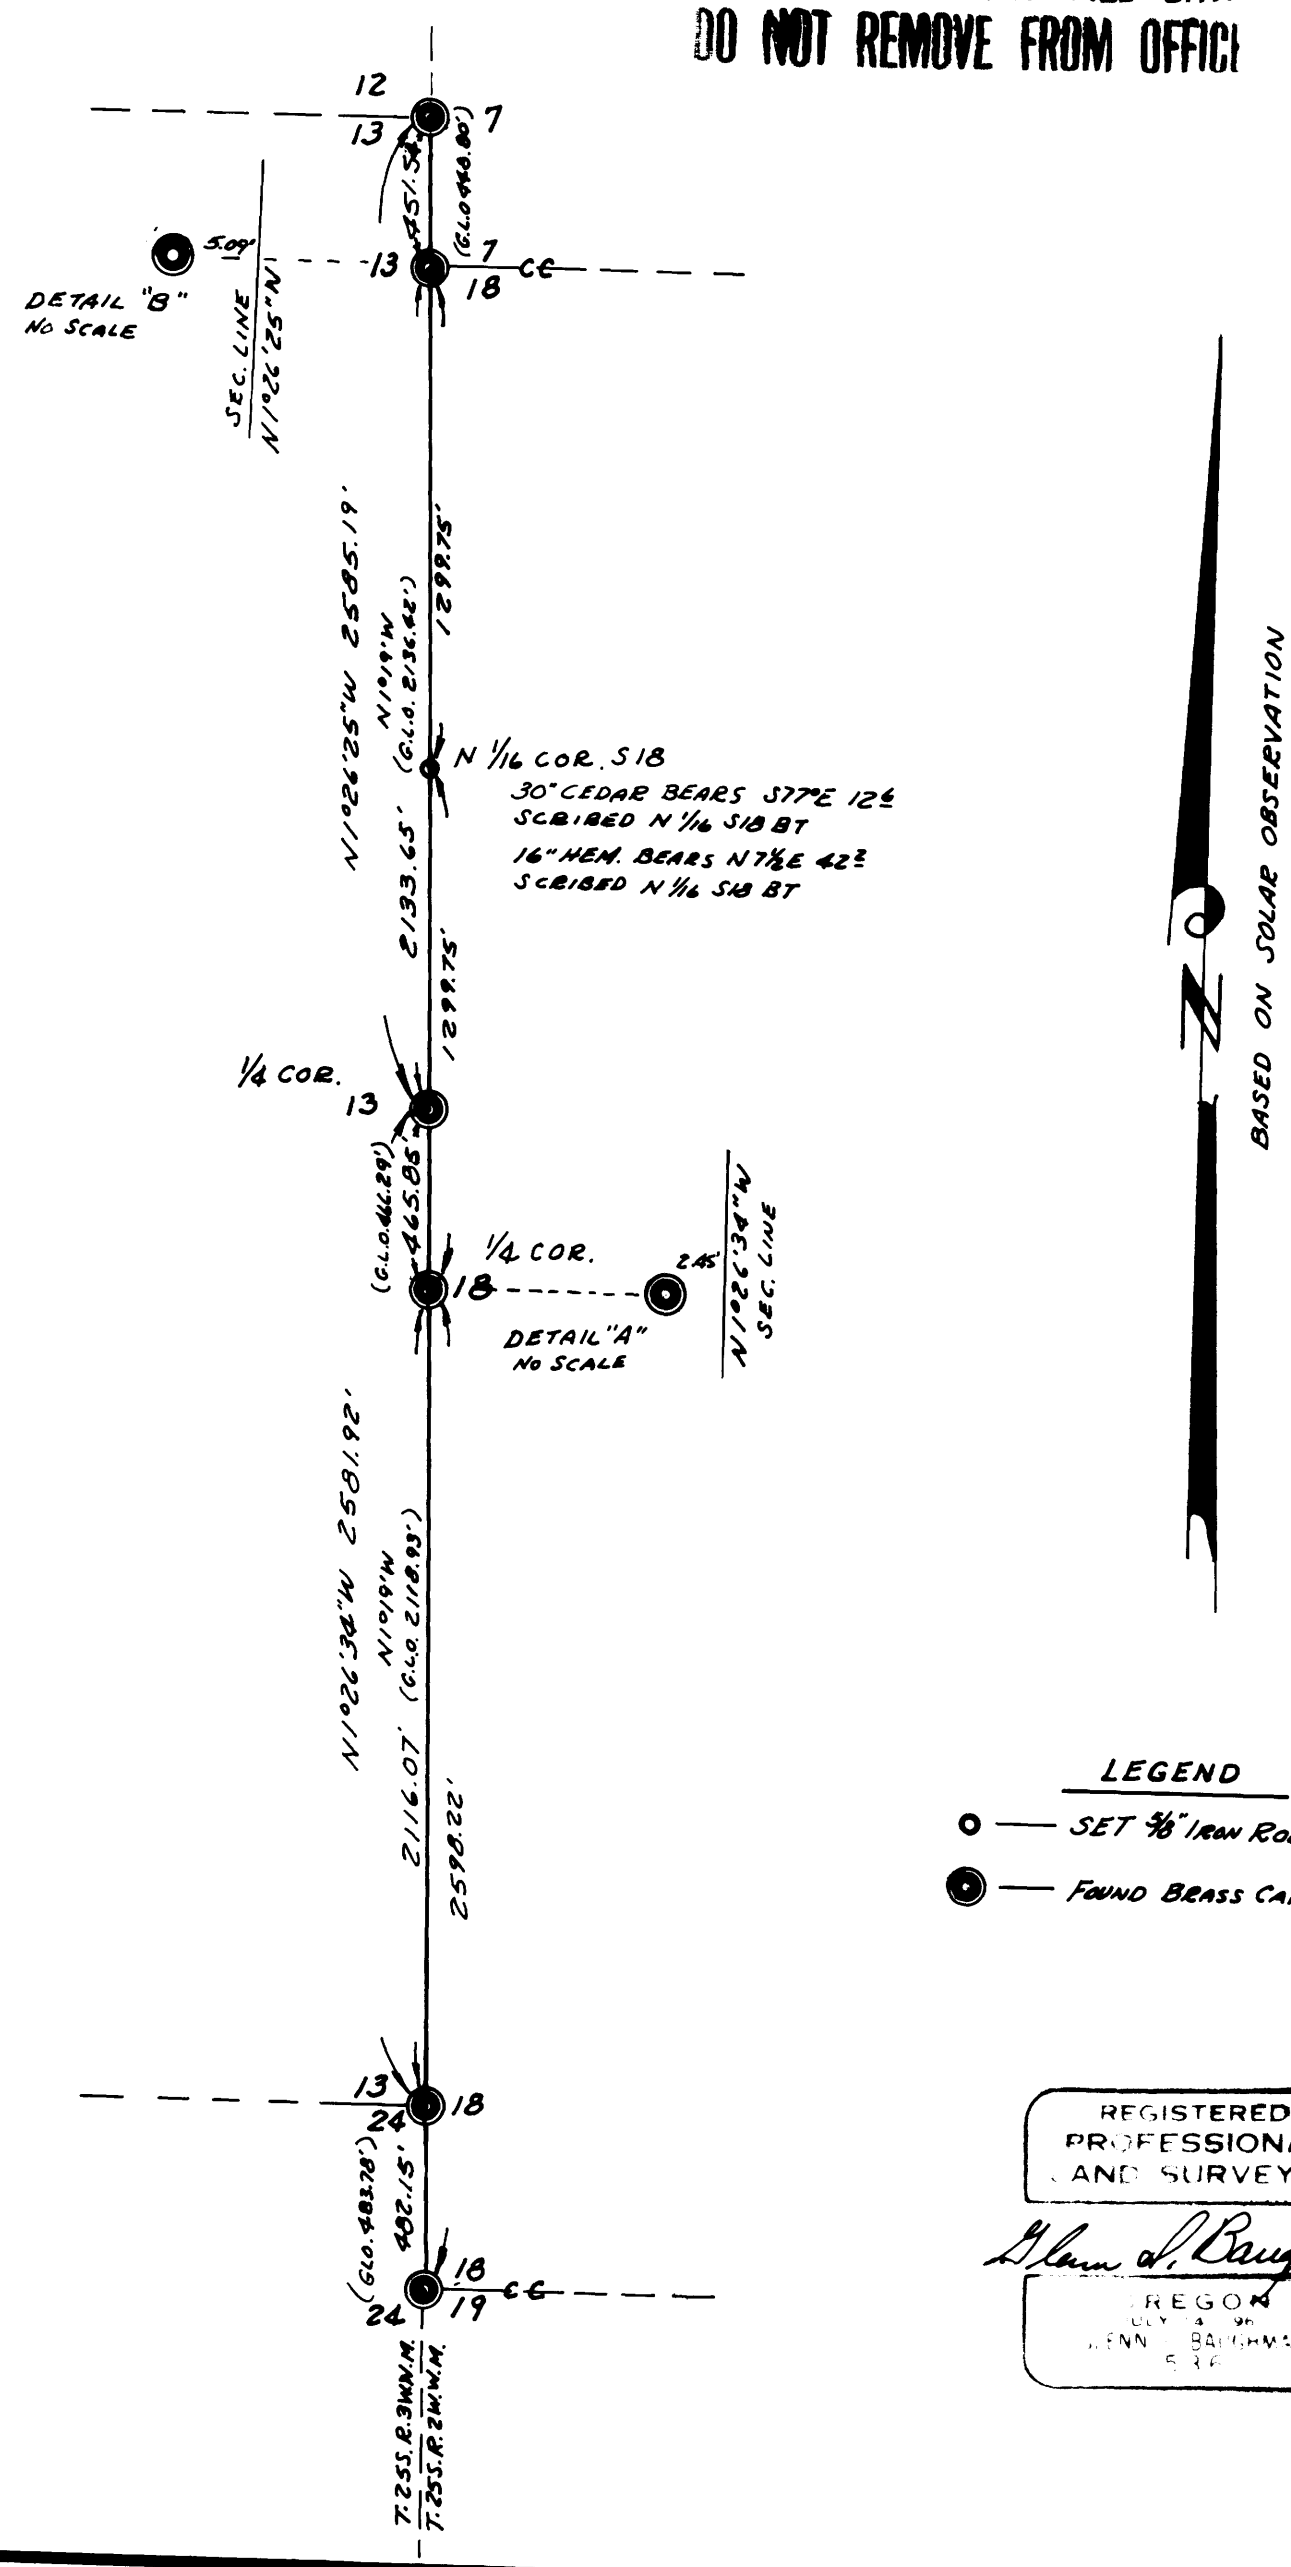

REGISTERED
PROFESSIONAL
LAND SURVEYOR

Glenn A. Baughman

OREGON
JULY 14, 1961
GLENN A. BAUGHMAN
5326

MAP FILE M54 46