COUNTY SURVEYORS FILE DATA
DO NOT REMOVE FROM OFFICE

FILED
RECEIVED
NOV 1 - 1974
COUNTY SURVEYOR
DOUGLAS COUNTY, ORE.

MAP FILE M54-58

SURVEY TO SET PROPERTY CORNERS
IN SECTIONS 27 & 28, T. 26S. R.6W.W.M.

FOR: DONALD GAMBILL

BY: BAUGHMAN SURVEYING SERVICE

OCTOBER 1974 SCALE: 1" = 200'

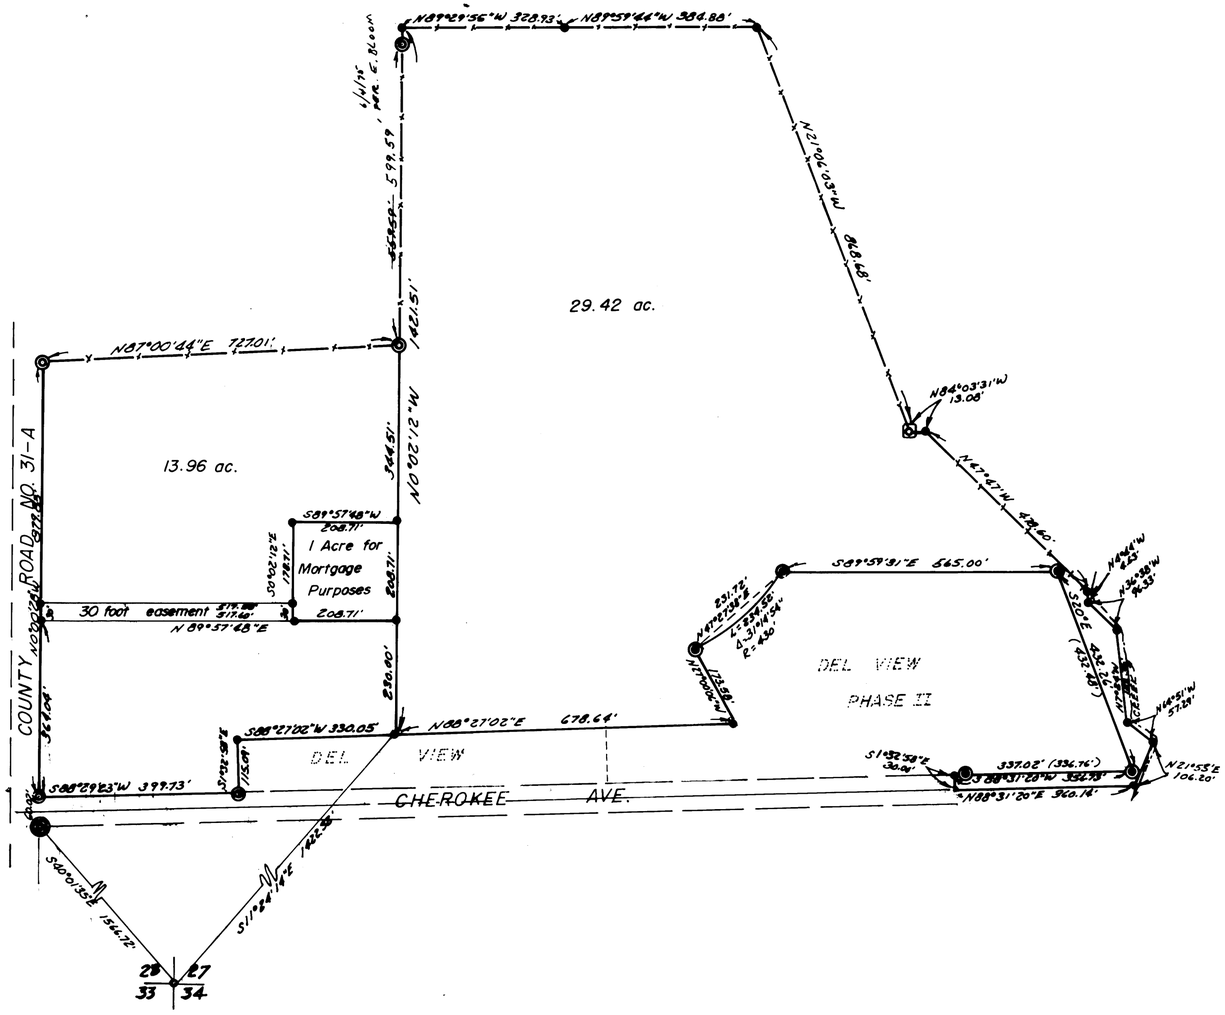

LEGEND

- Calc. per plat Del View
- Set 1/2" iron rod
- Found 1/2" iron pipe
- Found 5/8" iron rod
- Found 2" iron pipe
- Found 5/8" wood screw in conc.
- Fence Line

REGISTERED PROFESSIONAL LAND SURVEYOR

Glenn A. Baughman

REG. NO. 1396
GLENN A. BAUGHMAN

M54-58