COUNTY SURVEYORS FILE DOC.
DO NOT REMOVE FROM OFFICE

FILED
RECEIVED KR
NOV 19 1974
COUNTY SURVEYOR
DOUGLAS COUNTY, ORE.
mf

SURVEY IN SEC. 6, T29S, R5W. W.M.
DOUGLAS COUNTY, ORE.

SURVEYED FOR - EUGENE MARSHALL — NOV. 1974
SURVEYED BY - W. S. BARNES — SCALE 1"=400'

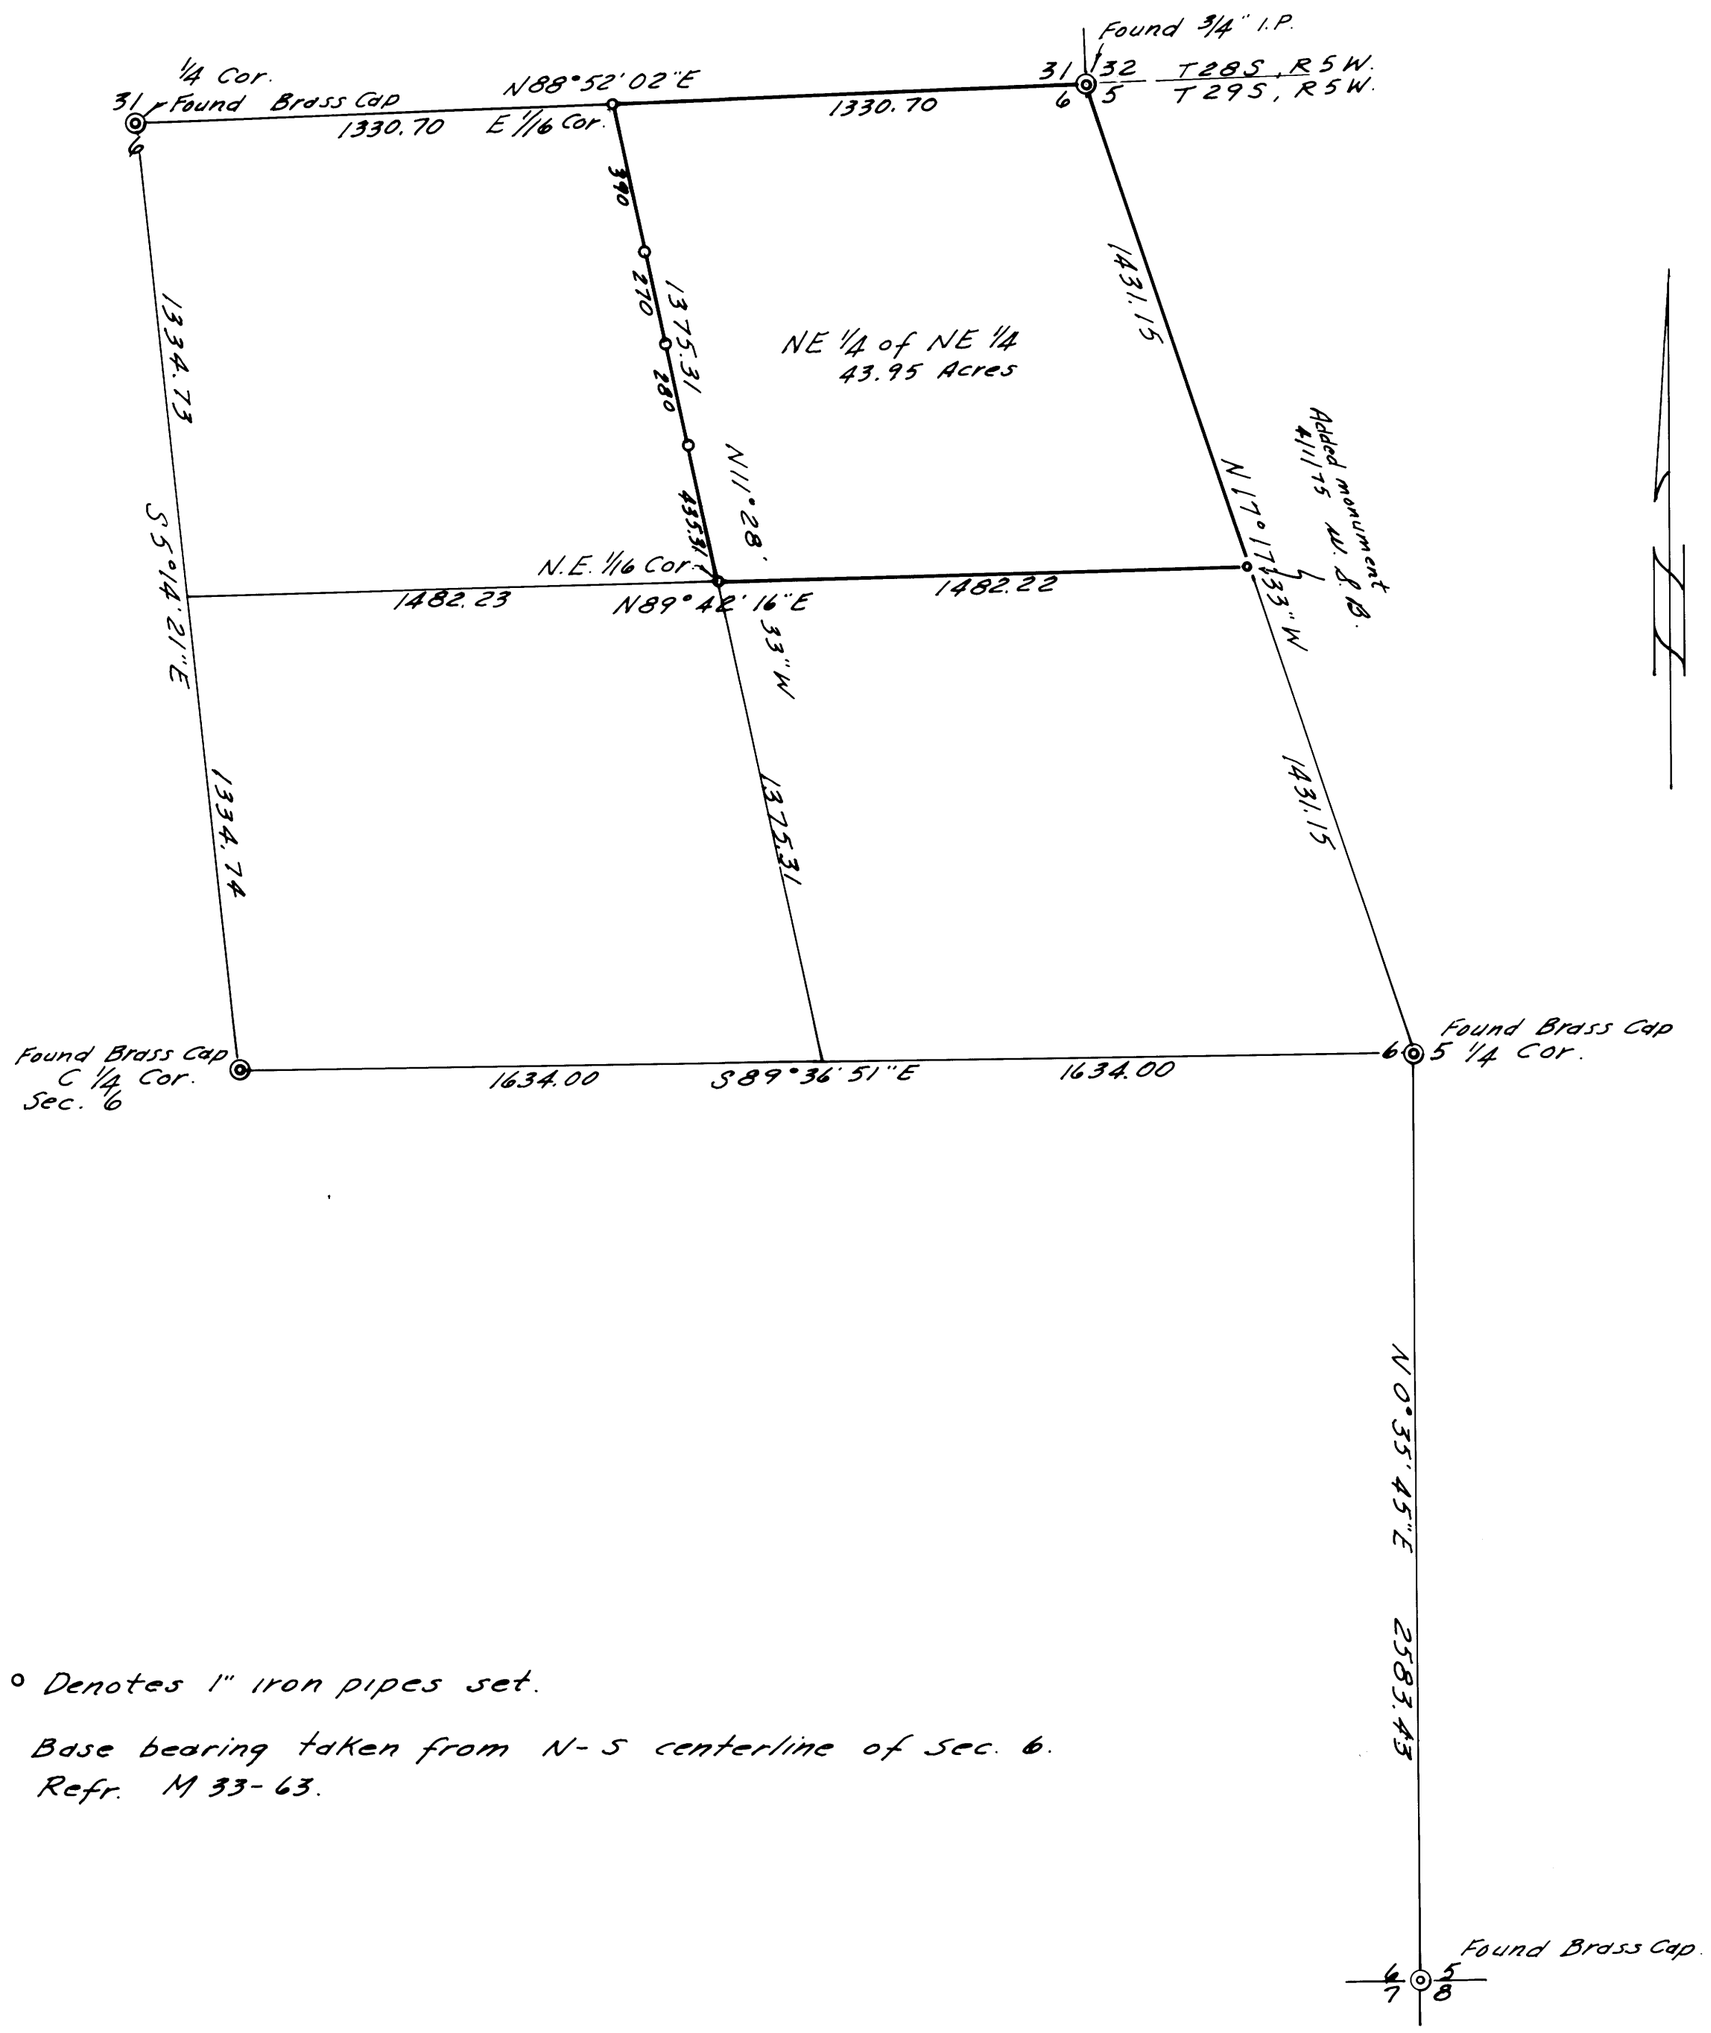

° Denotes 1" iron pipes set.

Base bearing taken from N-S centerline of Sec. 6.
Refr. M 33-63.

W. S. Barnes