

FILED
RECEIVED

NOV 26 1974


COUNTY SURVEYOR
DOUGLAS COUNTY, ORE.

SECT 16, T.22 S., R.5 W. W. M.

CHAS. OFF. For DRAIN, Oregon.

Scale 1" = 100'

NOV. 1974

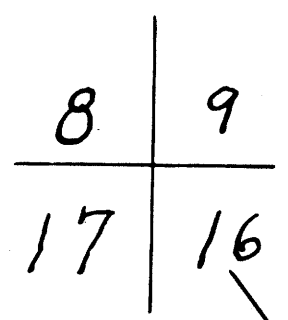

Vol 54 Mortgage Record Page 105

Deed record West 12.25 chs = 000.5 ft

N. 89° 21' W 469.70 809.13 339.43

Set bolt at fence corner

Set 1/2" pipe Power pole East 5.4 ft.

Found Rock At fence corner Set 1/2" pipe

7 1/2 ACRES

SOUTH 246.95

Set 1/2" pipe

S59° 23' E 134.17

600' S21° 23' E 70.00

N. 89° 34' E. 135.66

S78° 18' E 150.19

Cemetery

S66° 12' E.

Set 5" steel Rod on fence line

405.80 ROAD

N. 74° 38' 15" E. To 4 5 9 16 Deed records

N. 1° 26' W.

530.19

North ↑
Based on N2°53'E.
East city limits of Drain

REGISTERED
OREGON
LAND SURVEYOR

Wilford N. Haines

MAY 7, 1948
WILFORD N. HAINES
239