MAP FILE M54 - 74

COUNTY SURVEYORS FILE DATA
DO NOT REMOVE FROM OFFICE

SURVEY TO LOCATE PROPERTY CORNER FOR 10.6 AC. PARCEL & DESCRIPTIONS FOR 10.6 AC. & 29.5 AC. IN SEC. 2 T. 28 S., R. 7 W., W.M., DOUGLAS CO., ORE.

FOR BOB COMPTON - LARRY CHRISENBERRY - DAN RHOADS

BY HERBERT L. NORTHCRAFT DEC. 1974 SCALE 1" = 100'

FILED
RECEIVED K.R.
COUNTY SURVEYOR
DOUGLAS COUNTY, ORE.

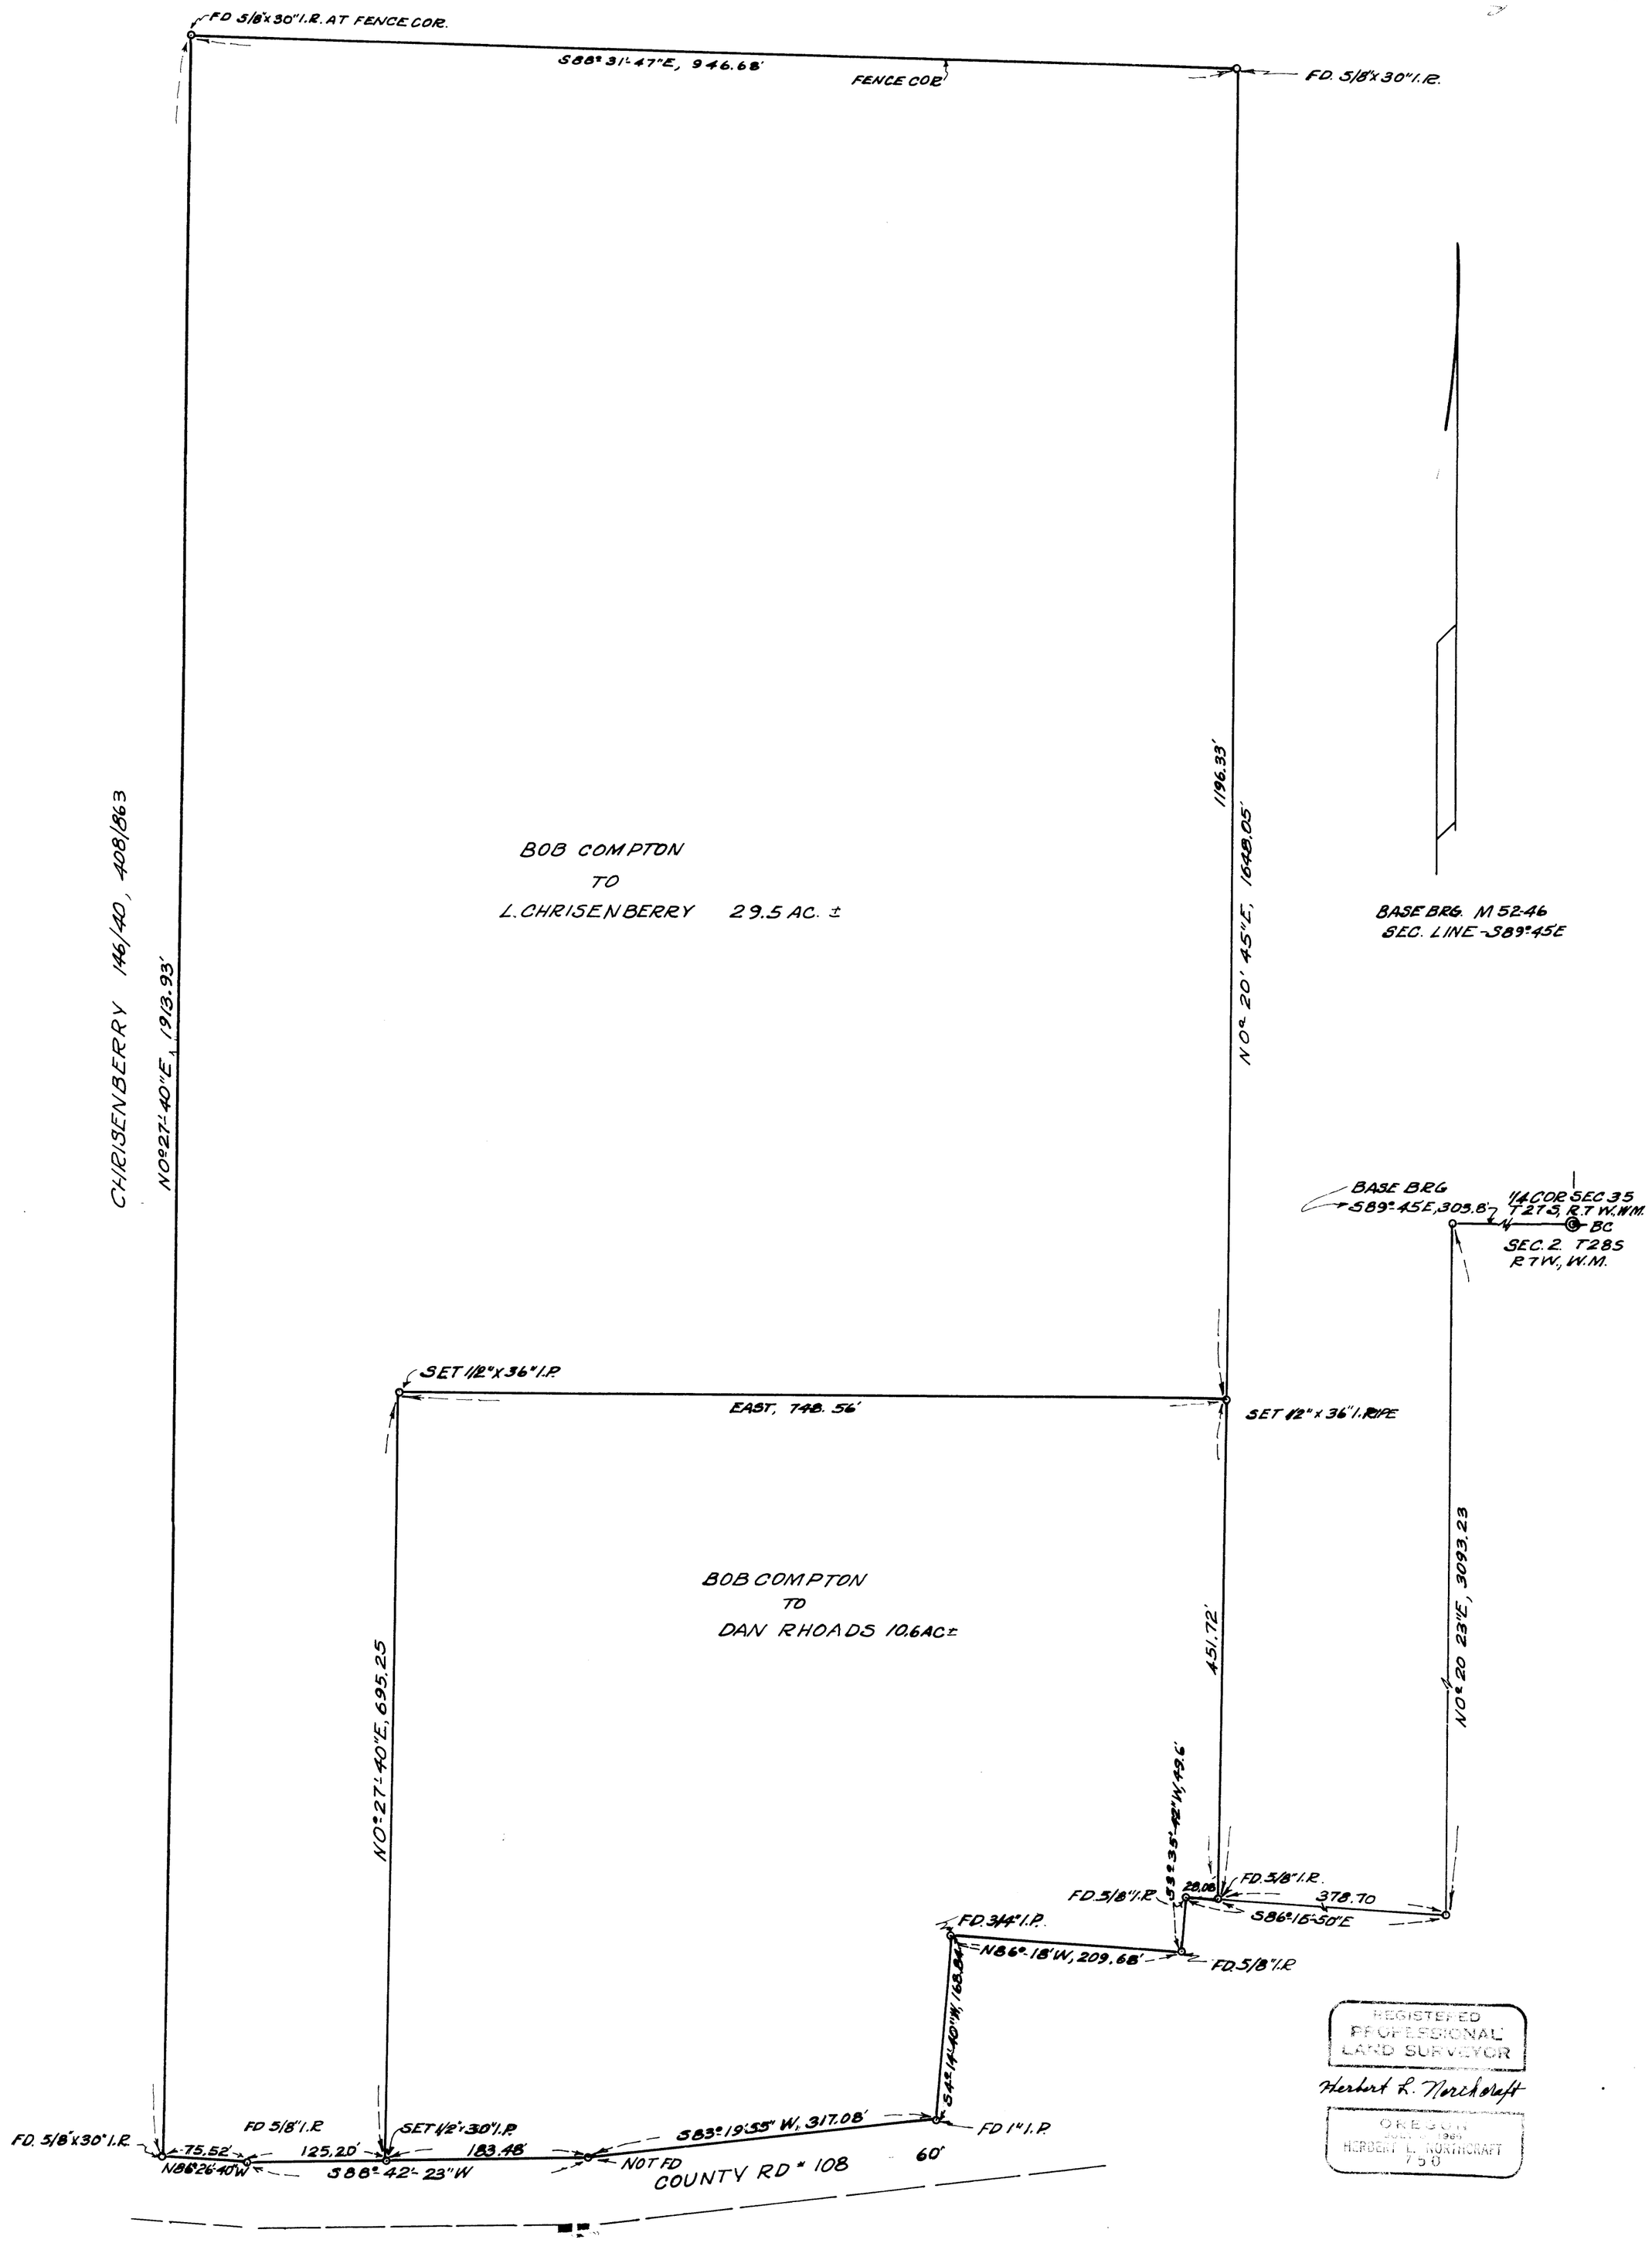

REGISTERED PROFESSIONAL LAND SURVEYOR
Herbert L. Northcraft
OREGON
JULY 1, 1969
HERBERT L. NORTHCRAFT
750

MAP FILE M54 - 74