MAP FILE M55 - 17

SURVEY FOR PROPERTY CORNERS
LOTS 13 & 14, BLOCK 3 THOMAS SUBDIVISION
IN SECTION 12, T.27S. R.6W. W.M.

FOR: GEORGE LA GRANDER

BY: BAUGHMAN SURVEYING SERVICE

DECEMBER 1974 SCALE: 1"=50'

COUNTY SURVEYORS FILE DATA
DO NOT REMOVE FROM OFFICE

FILED
RECEIVED
JAN 10 1975
COUNTY SURVEYOR
DOUGLAS COUNTY, ORE.

REGISTERED PROFESSIONAL LAND SURVEYOR
GLENN L. BAUGHMAN

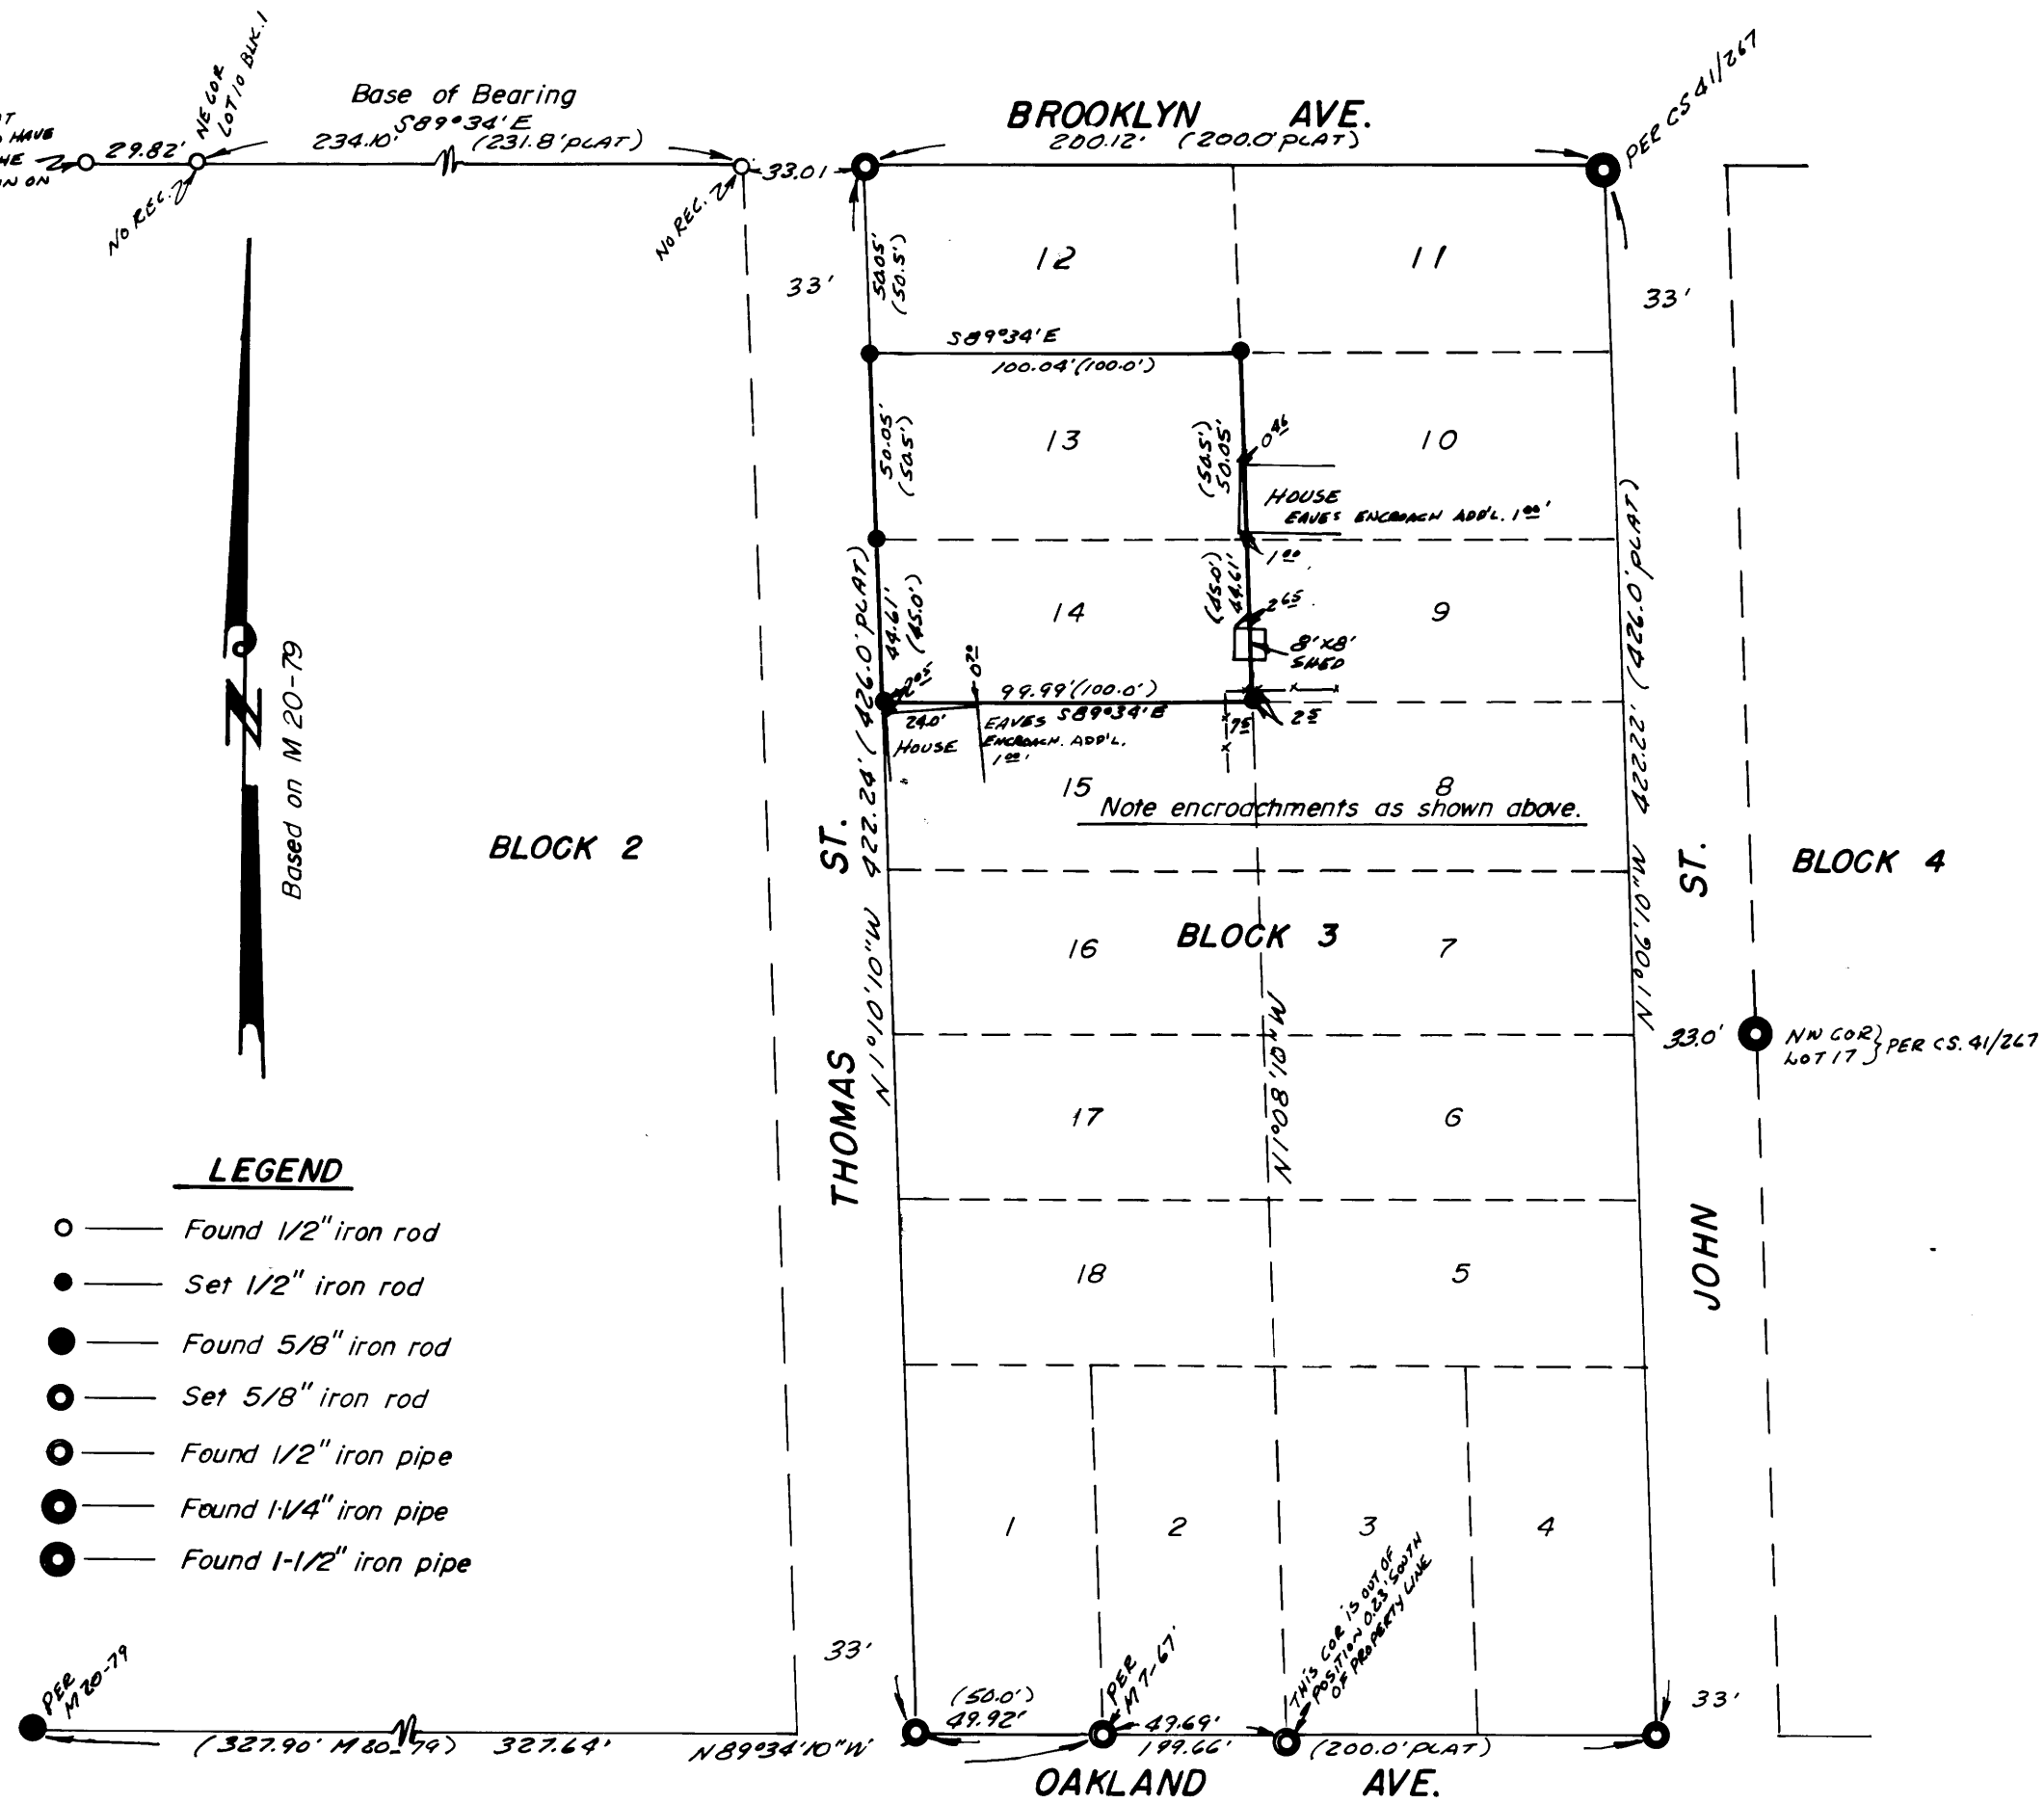

MAP FILE M55 - 17