COUNTY SURVEYORS FILE DATA
DO NOT REMOVE FROM OFFICE

SURVEY TO SET PROPERTY CORNERS & DESCRIPTION
IN SECTION 27, T.30S. R.5W. W.M.
FOR: JENKINS & SEVERTSON
BY: BAUGHMAN SURVEYING SERVICE

DECEMBER 1974 SCALE: 1"=50'

FILED
RECEIVED
JAN 2 1975
COUNTY SURVEYOR
DOUGLAS COUNTY, OREGON

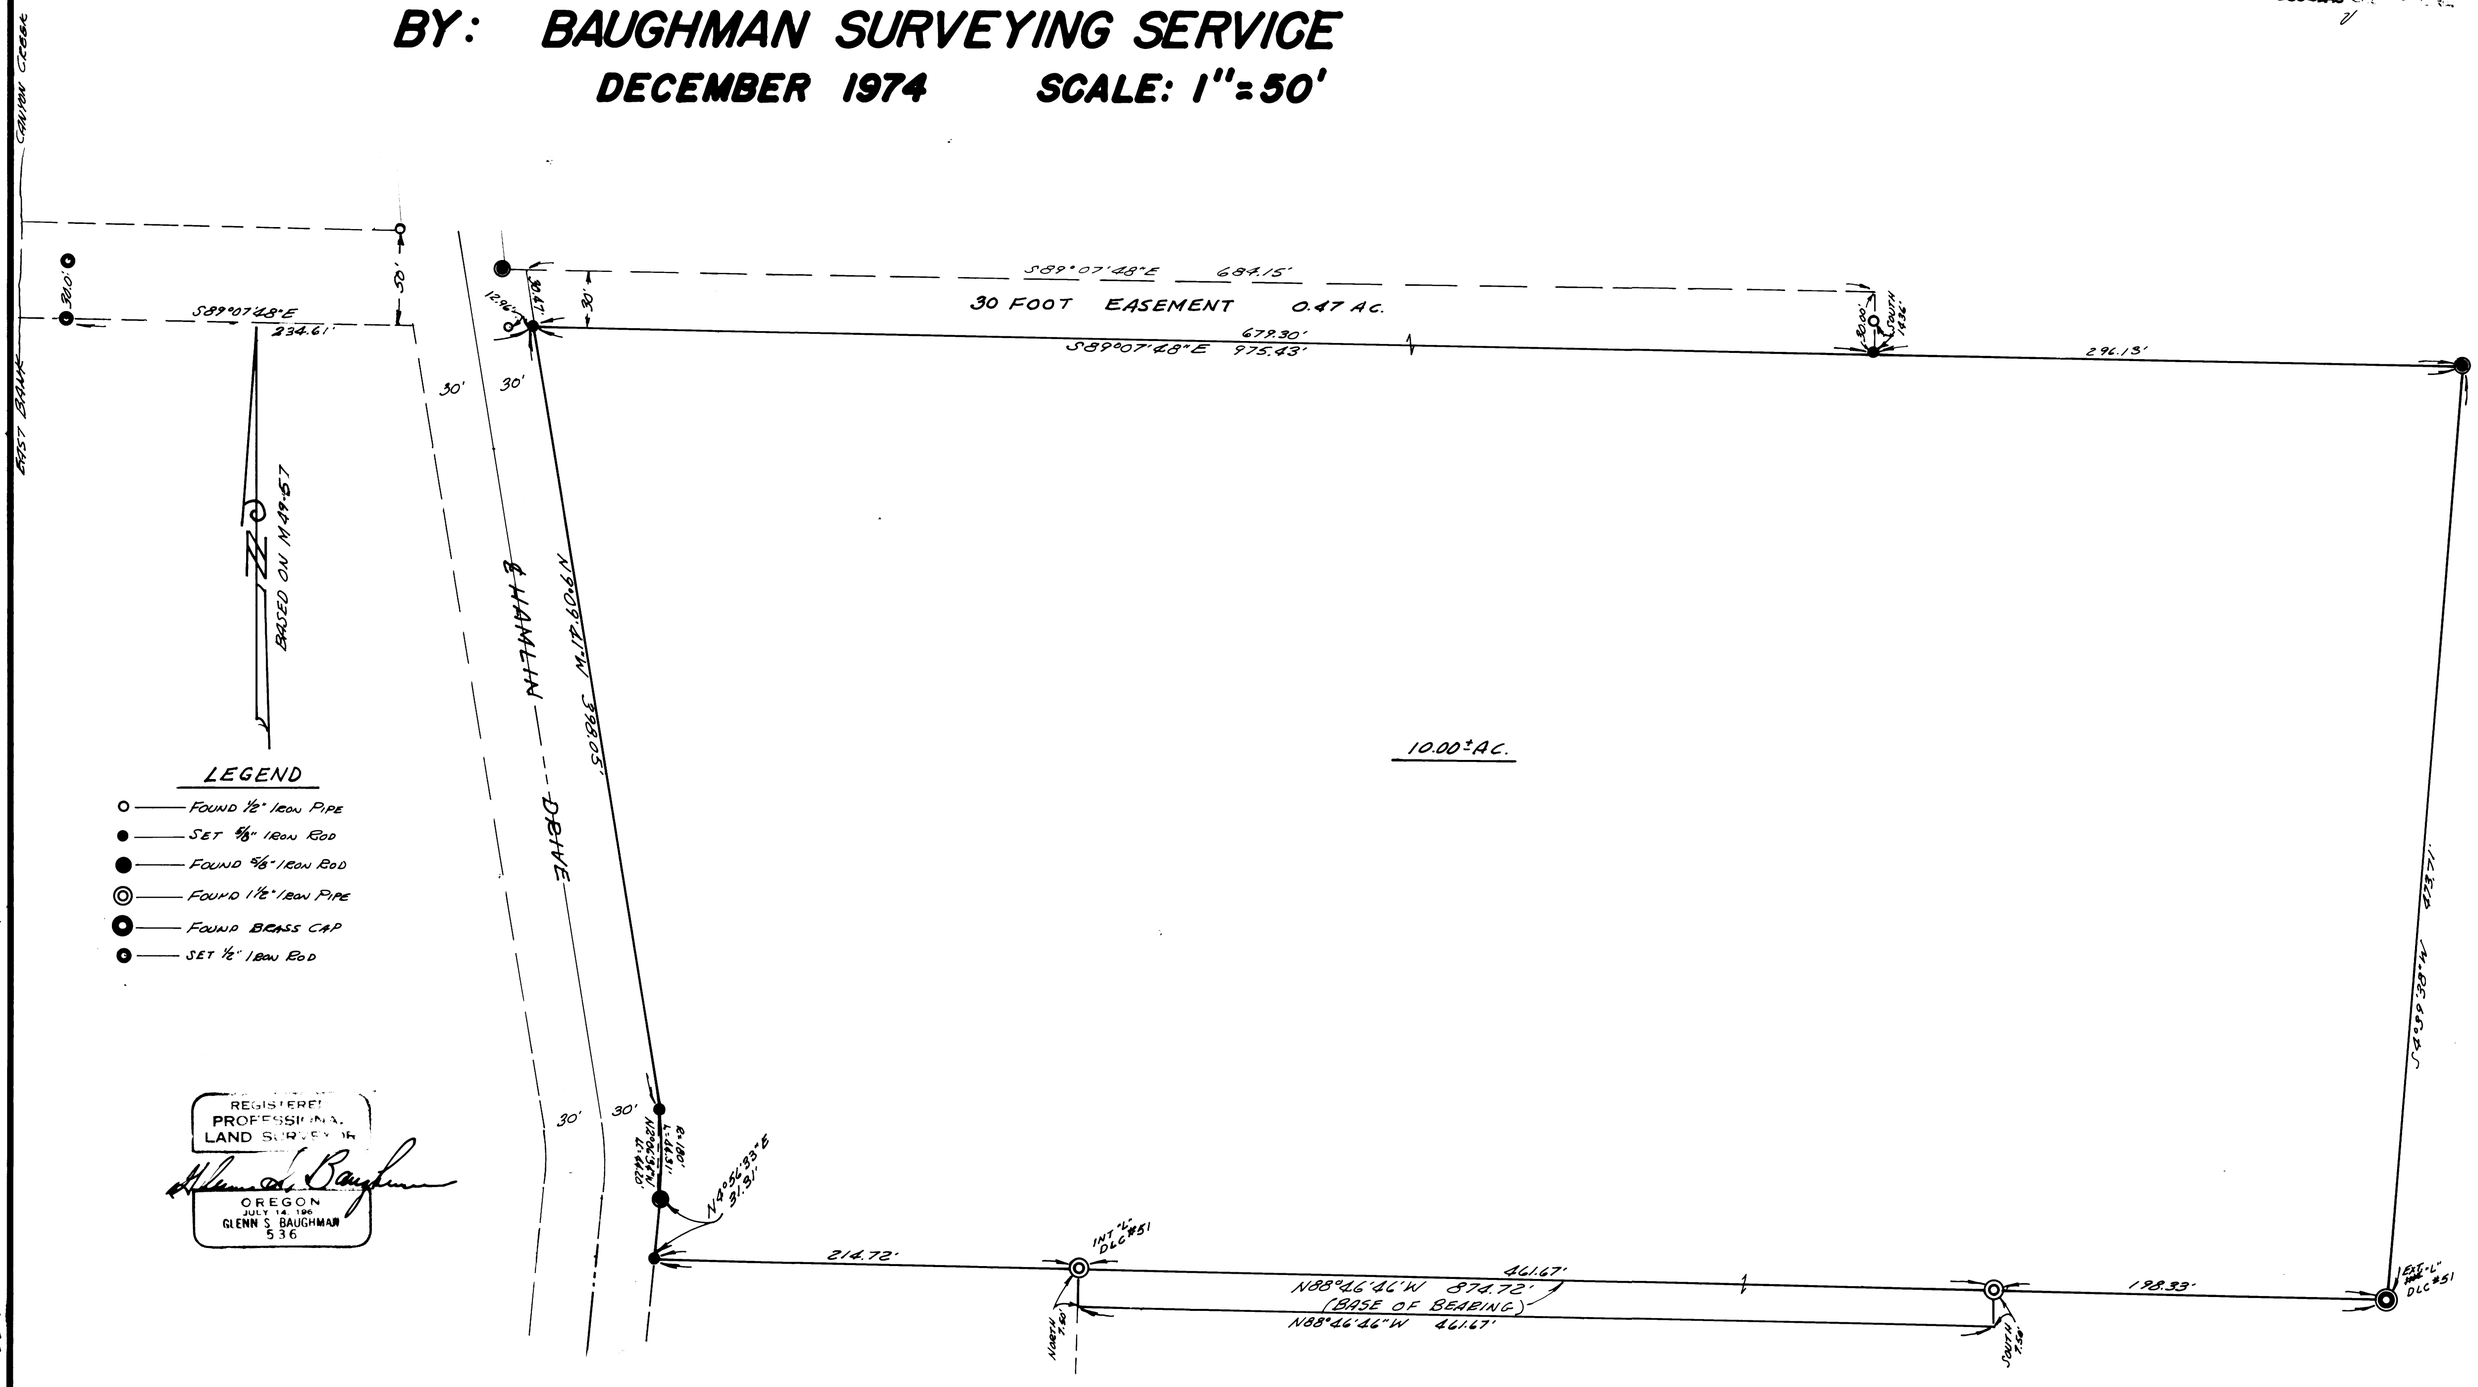

MAP FILE M55-21