MAP FILE M55-52

COUNTY SURVEYORS FILE DA...
DO NOT REMOVE FROM OFFICE

FILED
RECEIVED
MAR 19 1975
COUNTY SURVEYOR
DOUGLAS COUNTY, ORE.

SURVEY FOR DEED DESCRIPTIONS
IN SEC. 21, T.28S., R.6W.W.M.
FOR WM. BETTS GLEN JR.
by BRUCE ROGERS
MAR., 1975
1"=50'

Bruce R. Rogers

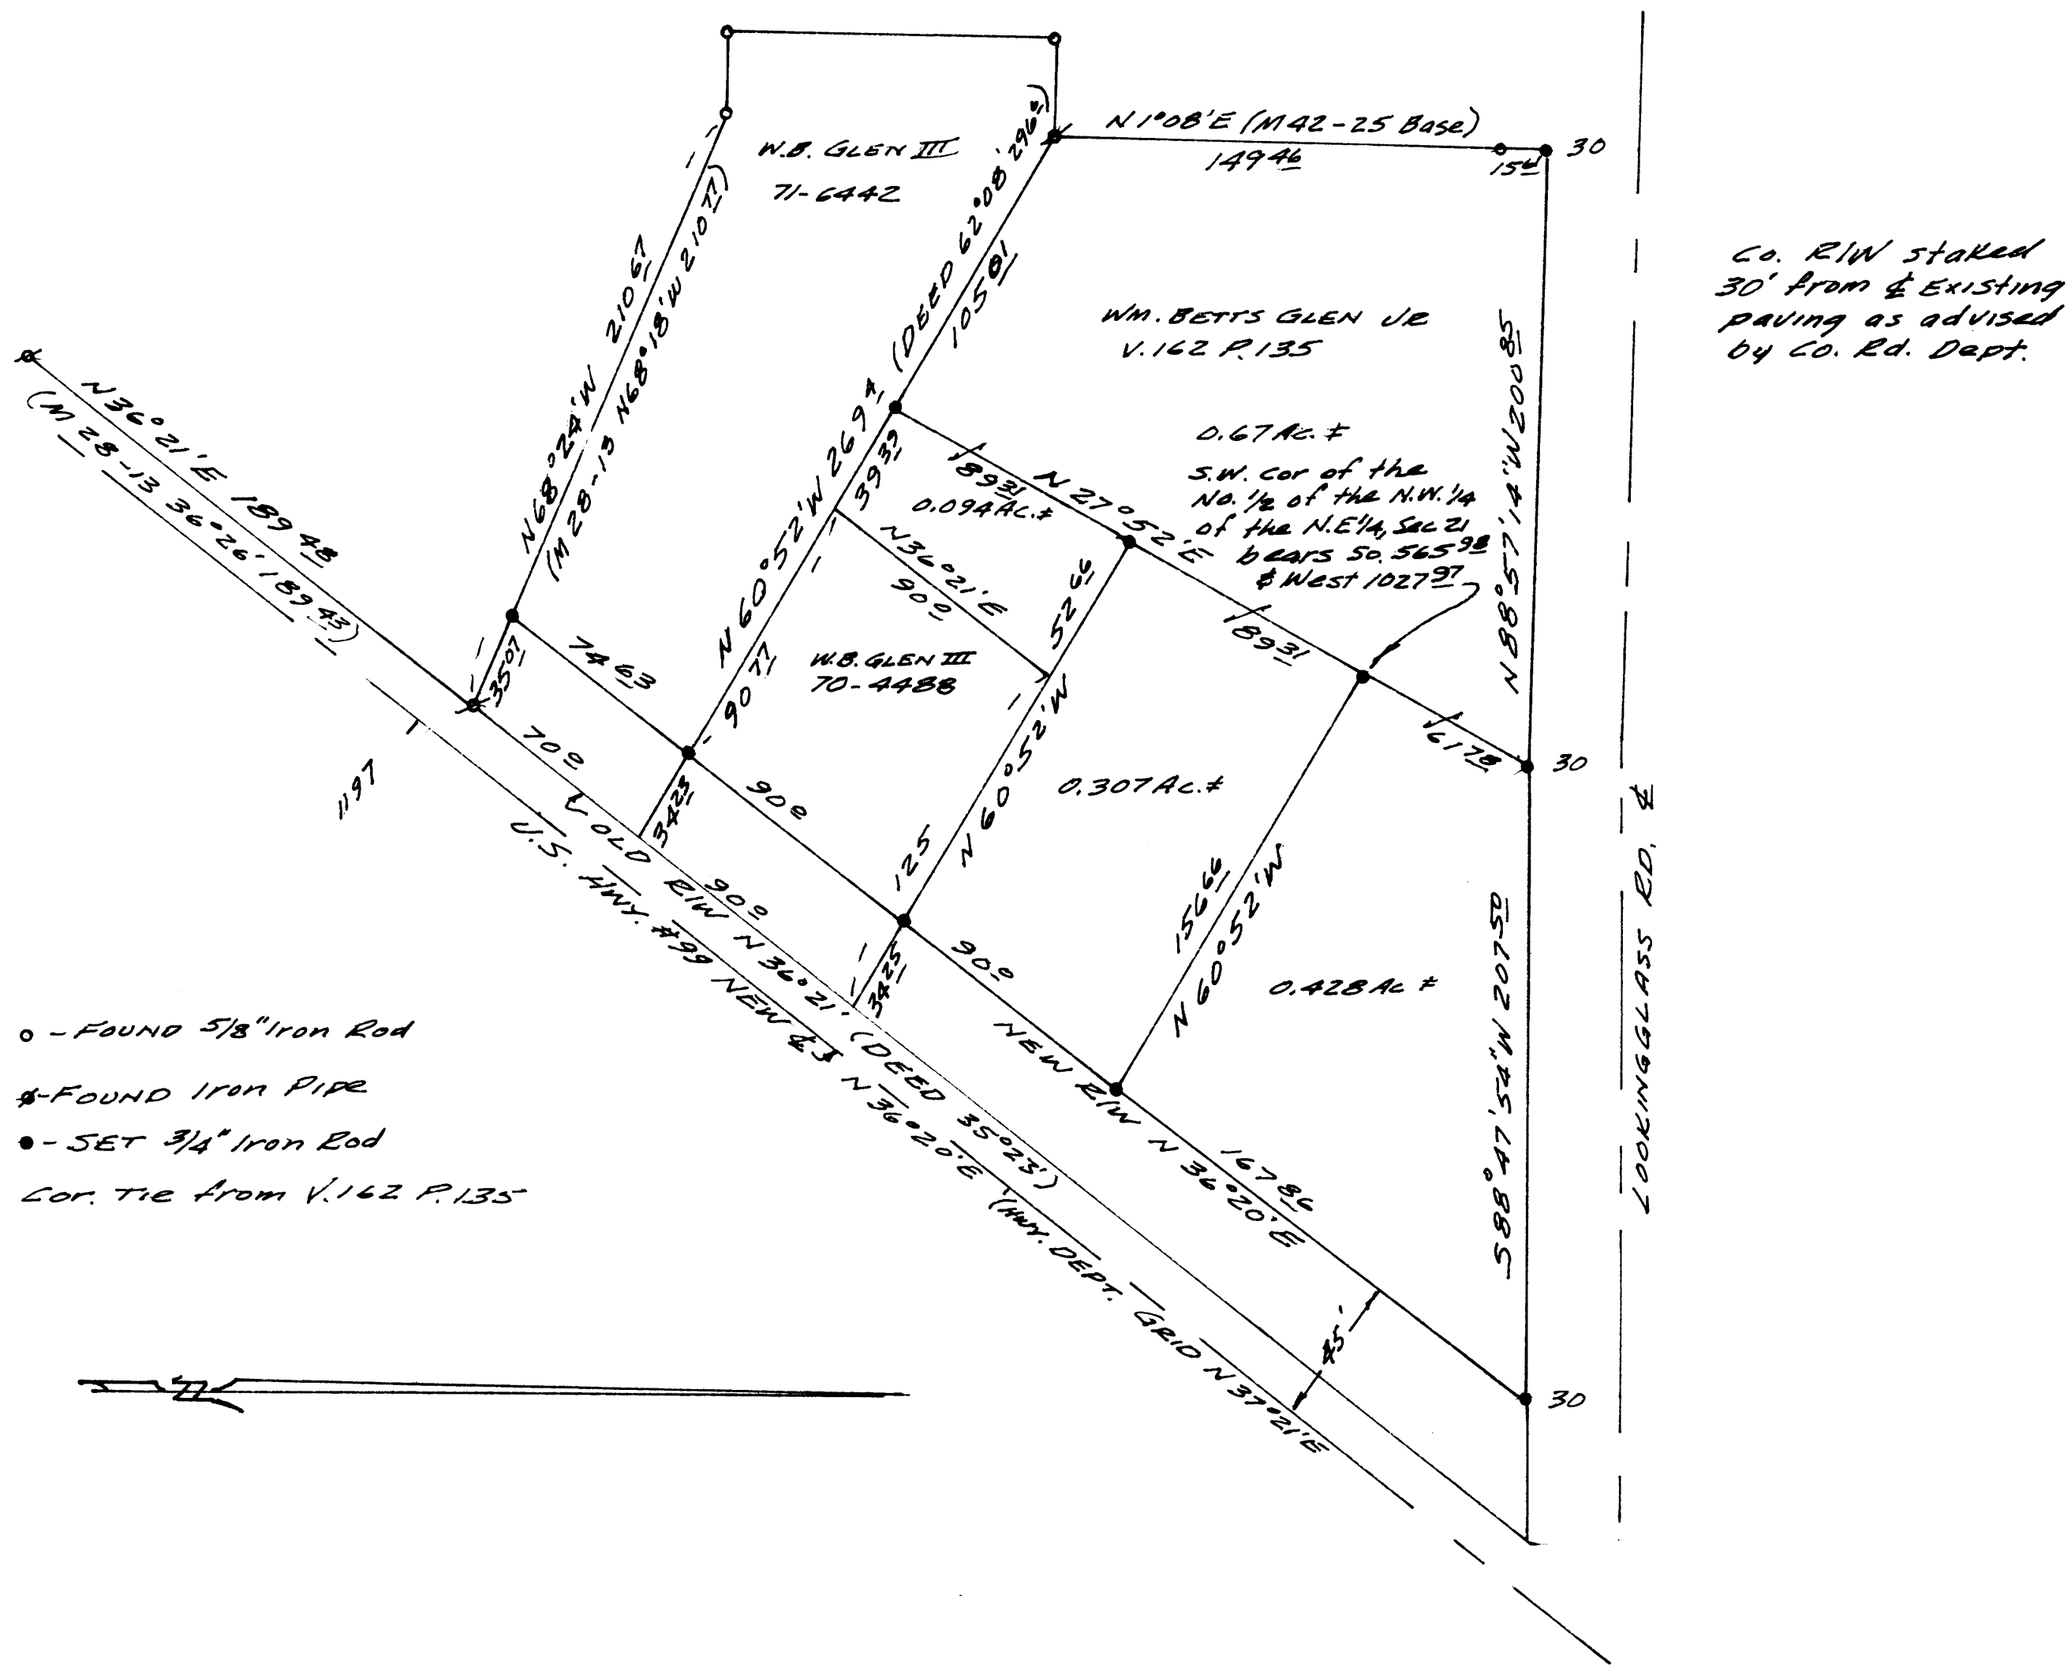

Co. R/W staked 30' from ℄ Existing paving as advised by Co. Rd. Dept.

MAP FILE M55-52