M55-9

COUNTY SURVEYORS FILE DATA
DO NOT REMOVE FROM OFFICE

KR
6
COUNTY SURVEYOR
DOUGLAS COUNTY, ORE.

SURVEY FOR DEED DESCRIPTION IN SEC. 33, T 26 S, R 3 W, W.M.

Surveyed for Oliver P. & Betty Ann Standley by Victor M. McLind

December 1974 — Scale: 1" = 200'

• — Indicates Found 5/8" Iron Rod

○ — Indicates Set 5/8" x 30" Iron Rod

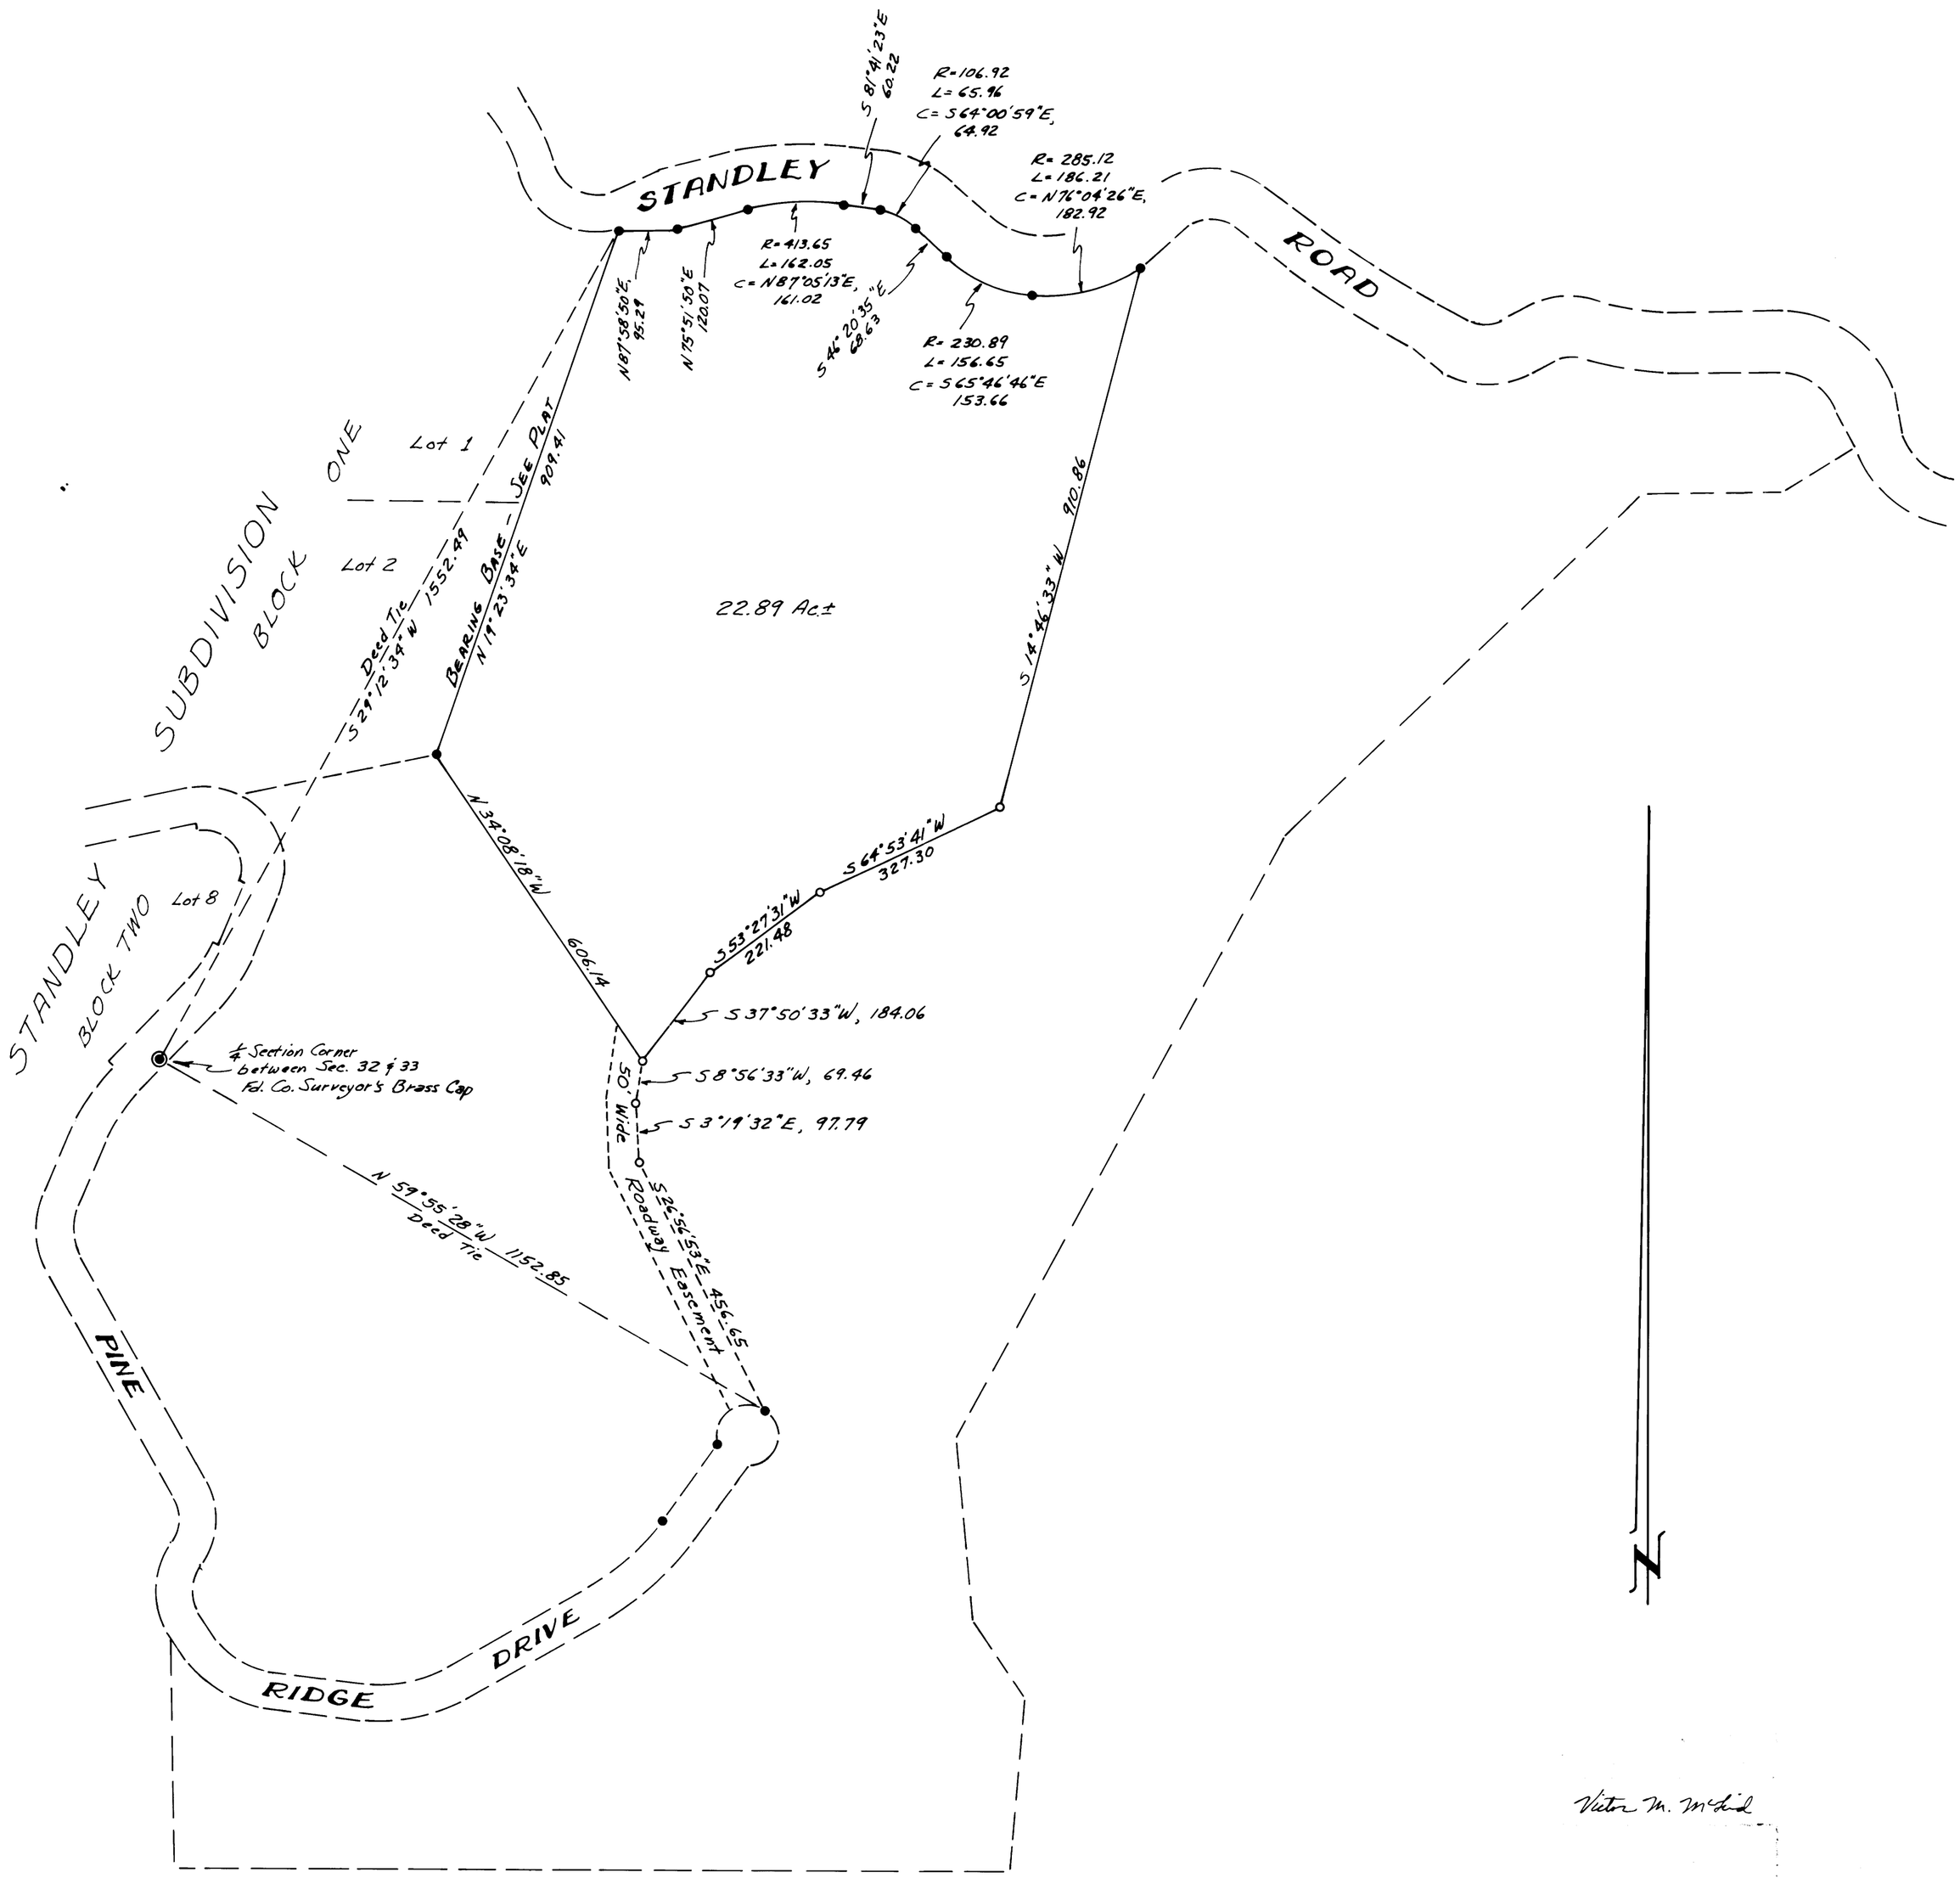

Victor M. McLind

M55-9