MAP FILE M-56 - 15

# SURVEY TO SET PROPERTY CORNERS IN SECTION 31, T.31S. R.3W.W.M.

FOR: PRAM REALTY

BY: BAUGHMAN SURVEYING SERVICE

JUNE 1975 SCALE: 1" = 400'

COUNTY SURVEYORS FILE DATA
DO NOT REMOVE FROM OFFICE

FILED
RECEIVED
JUN 9 1975
COUNTY SURVEYOR
DOUGLAS COUNTY, ORE.

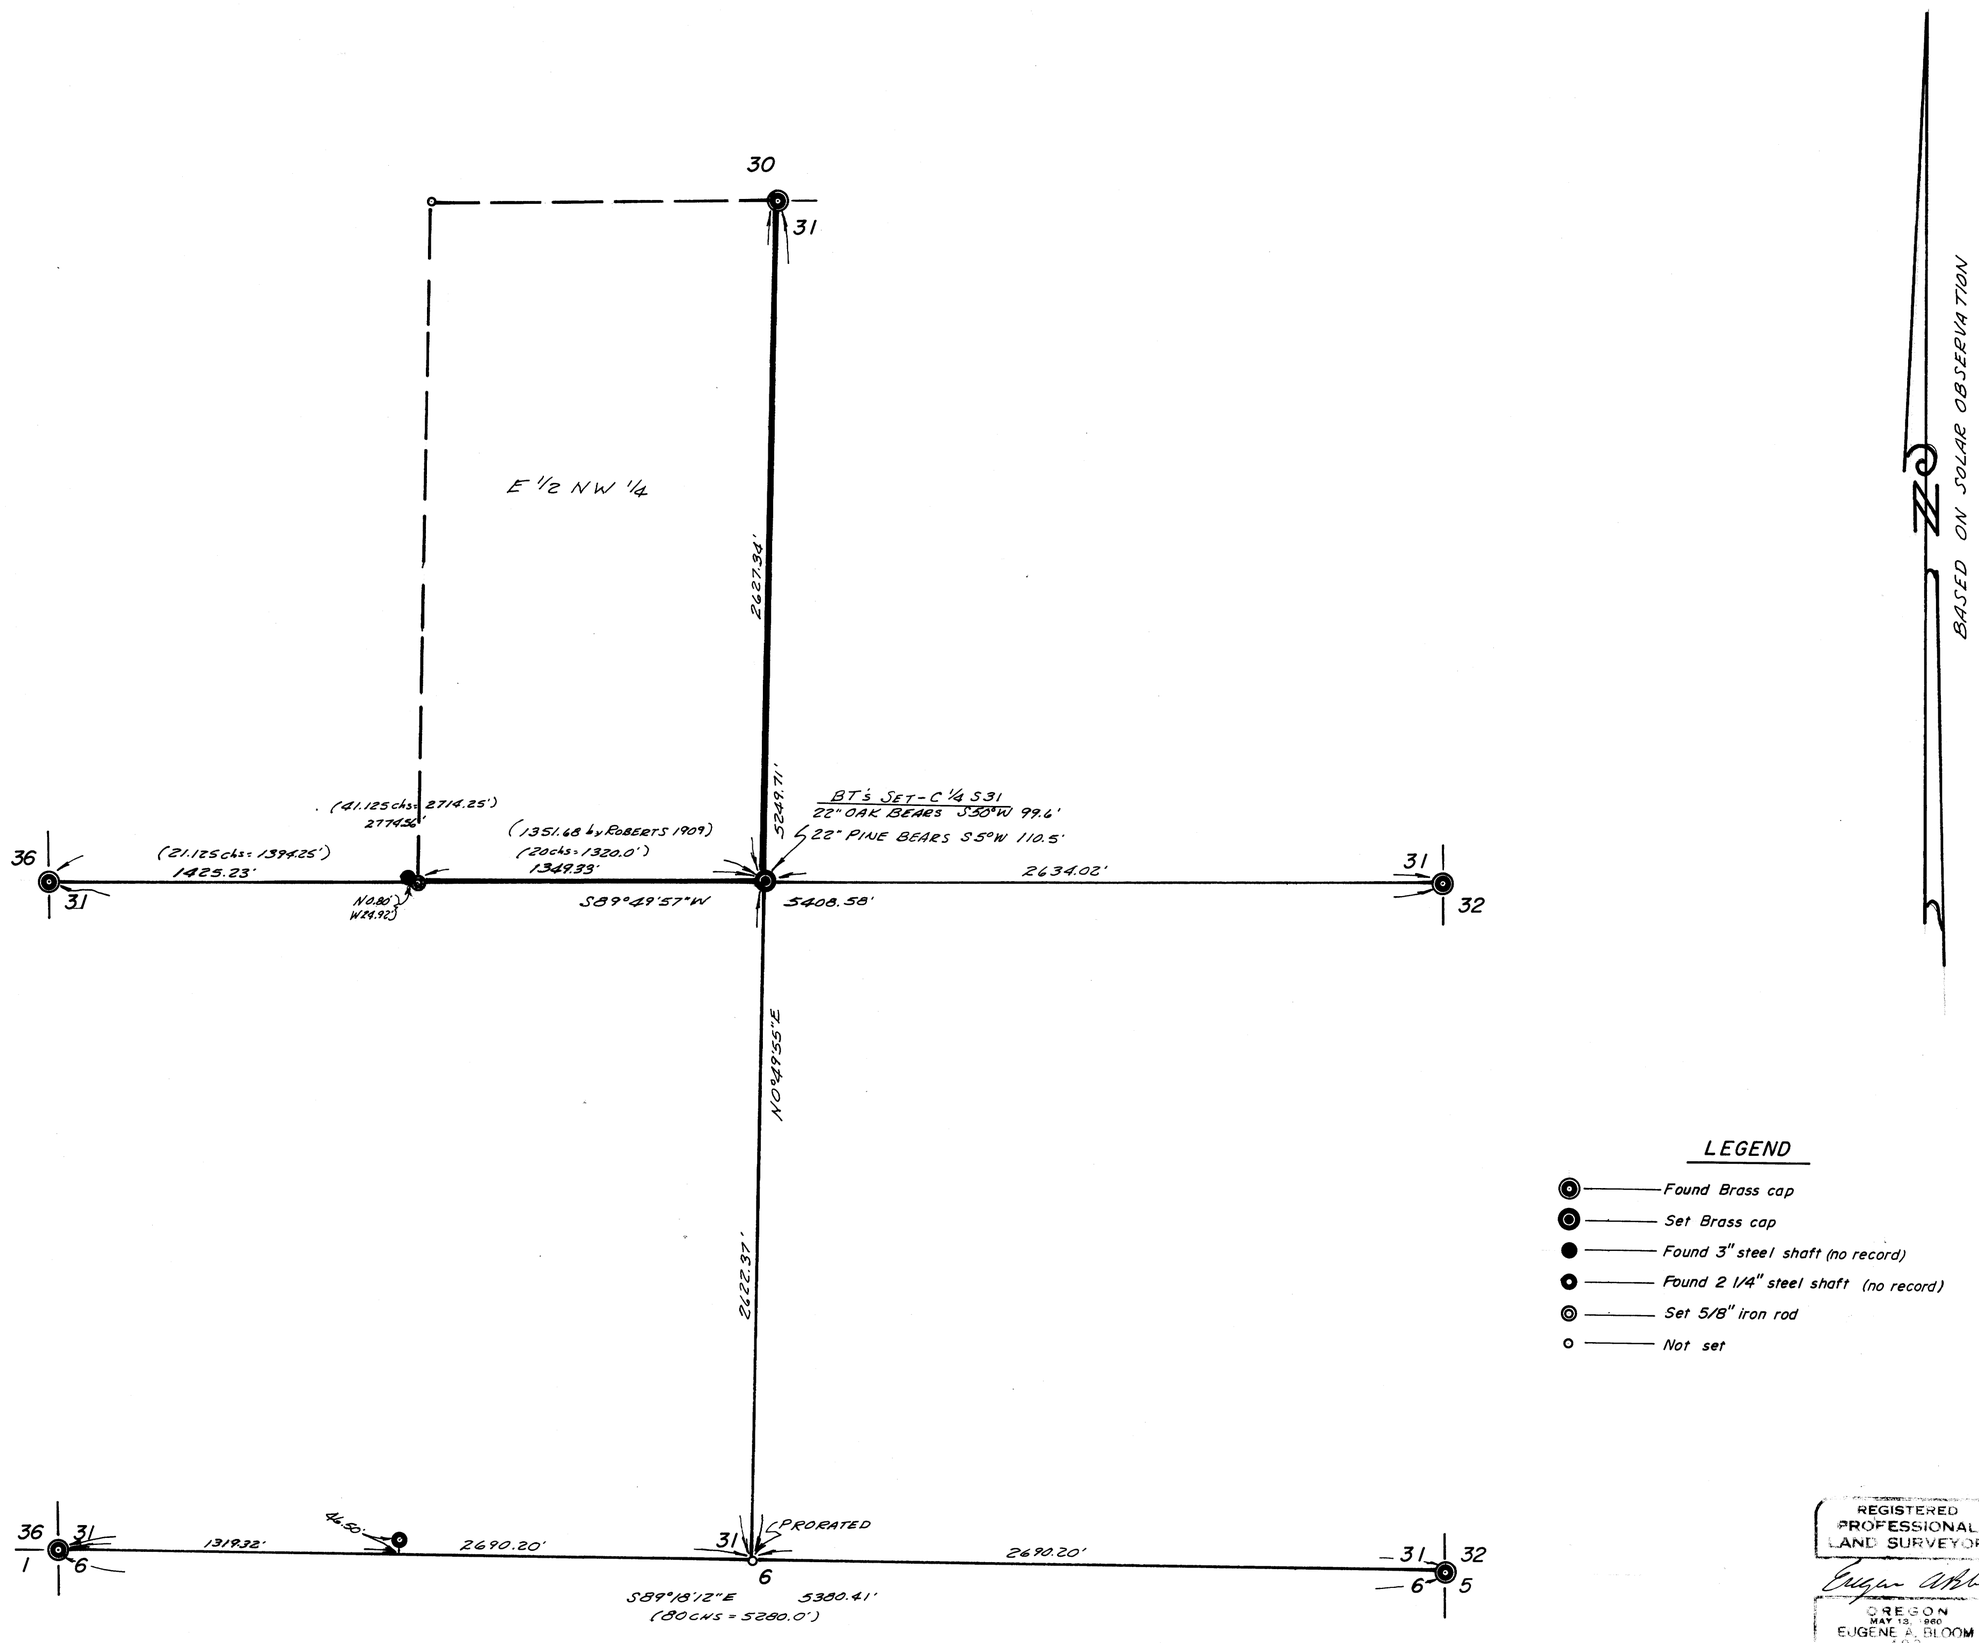


## LEGEND

- Found Brass cap
- Set Brass cap
- Found 3" steel shaft (no record)
- Found 2 1/4" steel shaft (no record)
- Set 5/8" iron rod
- Not set

REGISTERED PROFESSIONAL LAND SURVEYOR
OREGON
MAY 13, 1960
EUGENE A. BLOOM
492

COUNTY SURVEYORS FILE DATA
DO NOT REMOVE FROM OFFICE

MAP FILE M-56 - 15