COUNTY SURVEYORS FILE DATA
DO NOT REMOVE FROM OFFICE

MAP FILE M-56 - 24

SURVEY FOR U.S. FOREST SERVICE
IN SECTION 21, T.32S. R.3W.W.M., DOUGLAS COUNTY, OREGON
BY: BAUGHMAN SURVEYING SERVICE

JULY 1975 SCALE: 1"=400'

FILED
RECEIVED
AUG 5 1975
COUNTY SURVEYOR
DOUGLAS COUNTY, ORE.

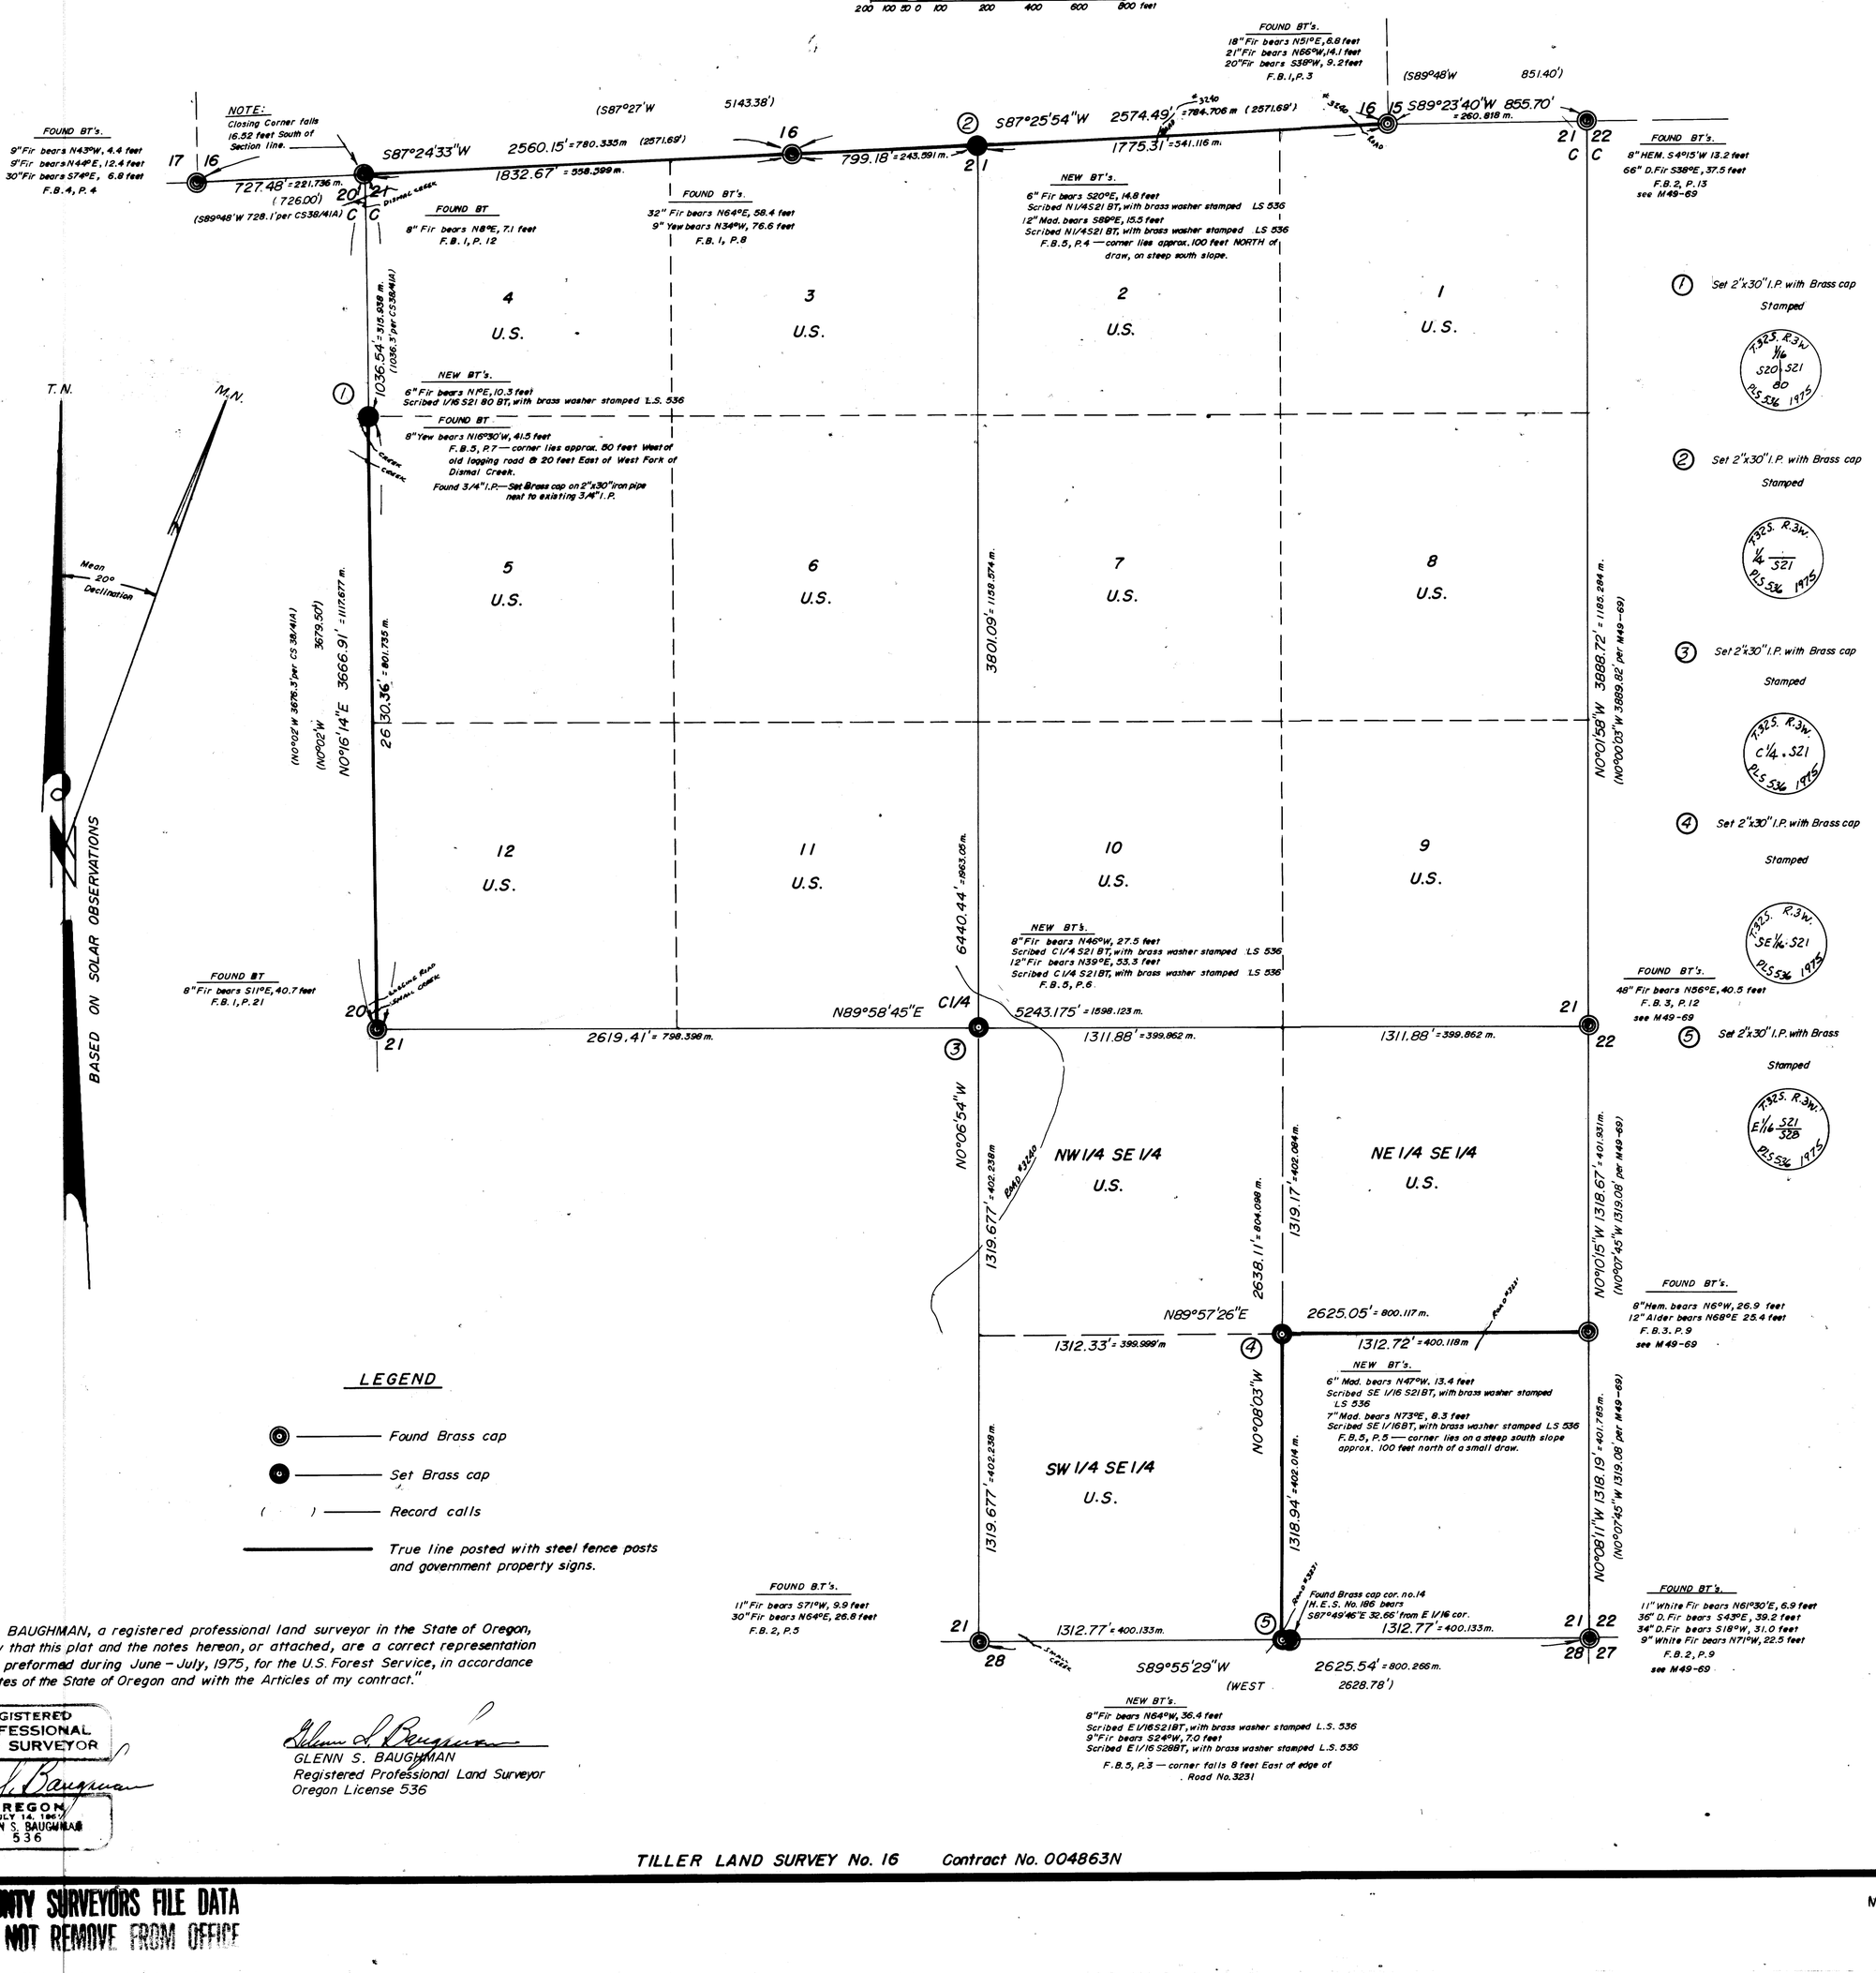

LEGEND

- Found Brass cap
- Set Brass cap
- ( ) Record calls
- True line posted with steel fence posts and government property signs.

"I, GLENN S. BAUGHMAN, a registered professional land surveyor in the State of Oregon, hereby certify that this plat and the notes hereon, or attached, are a correct representation of a survey I preformed during June - July, 1975, for the U.S. Forest Service, in accordance with the statutes of the State of Oregon and with the Articles of my contract."

REGISTERED PROFESSIONAL LAND SURVEYOR
OREGON JULY 14, 1967 GLENN S. BAUGHMAN 536

Glenn S. Baughman
GLENN S. BAUGHMAN
Registered Professional Land Surveyor
Oregon License 536

TILLER LAND SURVEY No. 16 Contract No. 004863N Job No. 35104

COUNTY SURVEYORS FILE DATA
DO NOT REMOVE FROM OFFICE

MAP FILE M-56 - 20