COUNTY SURVEYORS FILE DATA
DO NOT REMOVE FROM OFFICE

Map File M56-3
U.S. File 58/29

SURVEY FOR DOUGLAS COUNTY LUMBER CO.
IN SECTION 7, T.25S. R.3W.W.M., DOUGLAS COUNTY, OREGON
BY: BAUGHMAN SURVEYING SERVICE, ROSEBURG, OREGON

JANUARY 1975 SCALE: 1"=400'

FILED
RECEIVED
JAN 27 1975
COUNTY SURVEYOR
DOUGLAS COUNTY, ORE.

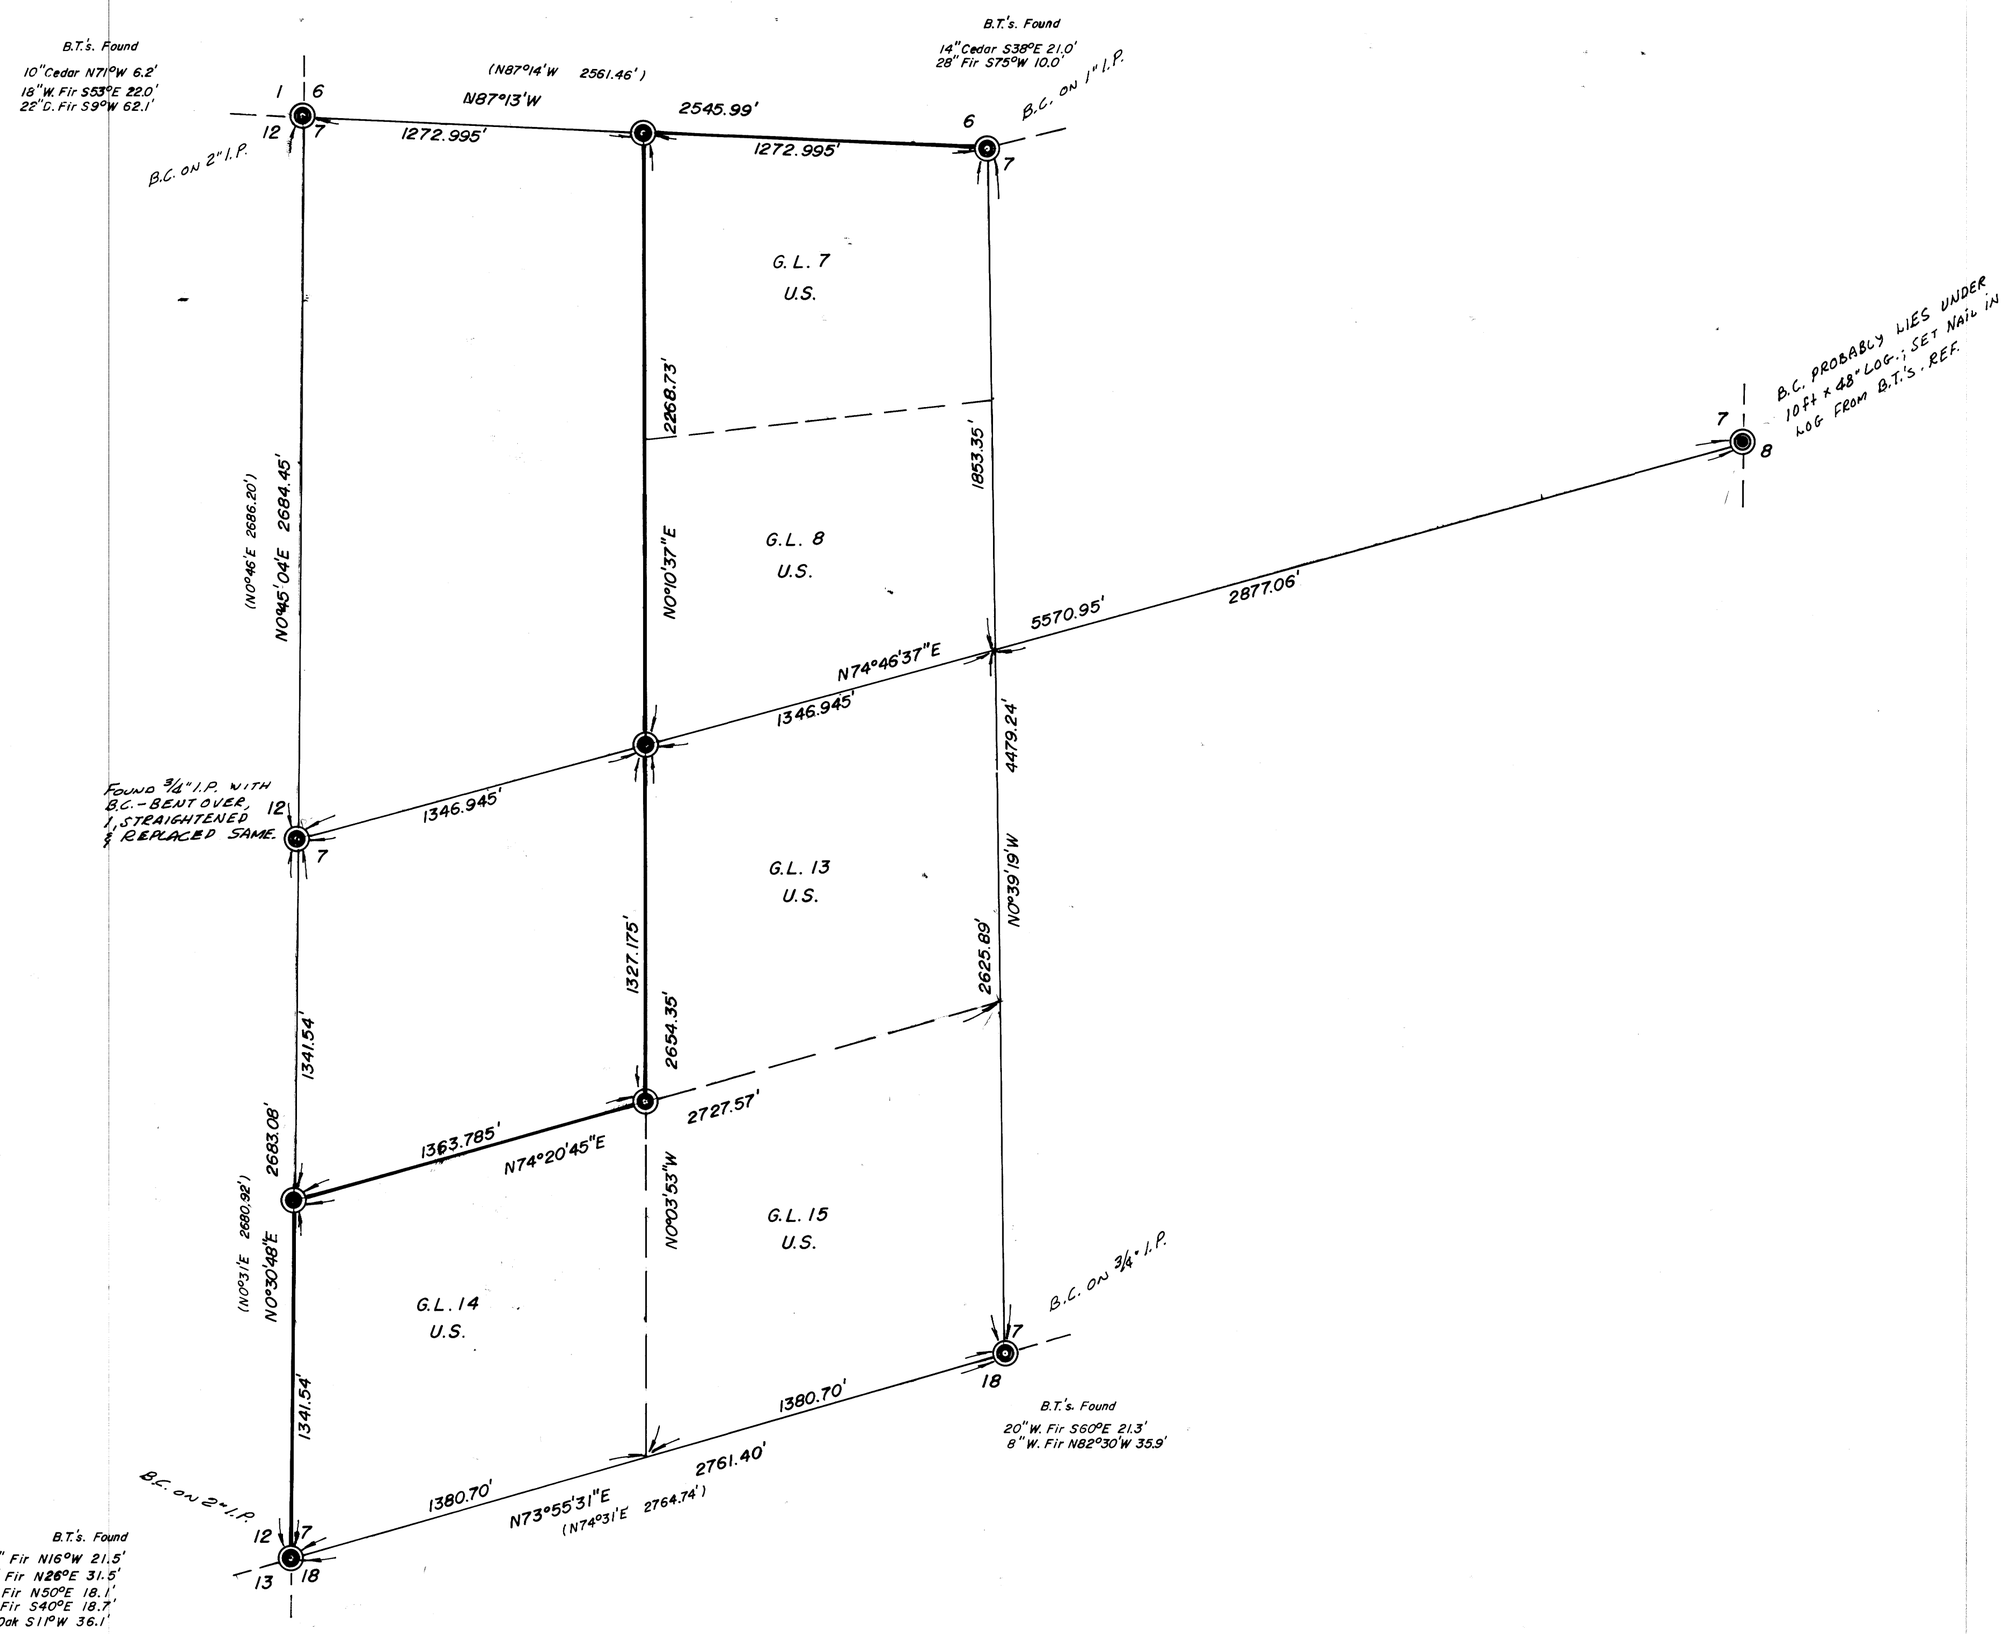

Based on Solar Observation

LEGEND

- Found Brass cap (as noted)
- Set Brass cap on 1"x36" I.P.
- True line posted with steel fence posts
- ( ) Record Calls

REGISTERED PROFESSIONAL LAND SURVEYOR
OREGON
JULY 4, 1966
GLENN S. BAUGHMAN
536

COUNTY SURVEYORS FILE DATA
DO NOT REMOVE FROM OFFICE

U.S. File 58/29
Map File M56-3

M56-3

58/29

SURVEY FOR DOUGLAS COUNTY LUMBER CO.
IN SECTION 7, T.25S. R.3W.W.M., DOUGLAS COUNTY, OREGON
BY: BAUGHMAN SURVEYING SERVICE, ROSEBURG, OREGON

JANUARY 1975 SCALE: 1" = 400'

FILED
RECEIVED
JAN 27 1975
COUNTY SURVEYOR
DOUGLAS COUNTY, ORE.

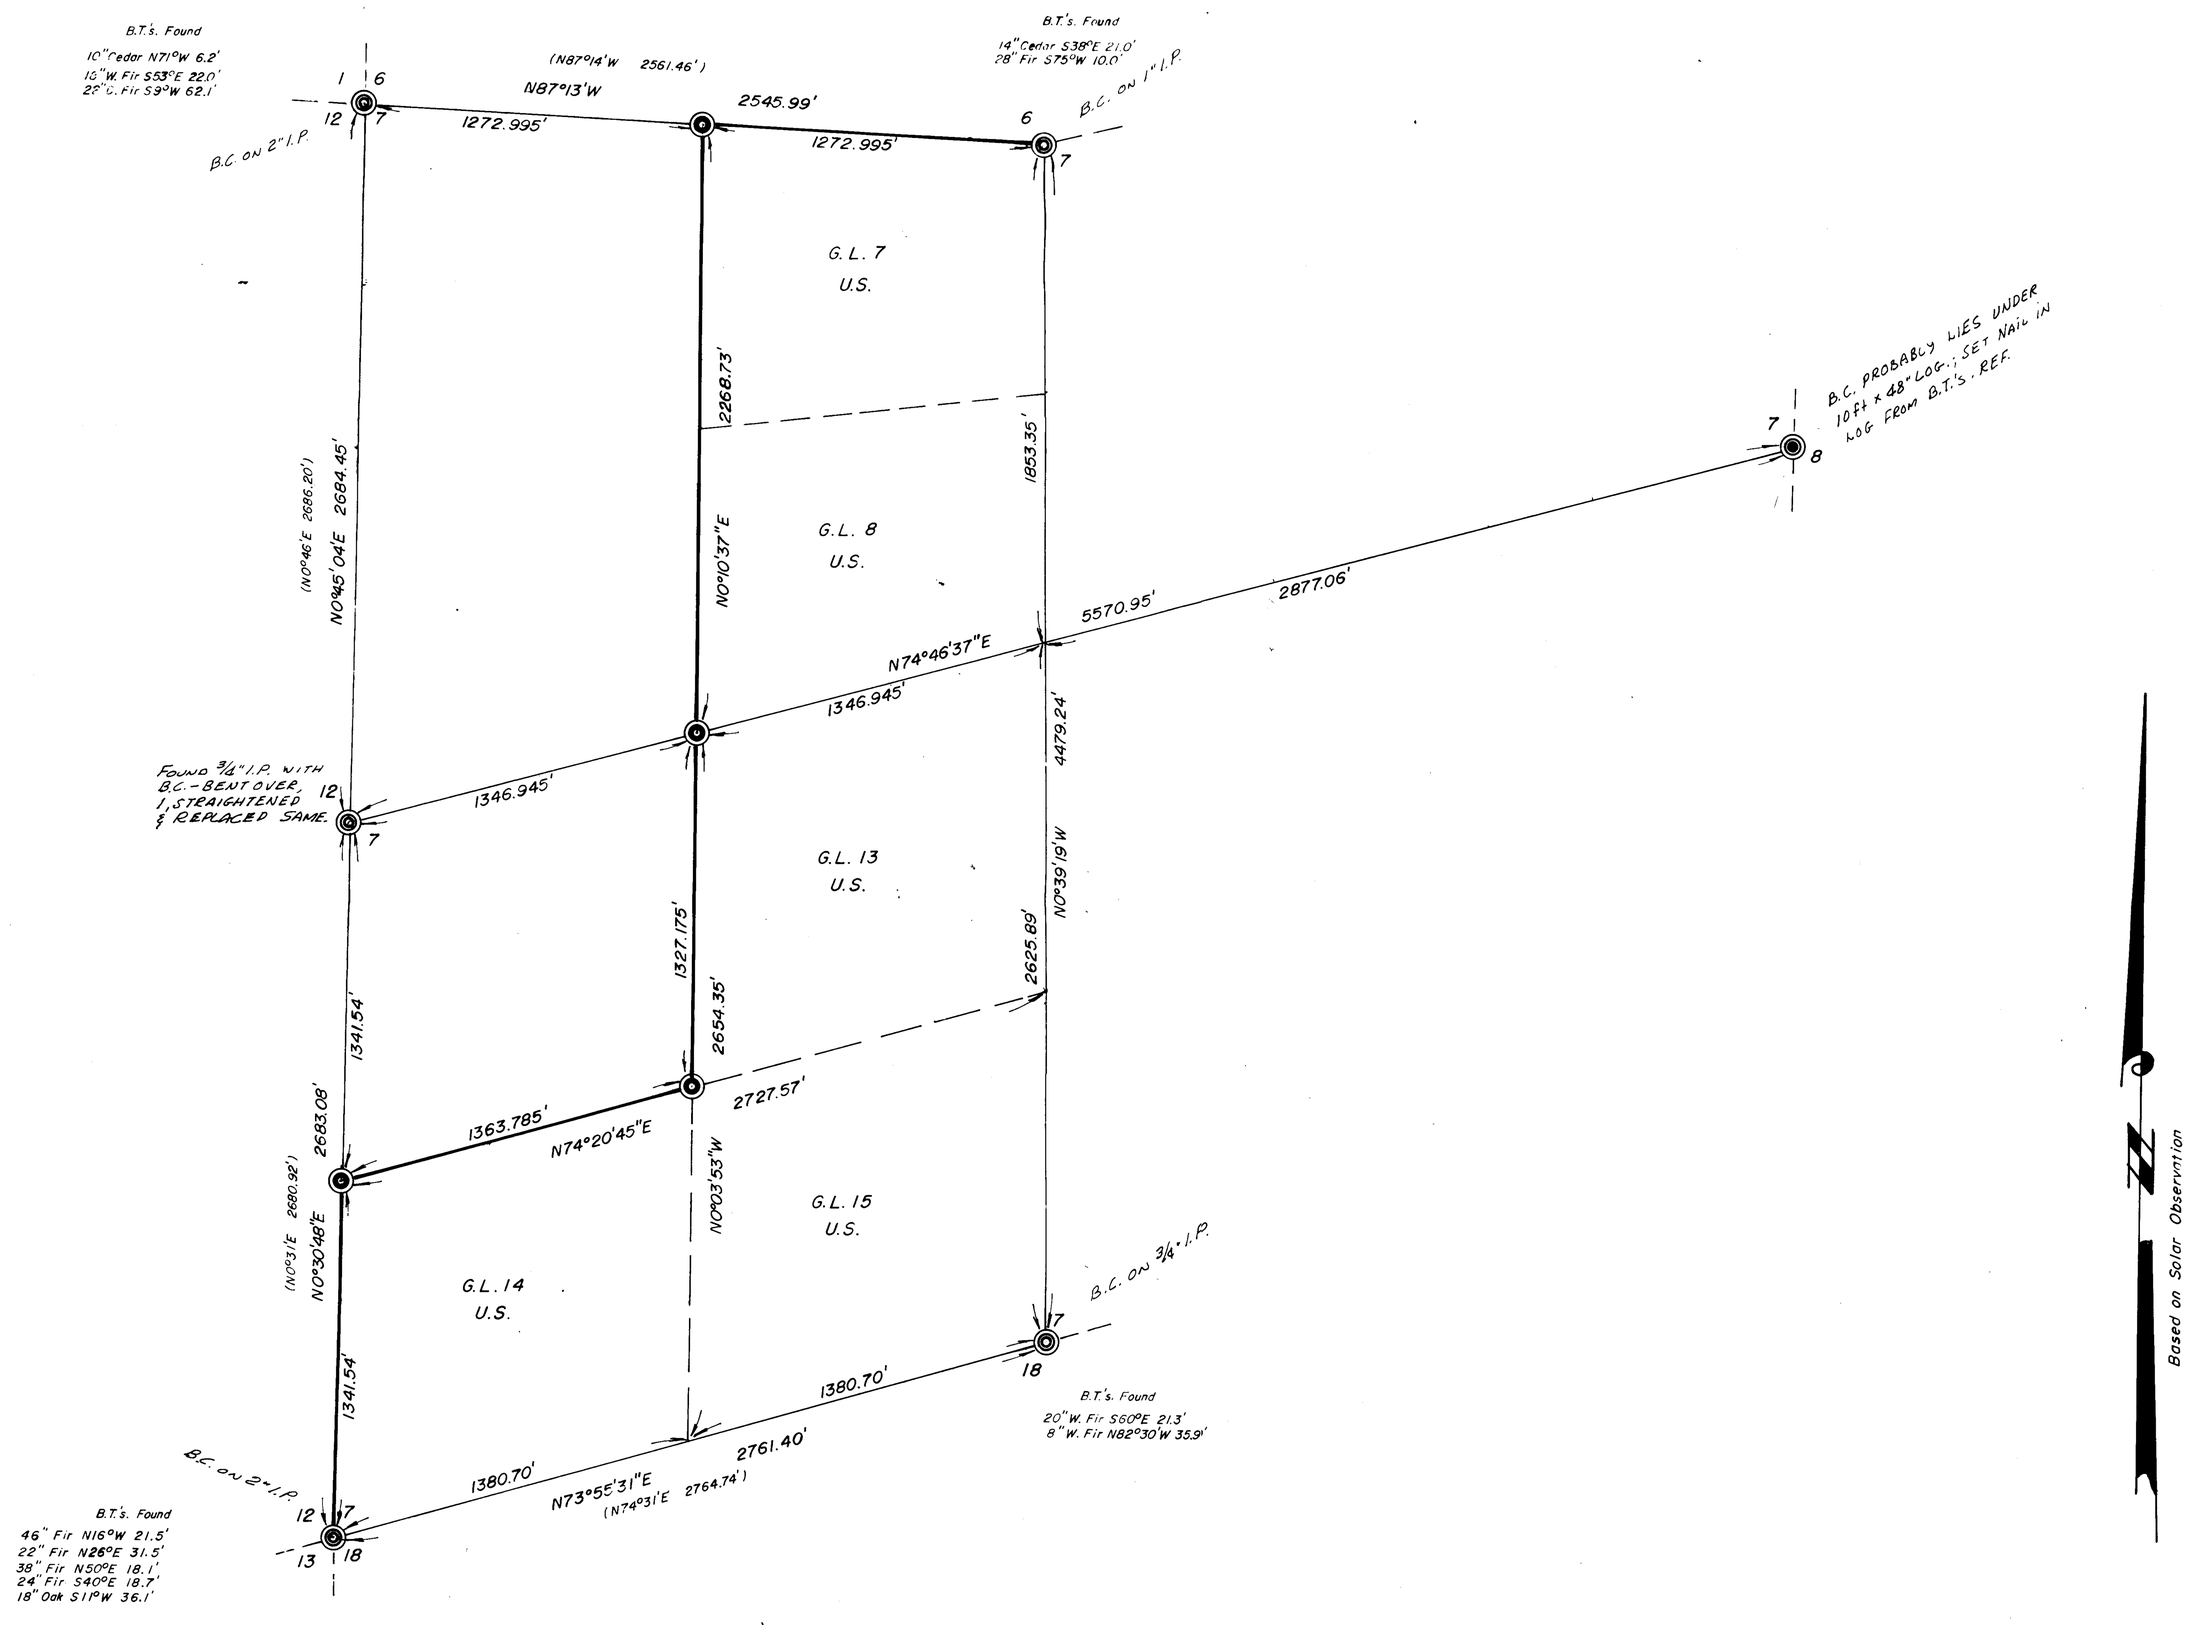

LEGEND

- Found Brass cap (as noted)
- Set Brass cap on 1" x 36" I.P.
- True line posted with steel fence posts
- ( ) Record Calls

Glenn L. Baughman

58 29

M56-3