COUNTY SURVEYORS FILE DATA
DO NOT REMOVE FROM OFFICE

MAP FILE MS6-35

SURVEY IN SECTIONS 18 & 20, T.25S. R.2W.W.M.

FOR: WEYERHAEUSER COMPANY

BY: BAUGHMAN SURVEYING SERVICE

JANUARY 1976 SCALE: 1" = 500'

FILED
RECEIVED
MAR 10 1976
COUNTY SURVEYOR
DOUGLAS COUNTY, ORE.

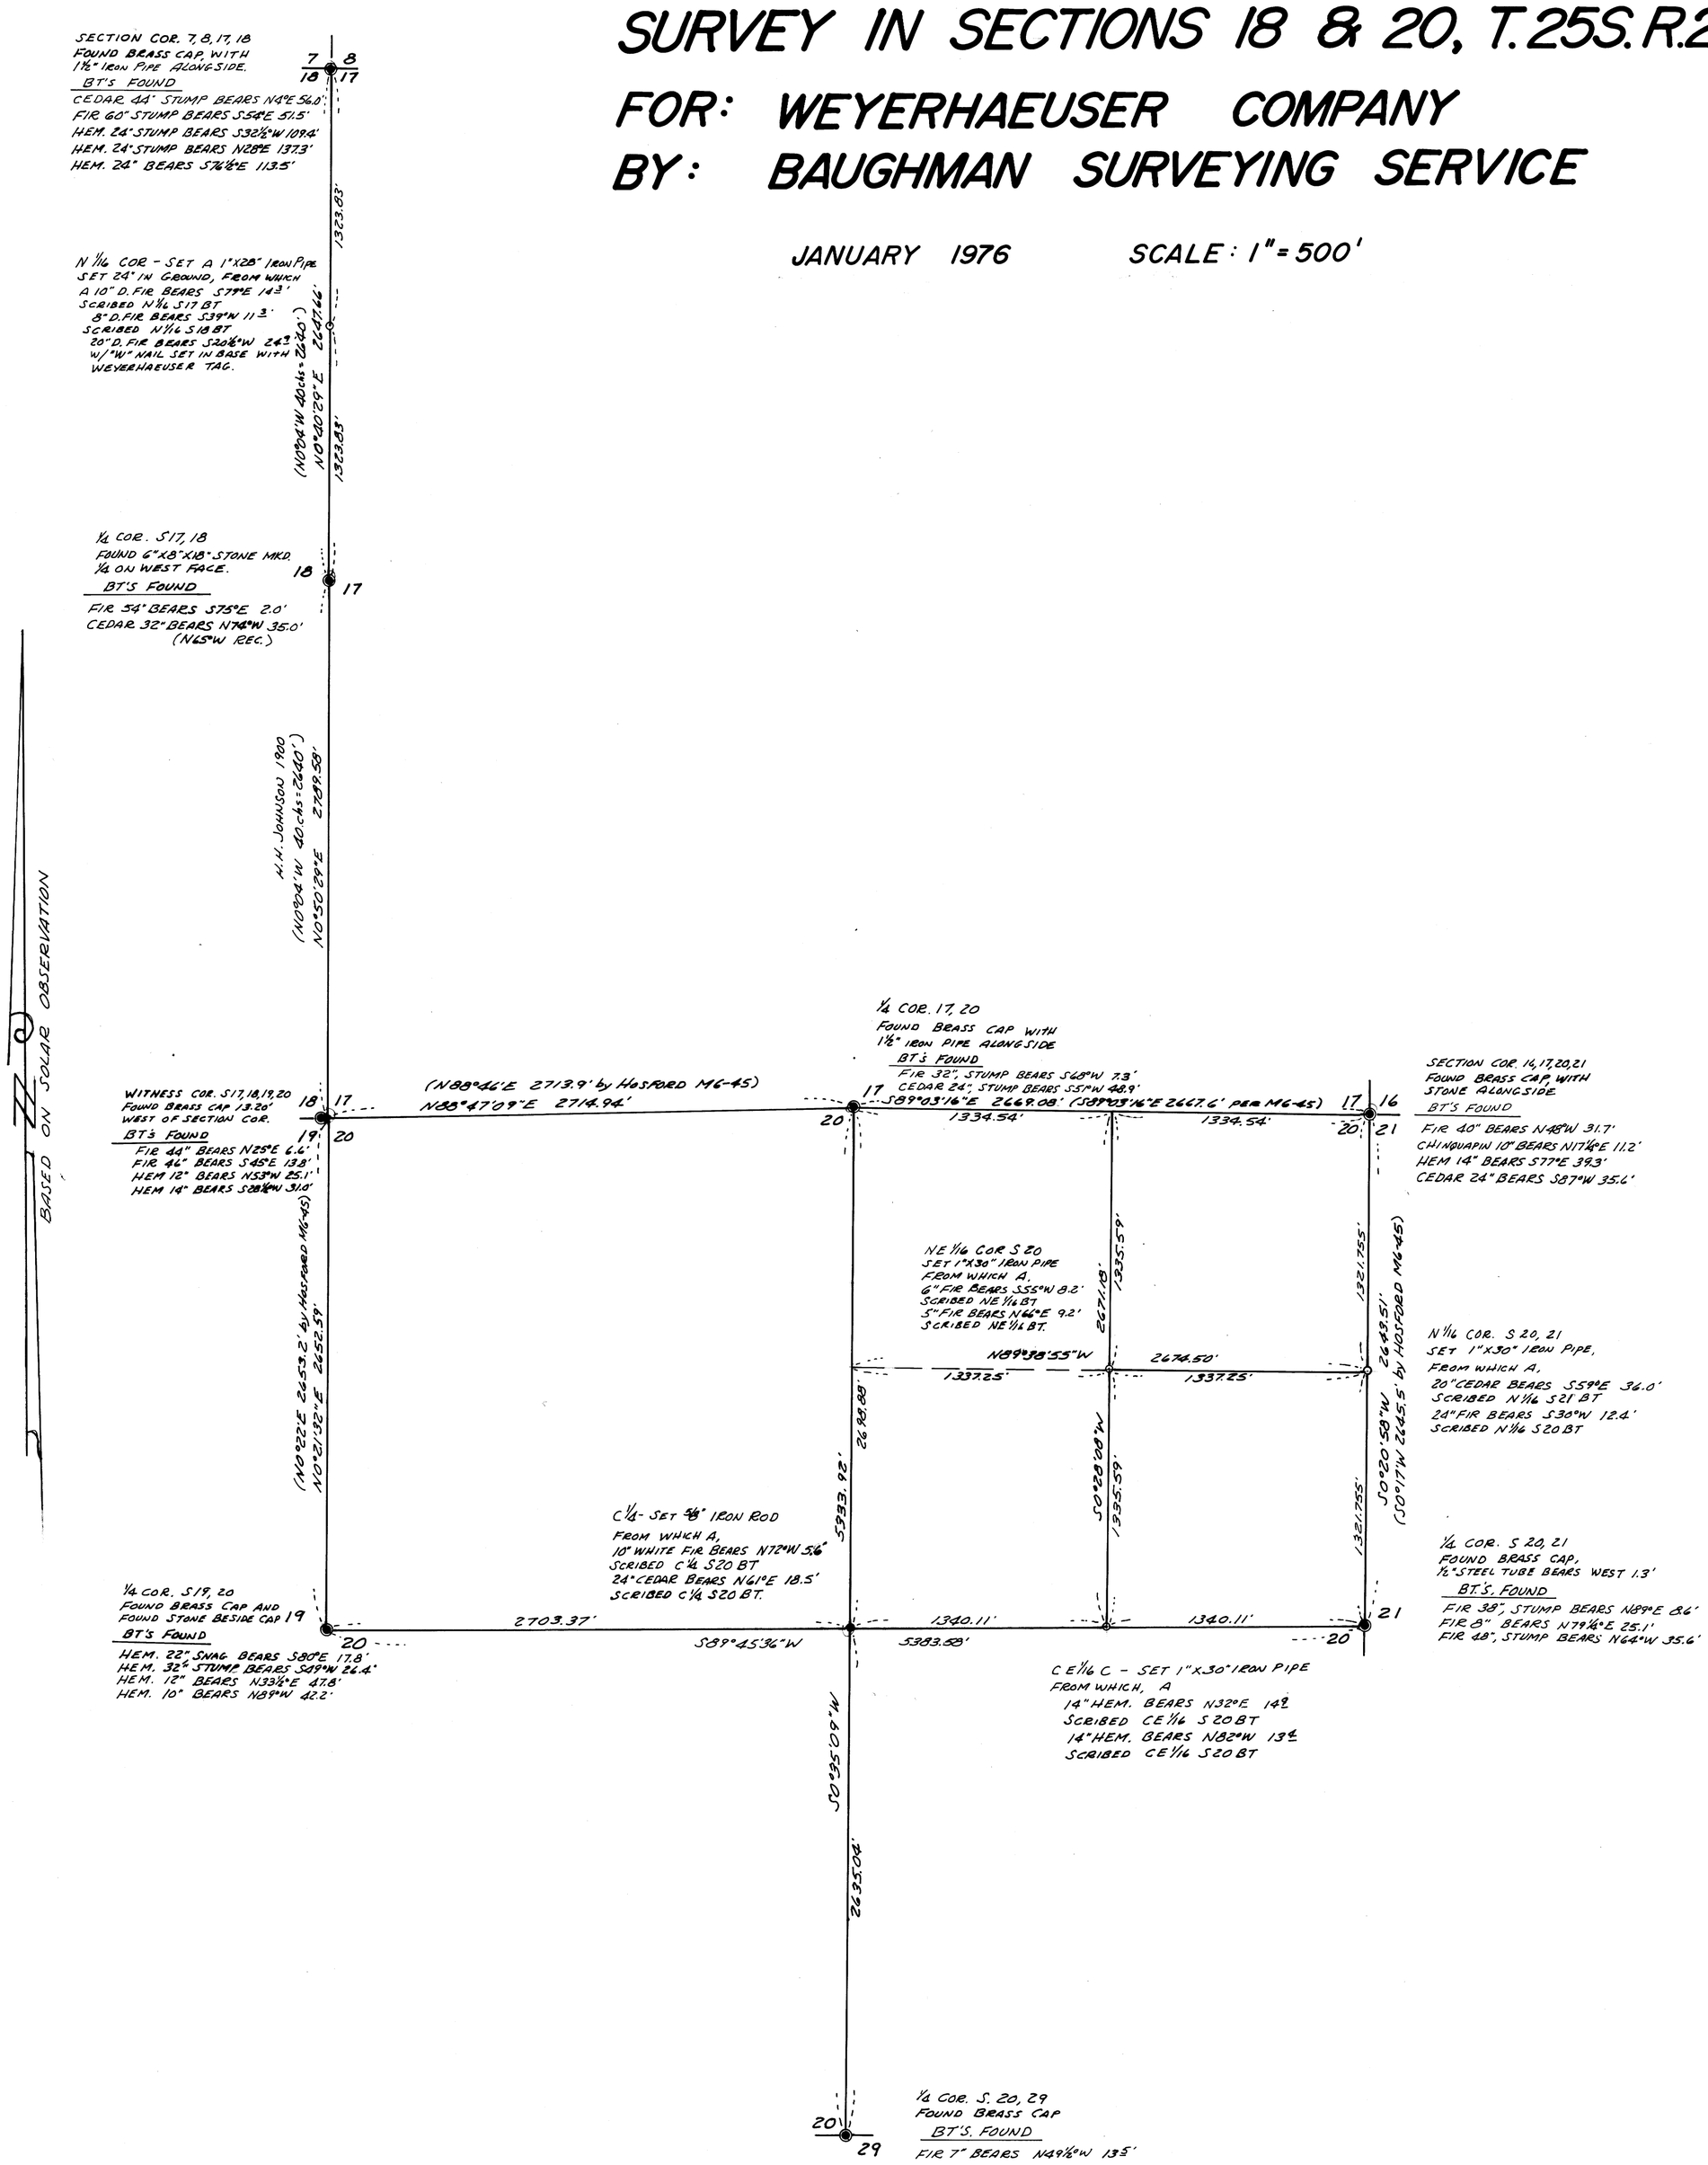

REGISTERED
PROFESSIONAL
LAND SURVEYOR
Glenn S. Baughman
OREGON
JULY 14, 1967
GLENN S. BAUGHMAN
2314

35226

COUNTY SURVEYORS FILE DATA
DO NOT REMOVE FROM OFFICE

MAP FILE MS6-35