MAP FILE M-56-4

COUNTY SURVEYORS FILE DATA
DO NOT REMOVE FROM OFFICE

FILED
RECEIVED
JAN 28 1975
COUNTY SURVEYOR
DOUGLAS COUNTY, ORE.

Survey in Sections 29, 30, 31, & 32, T26S, R5W, Sections 5 & 6, T27S, R5W, Section 1, T27S, R6W, & Section 36, T26S, R6W, W.M.

Surveyed for Francis Engle
Surveyed by BHW Eng. & Surveying Inc.
January 1975 Scale 1" = 400'

∘ — Set 3/4" Iron Pipe (unless otherwise designated)
• — Fd. Monument

For Basis of Bearing See RM 1-42 (also for Record bearings & distances)

N

REGISTERED PROFESSIONAL LAND SURVEYOR
Romanso E. Ware
OREGON NOV. 14, 1972 ROMANSO E. WARE 1005

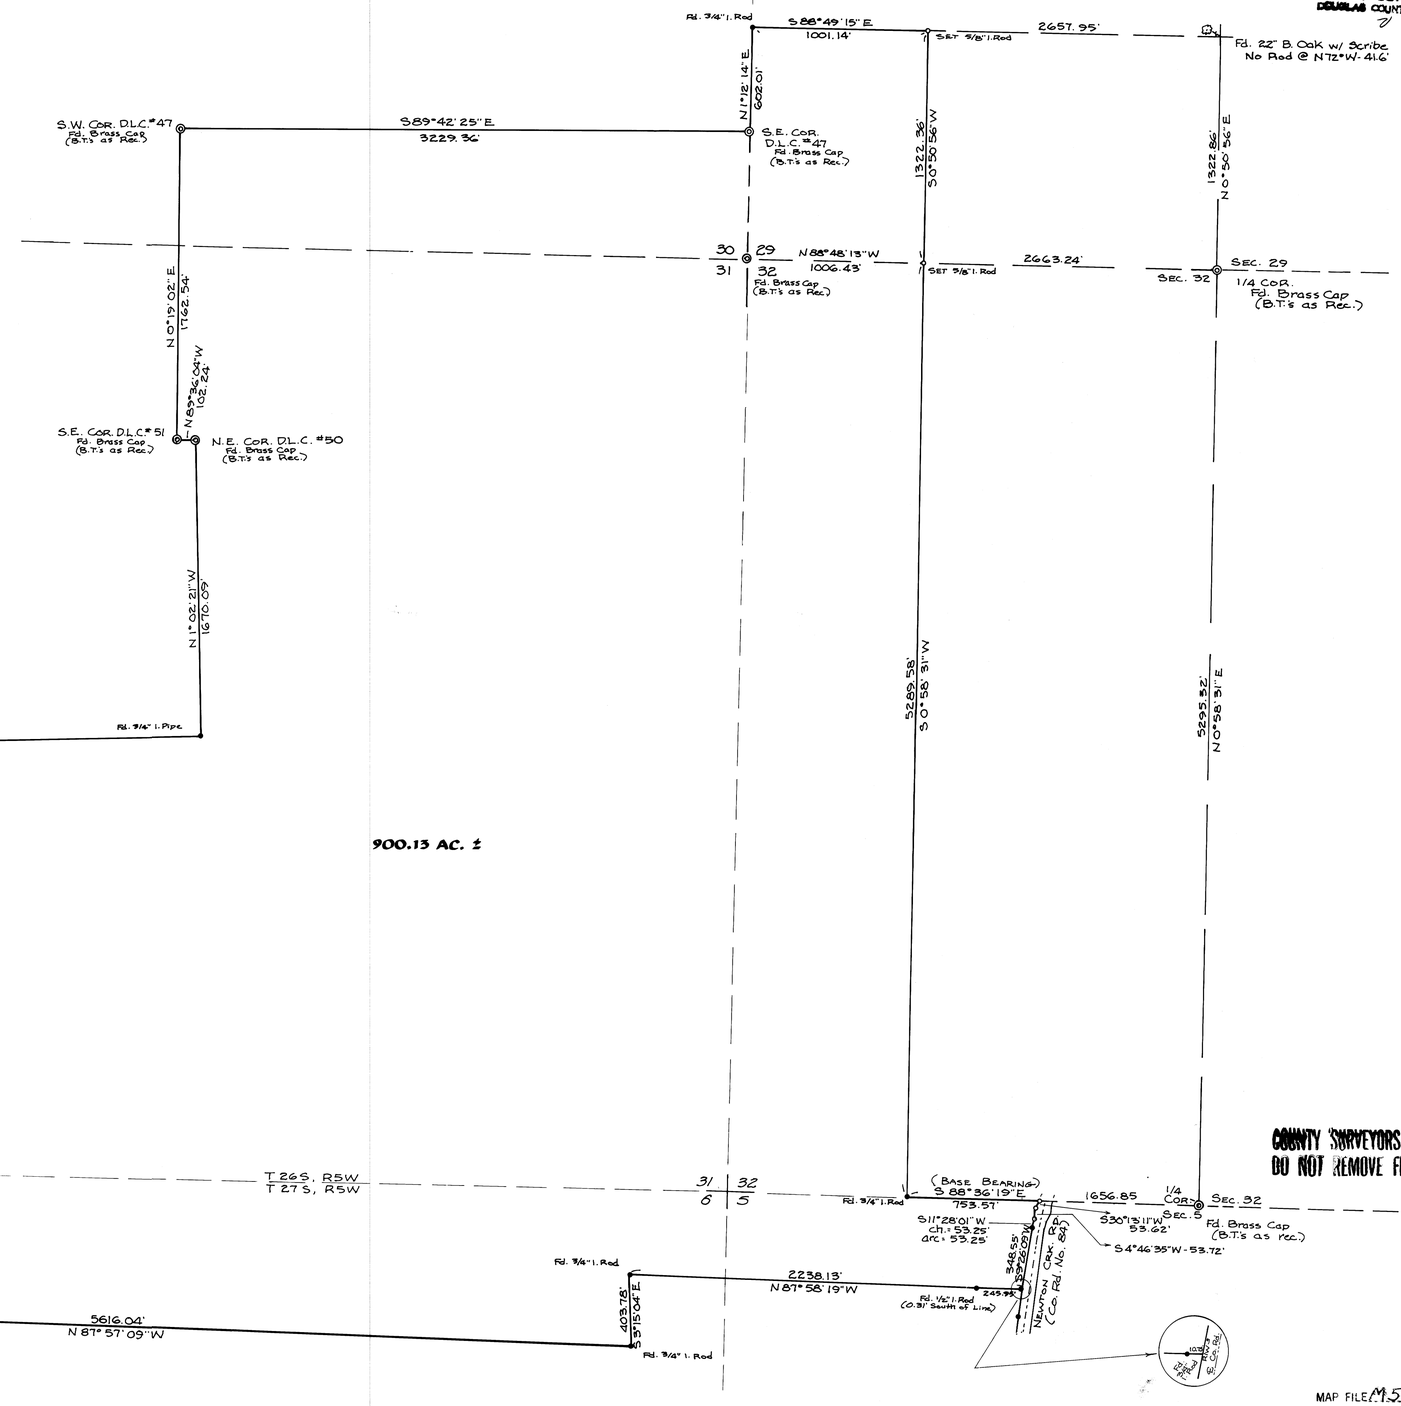

COUNTY SURVEYORS FILE DATA
DO NOT REMOVE FROM OFFICE

MAP FILE M-56-4