COUNTY SURVEYORS FILE DATA
DO NOT REMOVE FROM OFFICE

SURVEY IN SECTION 31, T28S, R5W, W.M.

SURVEY FOR ARTHUR L. KLASSEN
SURVEY BY BHW ENG. & SURVEYING, INC.
APRIL, 1976 SCALE: 1" = 300'

REGISTERED PROFESSIONAL LAND SURVEYOR
Romanso E. Ware
OREGON NOV 16, 1973 ROMANSO E. WARE 1005

FILED
RECEIVED MMC
MAY 3 1976
COUNTY SURVEYOR
DOUGLAS COUNTY, OREGON

○ —— DENOTES SET 3/4" I. PIPE
● —— DENOTES FD. MONUMENT
◉ —— DENOTES FD. BRASS CAP

BEARINGS BASED ON CLARKS BRANCH COUNTY RD. #105

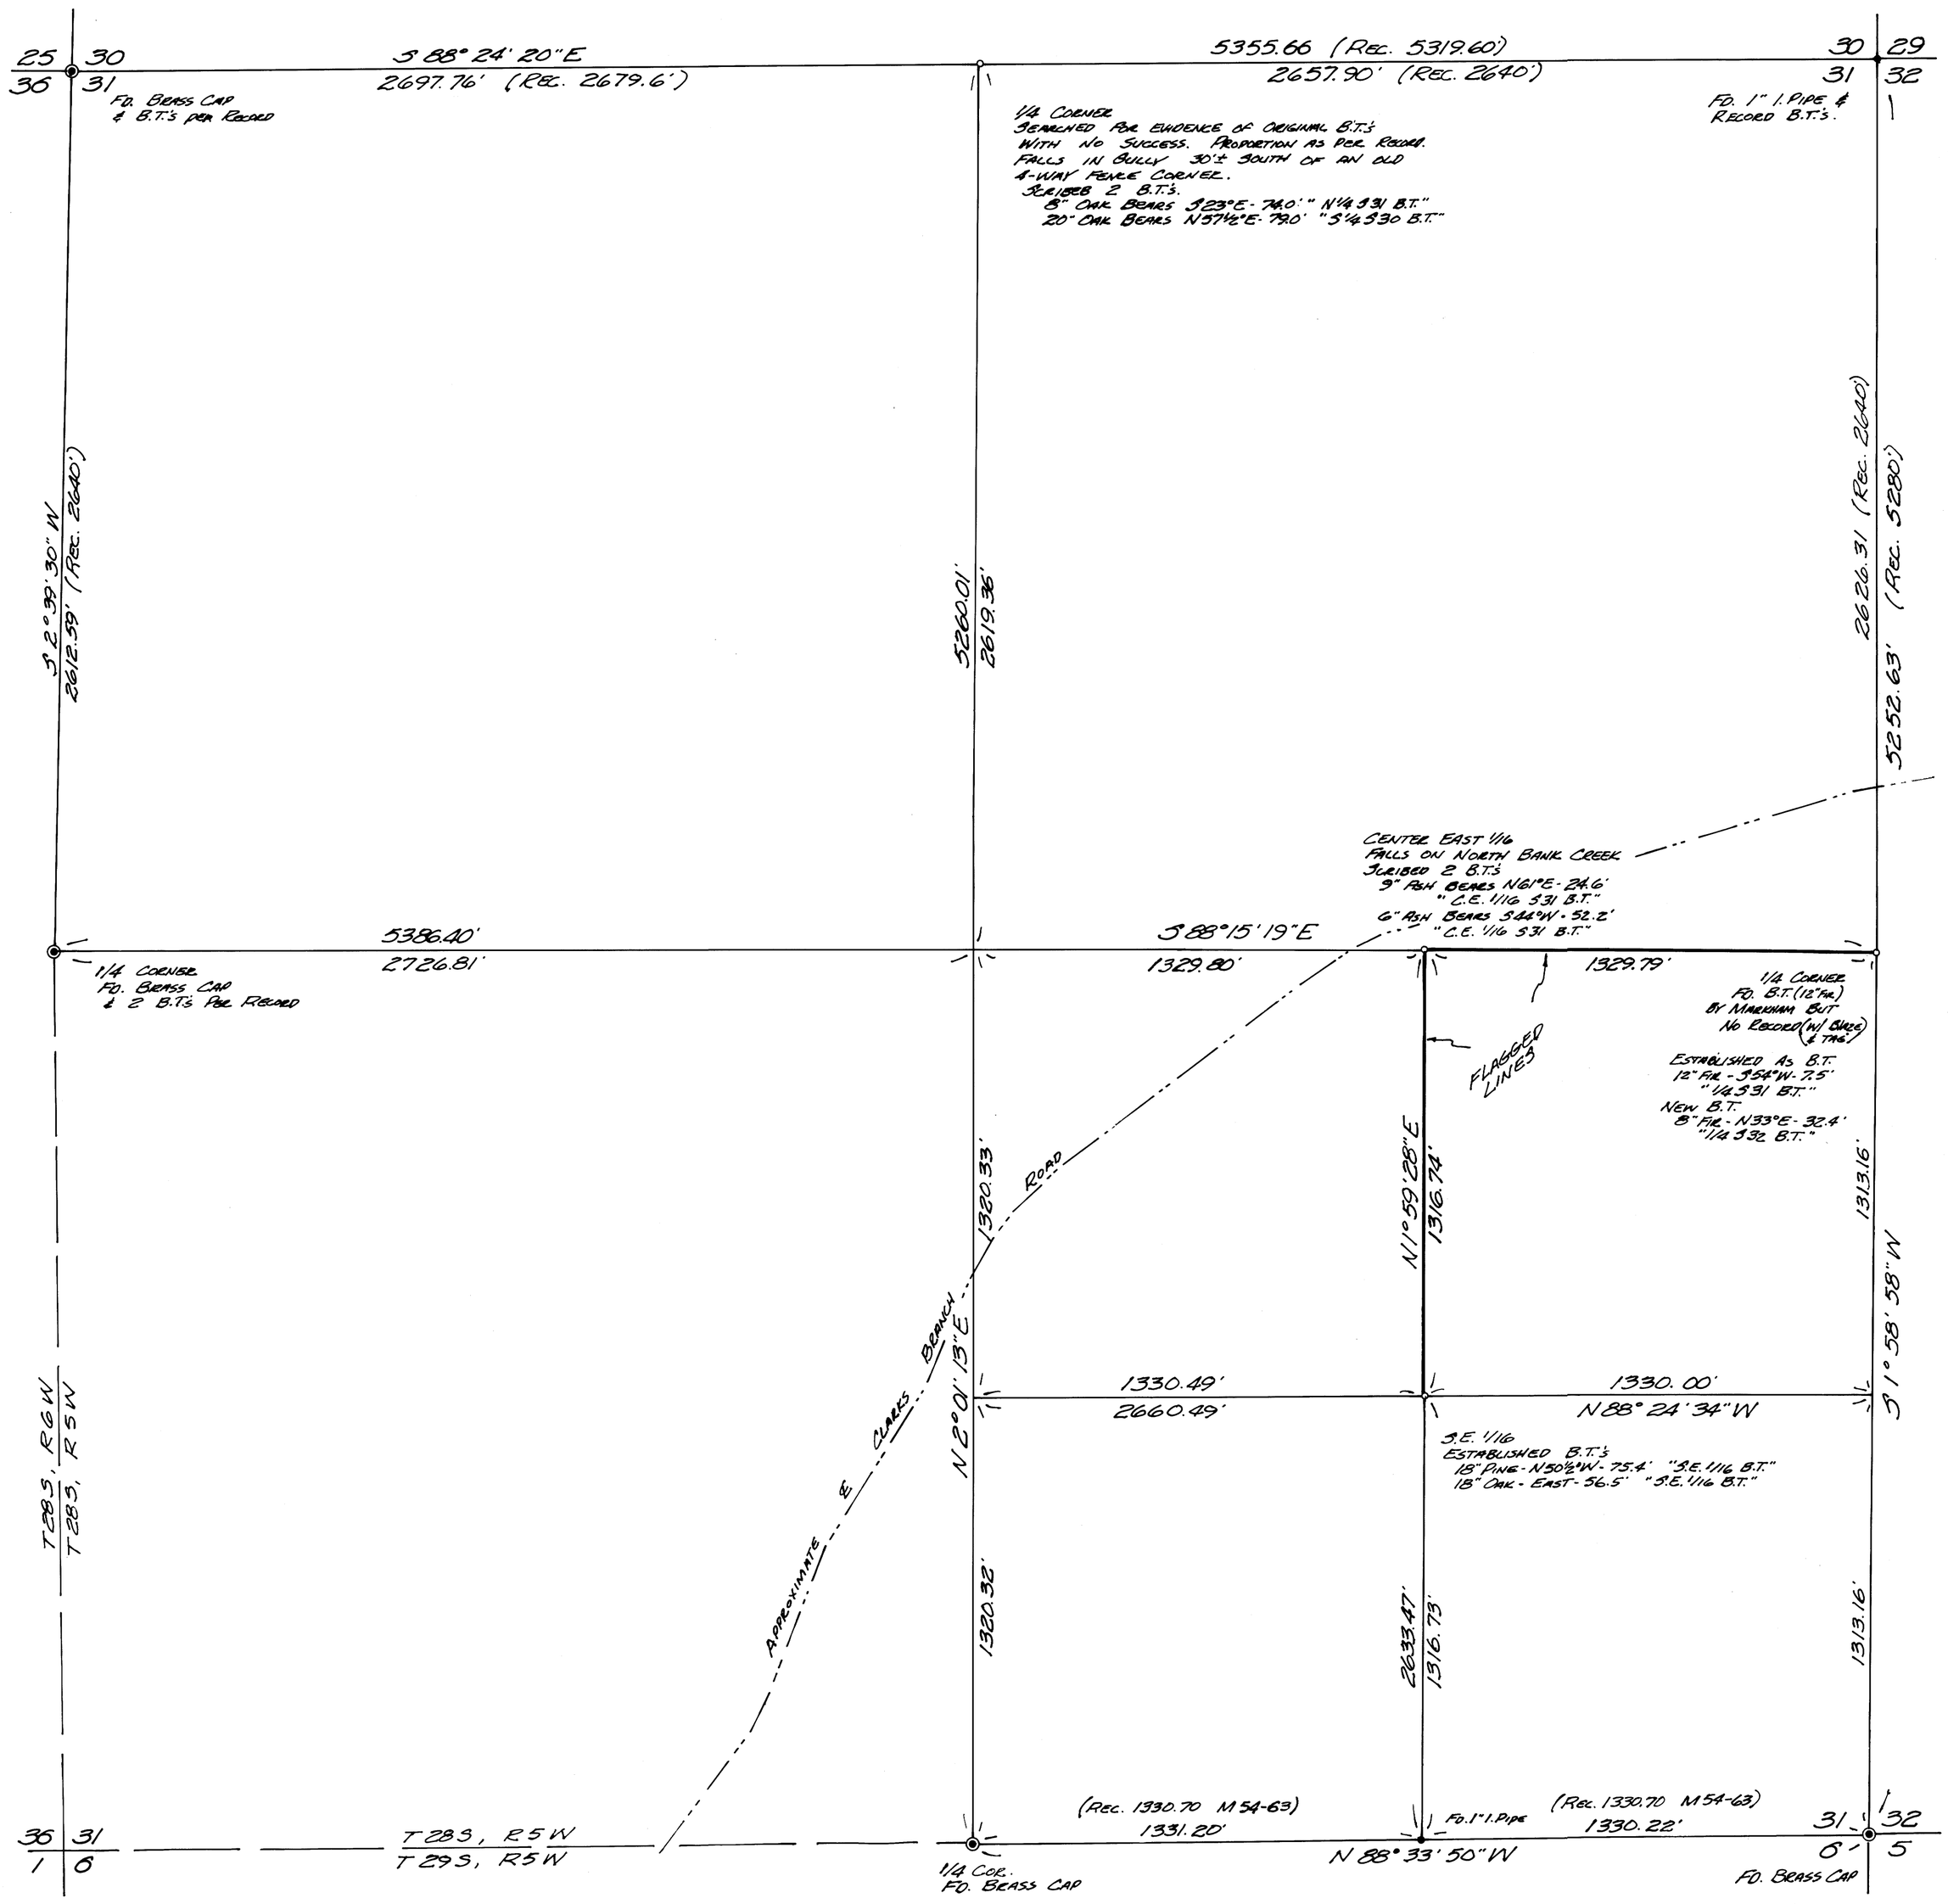

MAP FILE 56 - 41